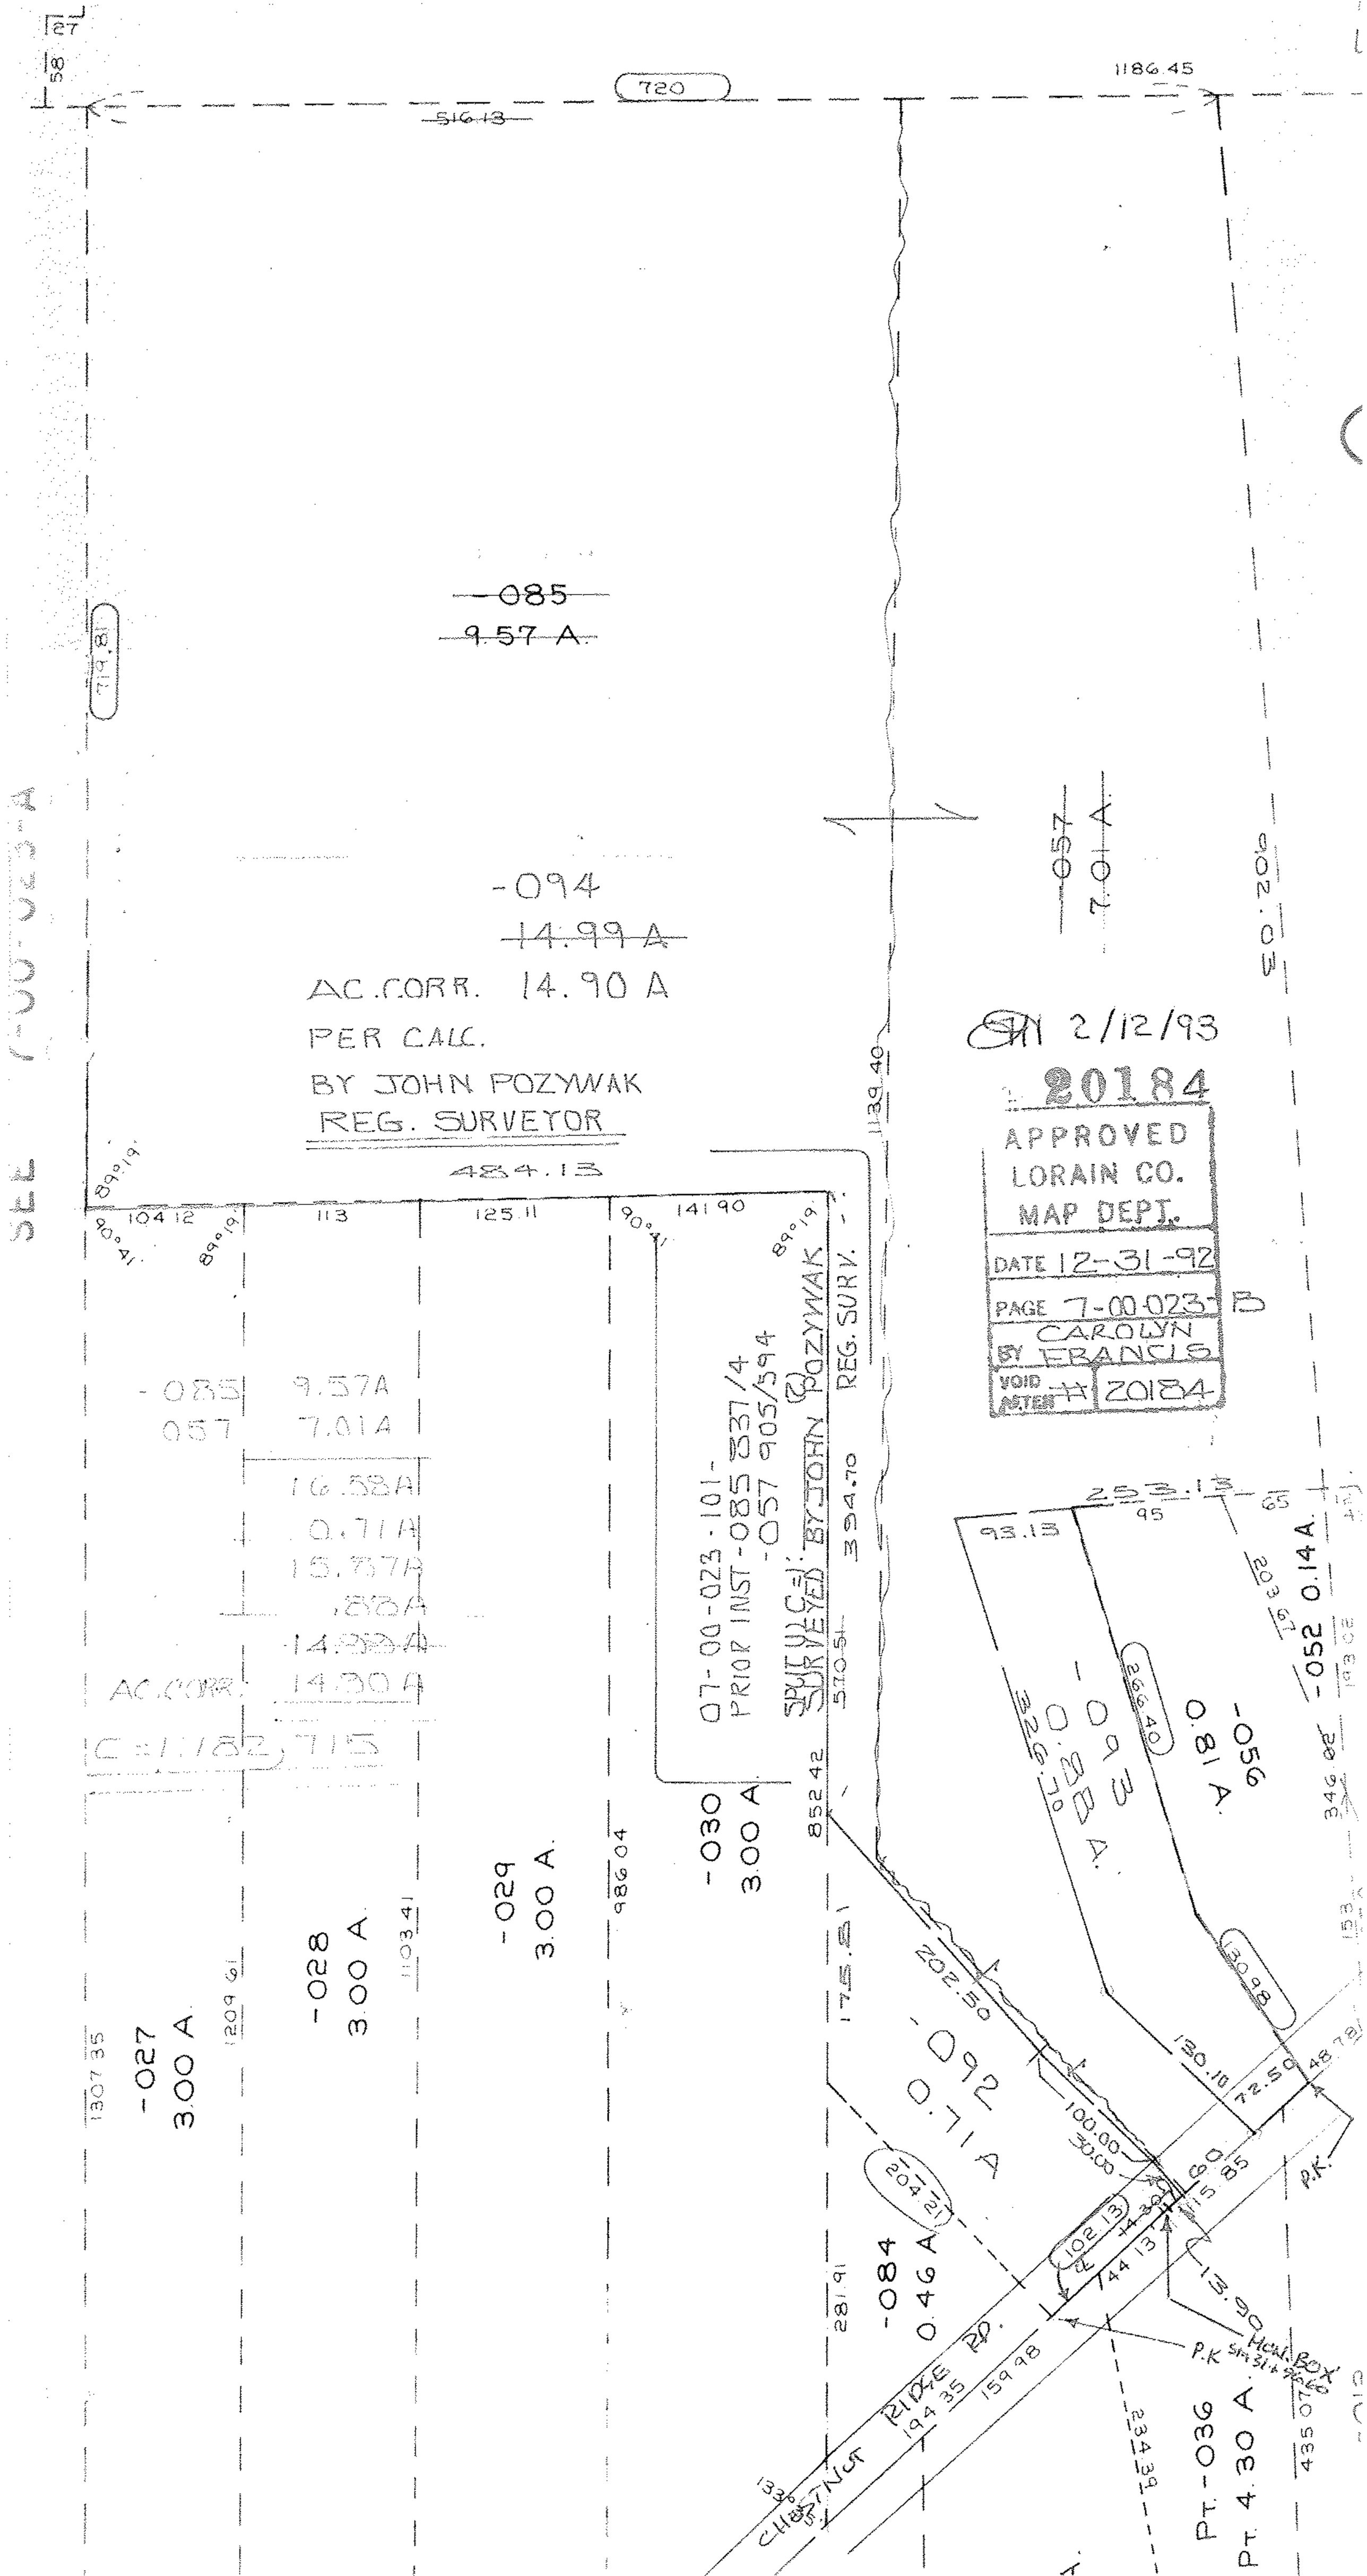

720
1186.45
516.13
-085
9.57 A.
719.81
-094
14.99 A
AC.CORR. 14.90 A
PER CALC.
BY JOHN POZYWAK
REG. SURVEYOR
484.13
-057
7.01 A.
1139.40
SEE 7-00-023-A
2/12/93
20184
APPROVED
LORAIN CO.
MAP DEPT.
DATE 12-31-92
PAGE 7-00-023-B
BY CAROLYN FRANCIS
VOID AFTER # 20184
104.12
113
125.11
141.90
-085 9.57A
057 7.01A
16.58A
0.71A
15.87A
.88A
14.99A
AC.CORR. 14.90 A
C=1,182,715
07-00-023-101-
PRIOR INST-085 837/4
-057 905/594
SPLIT U.C.=1
SURVEYED BY JOHN POZYWAK REG. SURV.
394.70
570.51
852.42
-030
3.00 A
-029
3.00 A.
986.04
-028
3.00 A
1103.41
-027
3.00 A
1209.61
1307.35
253.13
93.13
95
65
-052 0.14 A.
-093
0.88 A.
326.70
266.40
-056
0.81 A.
346.02
202.50
-092
0.71 A
100.00
30.00
130.10
72.50
48.78
204.21
-084
0.46 A
281.91
102.13
144.13
13.90
P.K.
MON. BOX
CHESTNUT RIDGE RD.
194.35
159.98
234.39
Pt.-036
Pt. 4.30 A
435.07