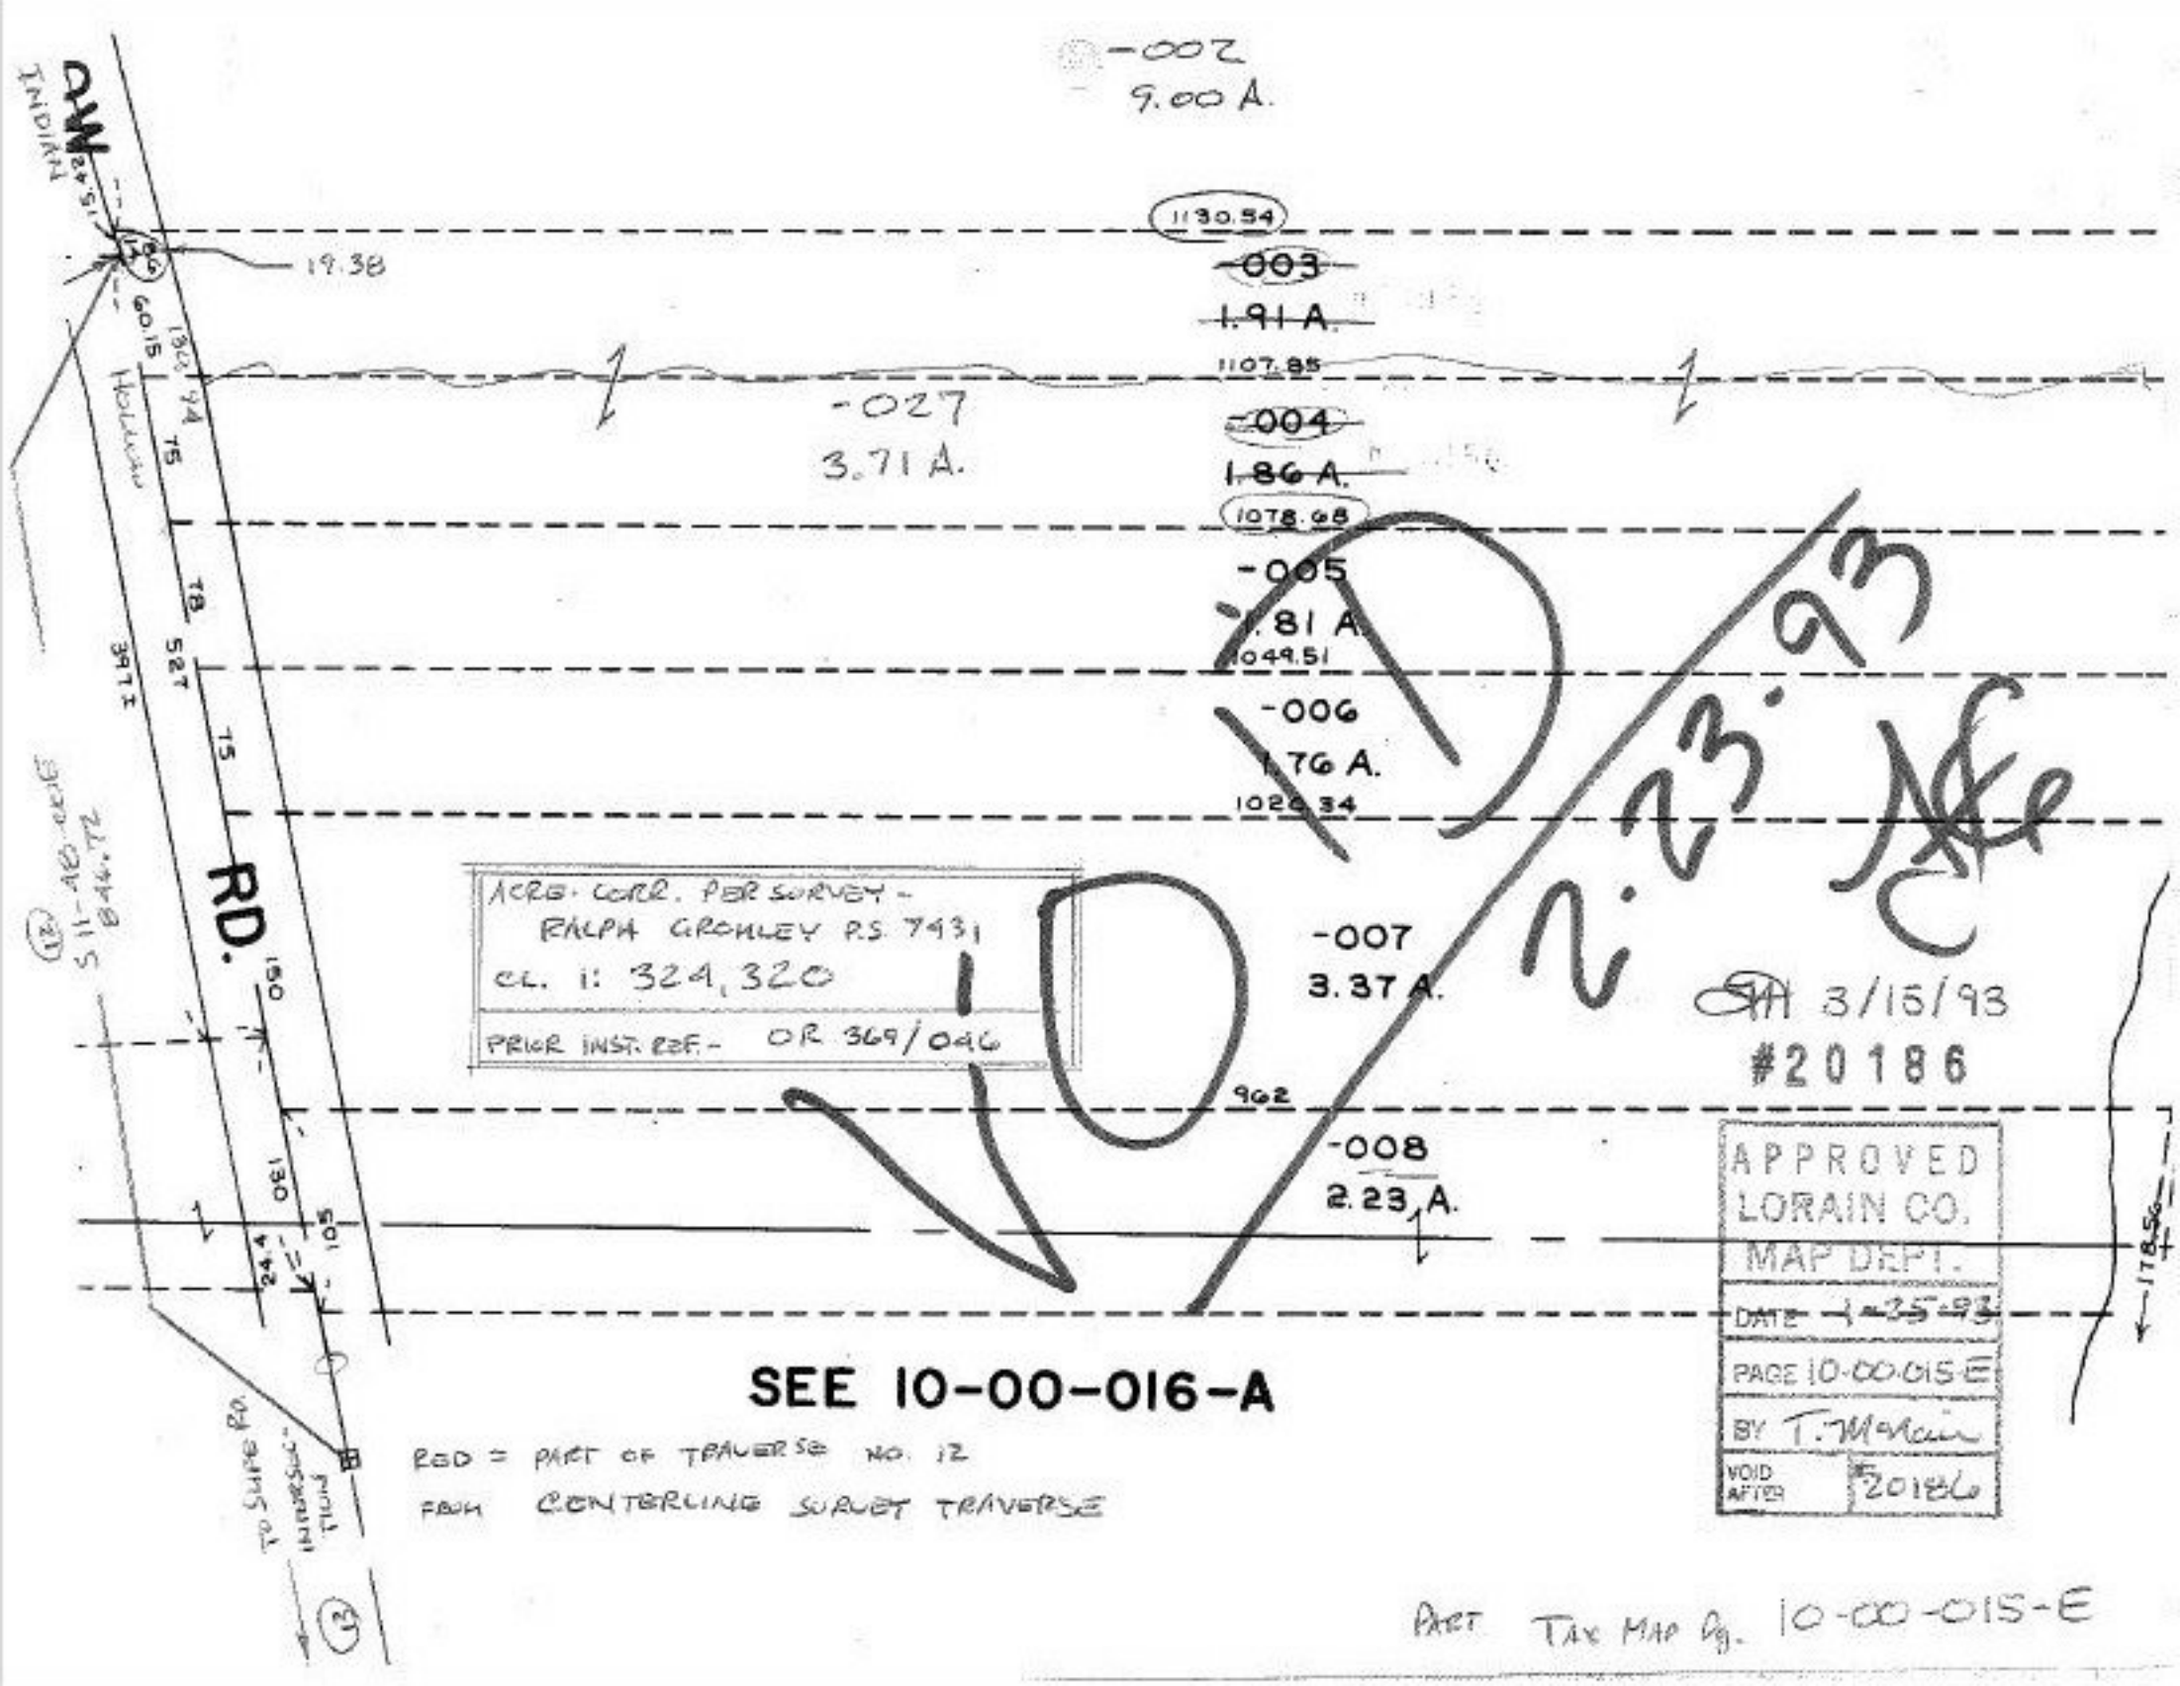
-002
9.00 A.
1130.54
-003
1.91 A.
1107.85
-027
3.71 A.
-004
1.86 A.
1078.68
-005
1.81 A.
1049.51
-006
1.76 A.
1026.34
-007
3.37 A.
962
-008
2.23 A.
ACRE. CORR. PER SURVEY - RALPH GROMLEY P.S. 7431
CL. 1: 324,320
PRIOR INST. REF. - OR 369/046
RD.
SEE 10-00-016-A
RED = PART OF TRAVERSE NO. 12 FROM CENTERLINE SURVEY TRAVERSE
APPROVED LORAIN CO. MAP DEPT.
DATE 1-25-93
PAGE 10-00-015-E
BY T. Malcuit
VOID AFTER 20186
3/15/93
#20186
PART TAX MAP Pg. 10-00-015-E