


SEE 1-00-043-B

± Baumhart Rd

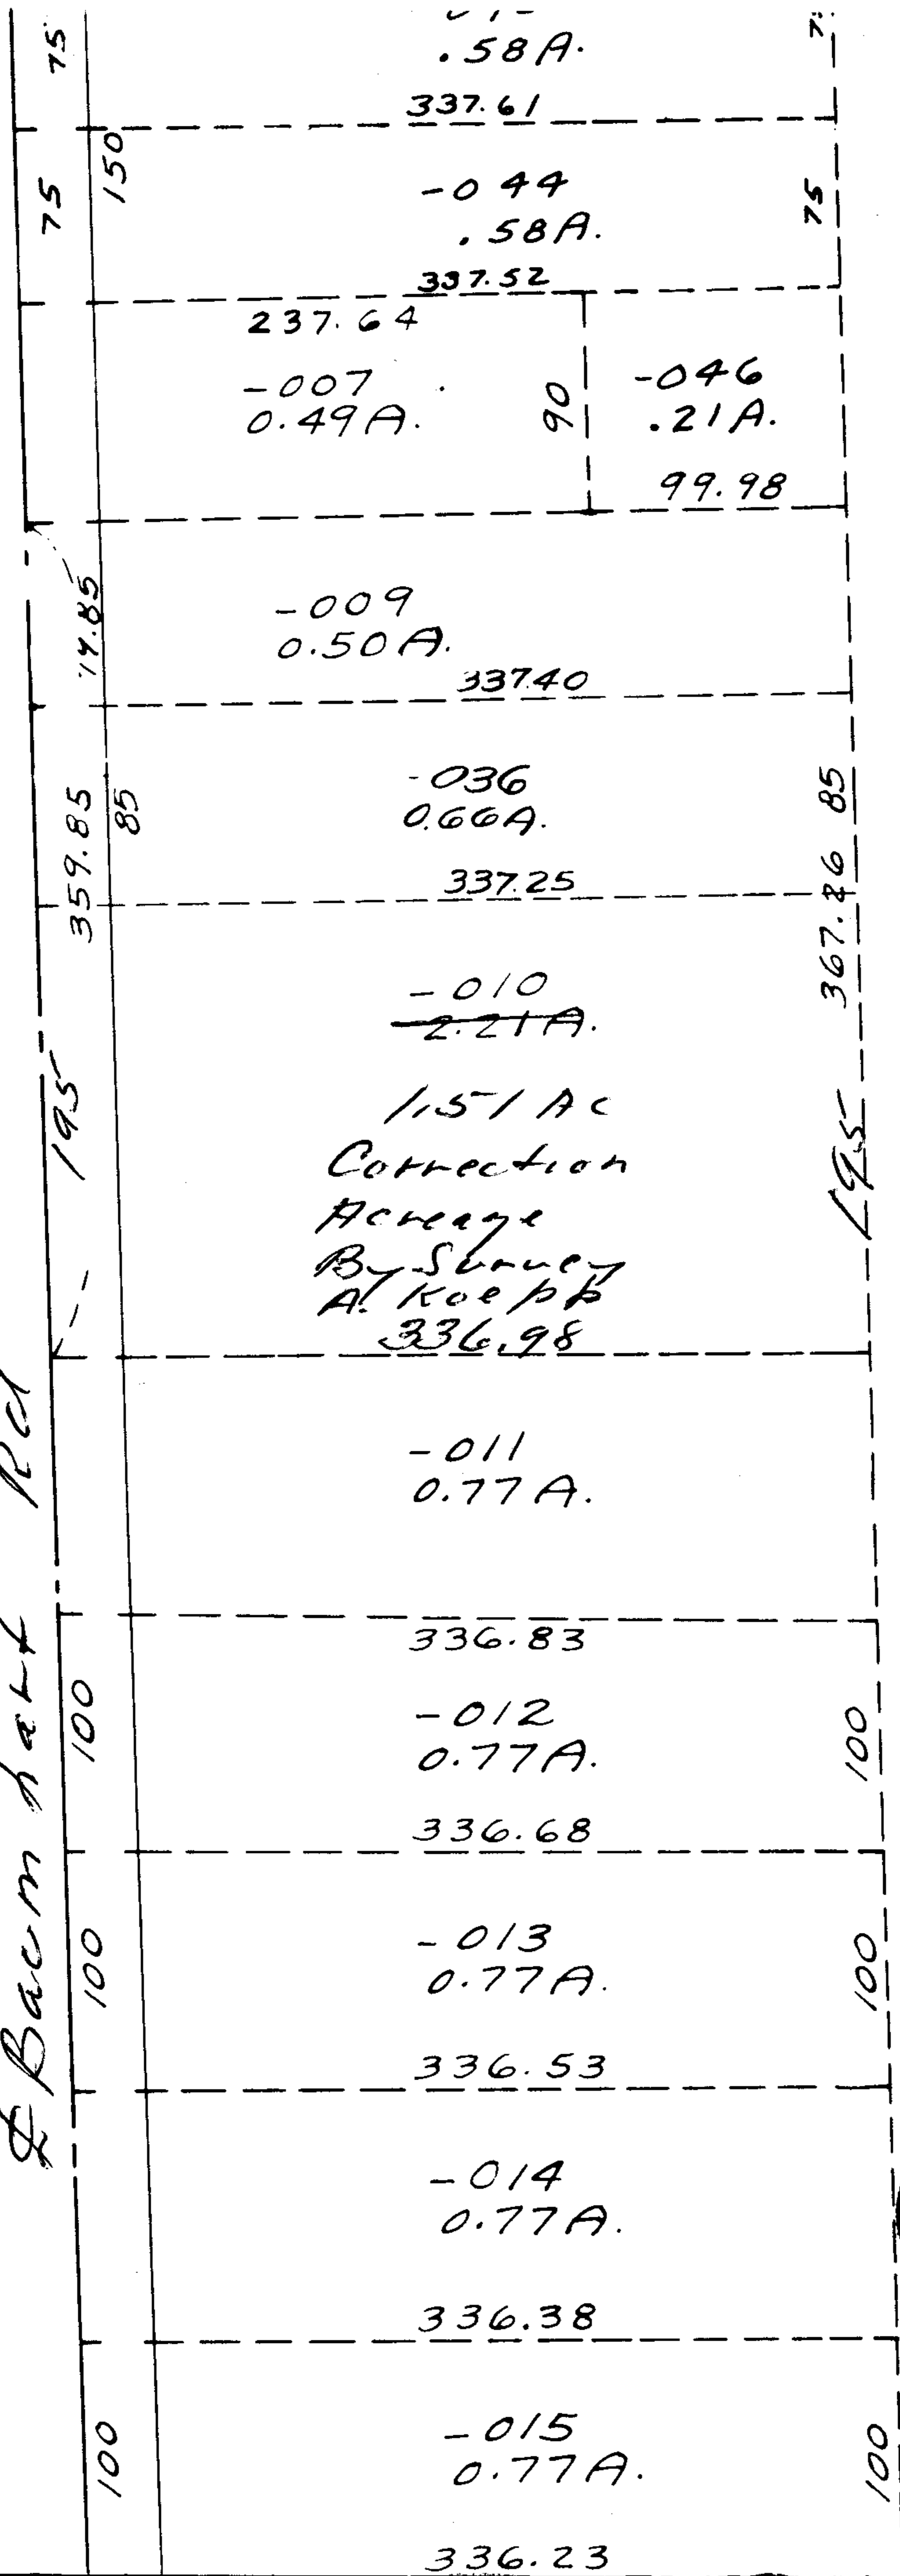

-022
25.97 A.

7-14-86 S.S.
#2019
APPROVED
LORAIN CO.
MAP DEPT.
DATE 8-12-68
1-00-042A
BY L.W. Hall



1-00-042A