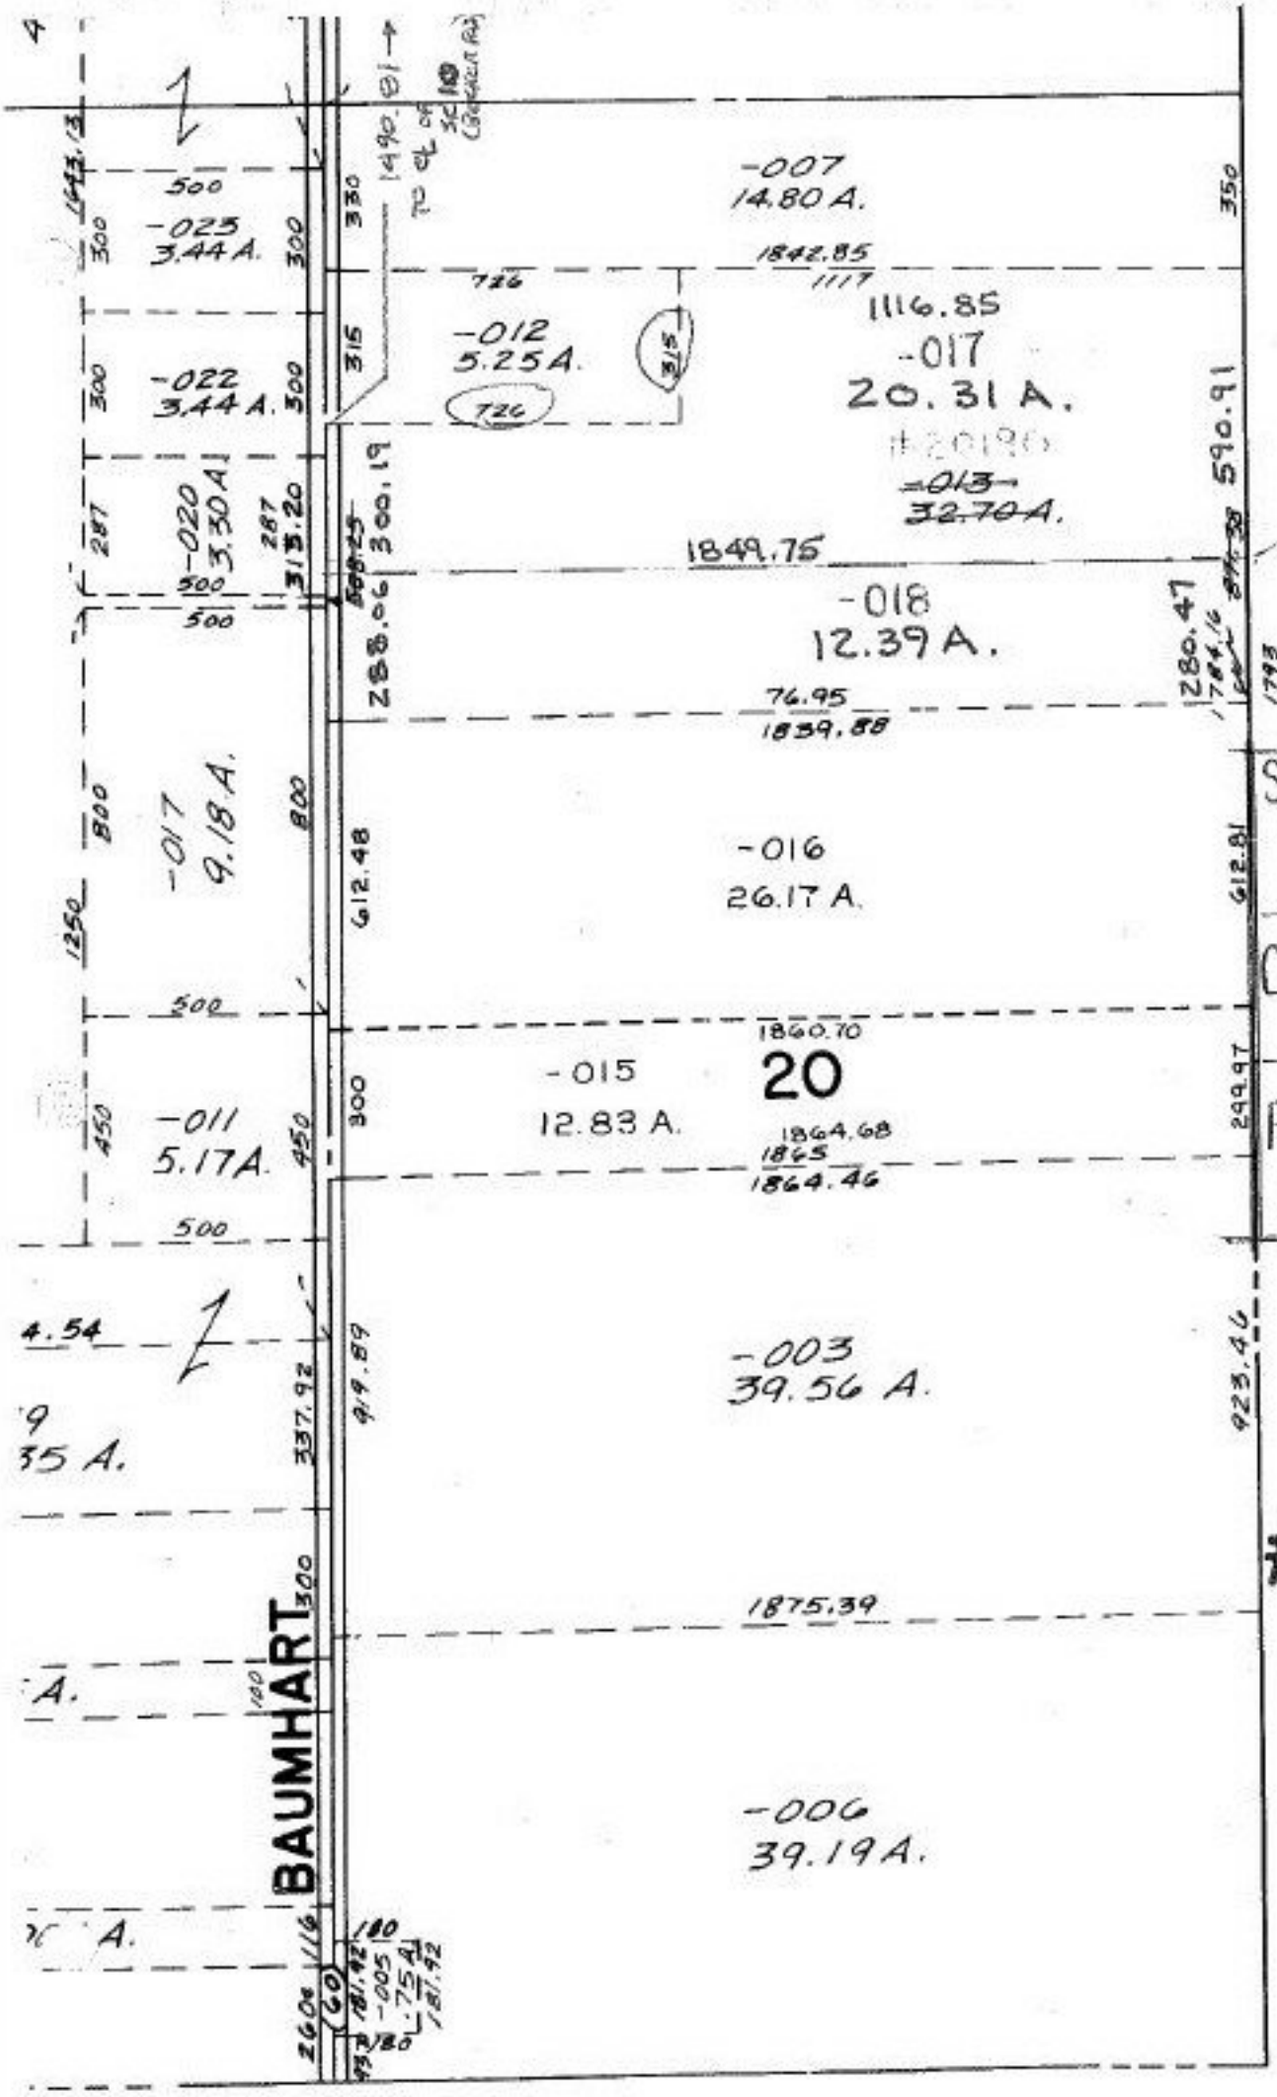

SURVEYED BY:
THOMAS M. SNEZEK

CLOSURE: 1:1,130,232

PRIOR INSTRUMENT
O.R. VOL. 591 PG. 679

#20190

APPROVED
LORAIN CO.
MAP DEPT.

DATE 12/17/92

PAGE 8-H

BY T. HOLLIS & F. COLBERT

VOID AFTER 20190