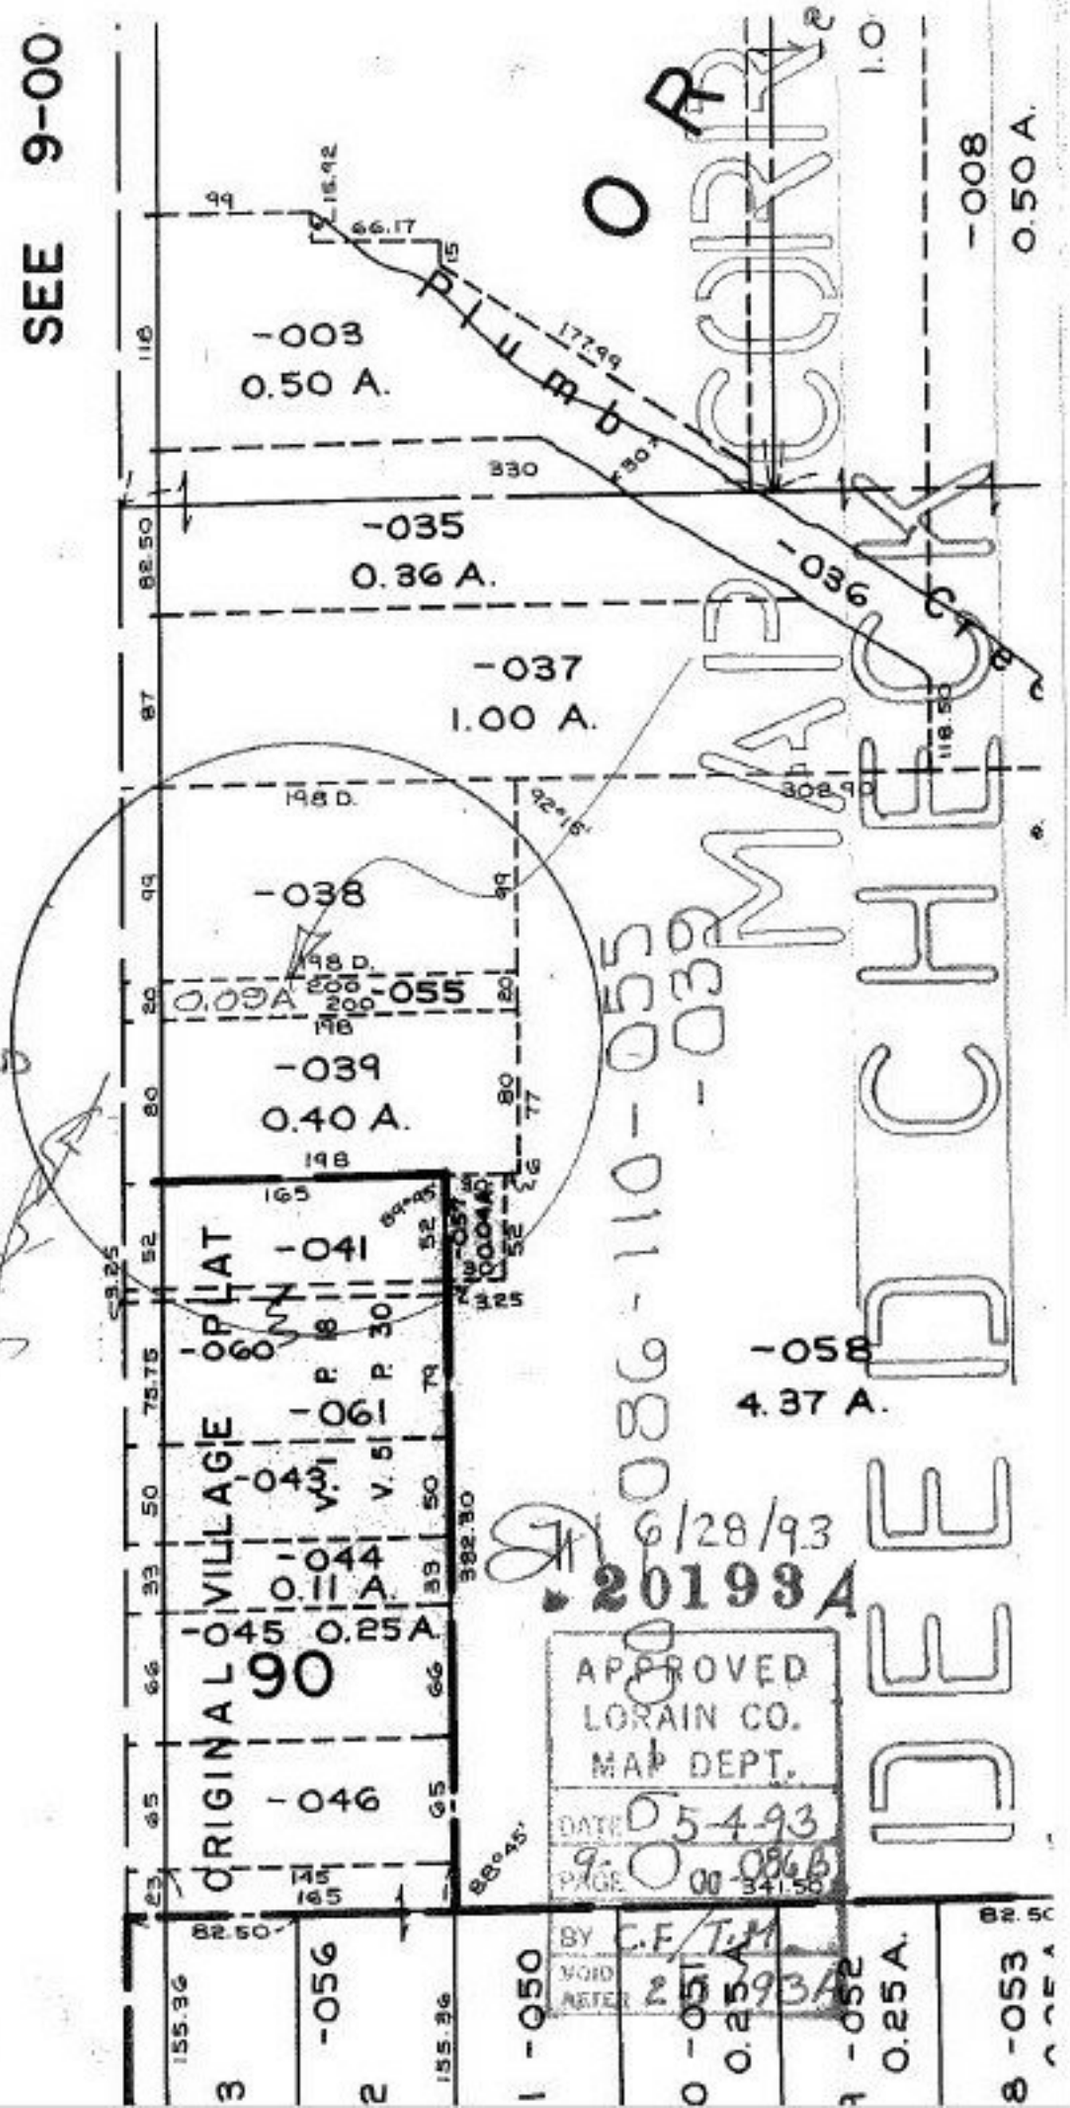

DEED CHECK
12/15 NEED
SURVEY SO ℄
AND E. LINE
CAN BE FOUND
AND DETERMINDED
NEED TIE INS

DV.O.R. 647/315
DEED FILED
1-6-93