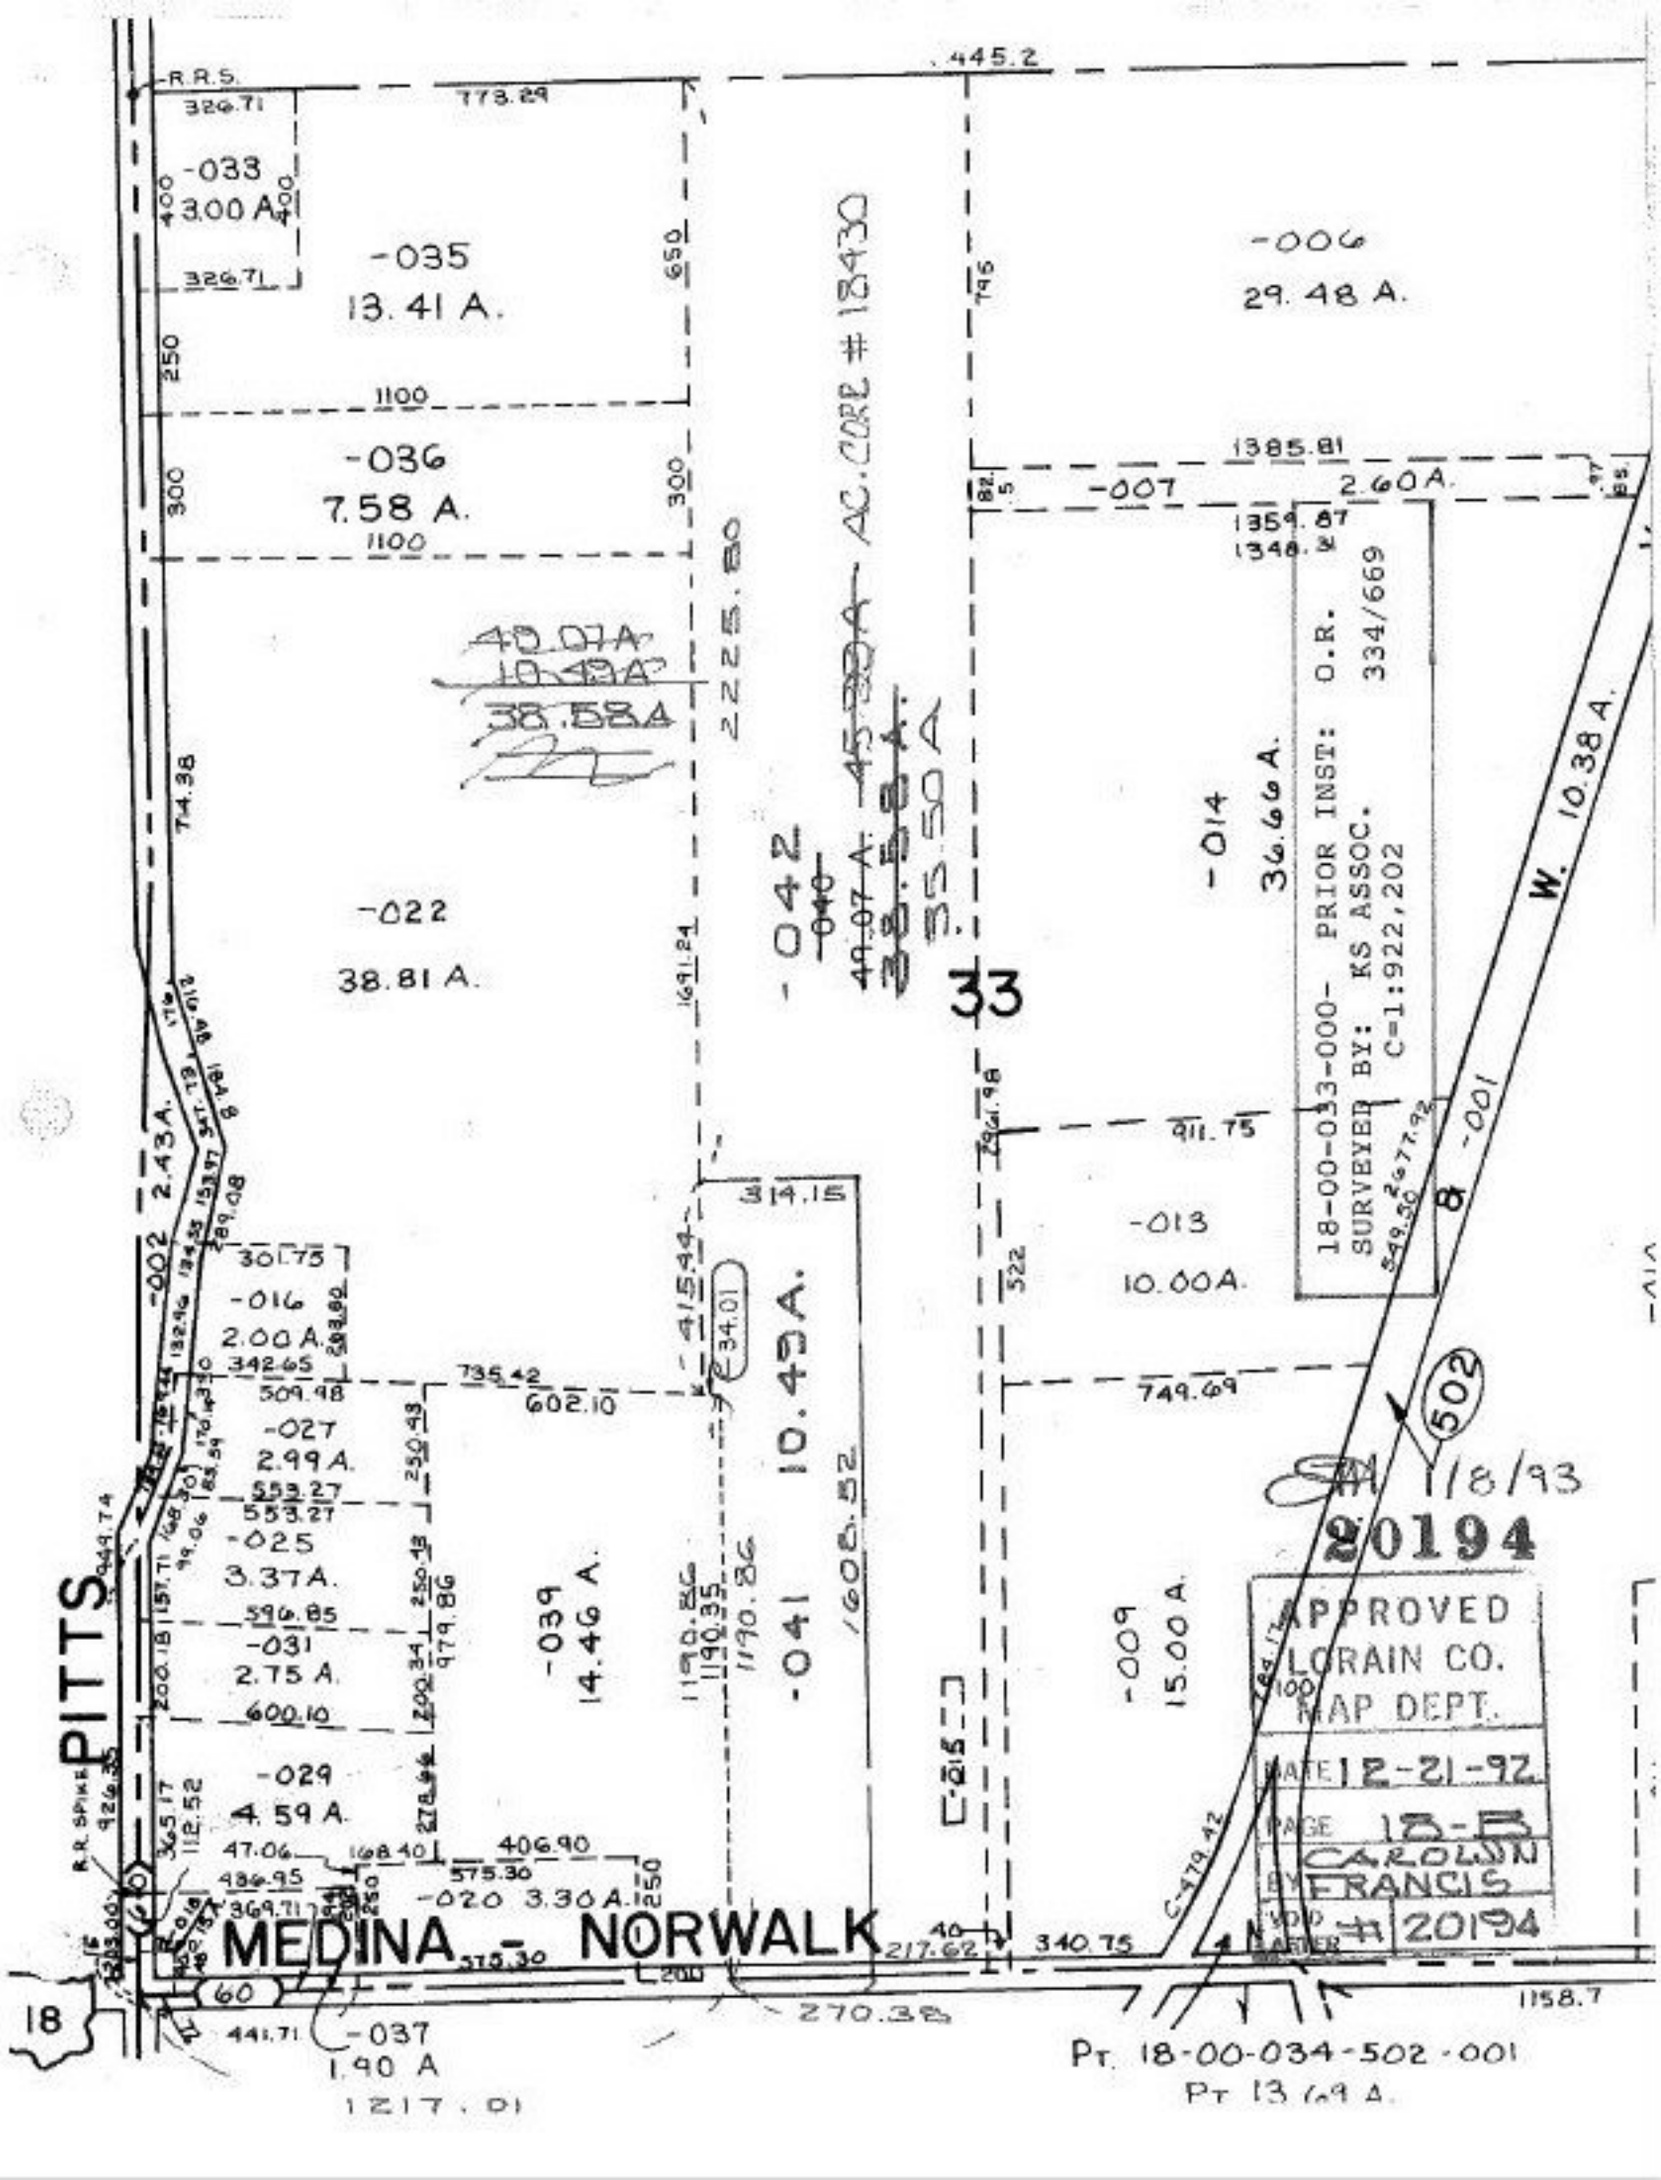
R.R.S.
445.2
778.29
326.71
-033
3.00 A
400
400
-035
13.41 A.
650
326.71
250
1100
-036
7.58 A.
300
300
1100
-006
29.48 A.
796
1385.81
82.5
-007
2.60A.
1359.87
1348.12
18-00-033-000- PRIOR INST: O.R. 334/669
SURVEYED BY: KS ASSOC. C=1:922,202
40.07A
10.49A
38.58A
2225.80
-042
040
40.07 A.
45.33A
38.58 A.
35.50A
AC. CORP # 18430
-014
36.66A.
W. 10.38 A.
-001
8
33
-022
38.81 A.
1691.84
74.38
-002
2.43A.
-013
10.00A.
322
911.75
2961.98
549.30
2677.92
-016
2.00 A.
342.65
509.98
301.75
293.82
736.42
602.10
34.01
14.15
415.44
749.69
-027
2.99 A.
553.27
553.27
250.43
-025
3.37A.
596.85
-031
2.75 A.
600.10
979.86
250.43
-039
14.46 A.
1190.86
1190.35
1190.86
-041
10.49A.
1608.52
-009
15.00 A.
C-215
C-479.42
502
11/8/93
20194
APPROVED
LORAIN CO.
MAP DEPT.
DATE 12-21-92
PAGE 18-B
BY CAROLYN FRANCIS
MAP # 20194
AFTER
PITTS
MEDINA - NORWALK
-029
4.59 A.
-020 3.30 A.
-037
1.90 A
1217.01
Pt. 18-00-034-502-001
Pt 13.69 A.
18
60
270.38
1158.7
340.75
217.62
575.30
406.90
168.40
47.06
486.95
112.52
365.17
926.35
R.R. SPIKE