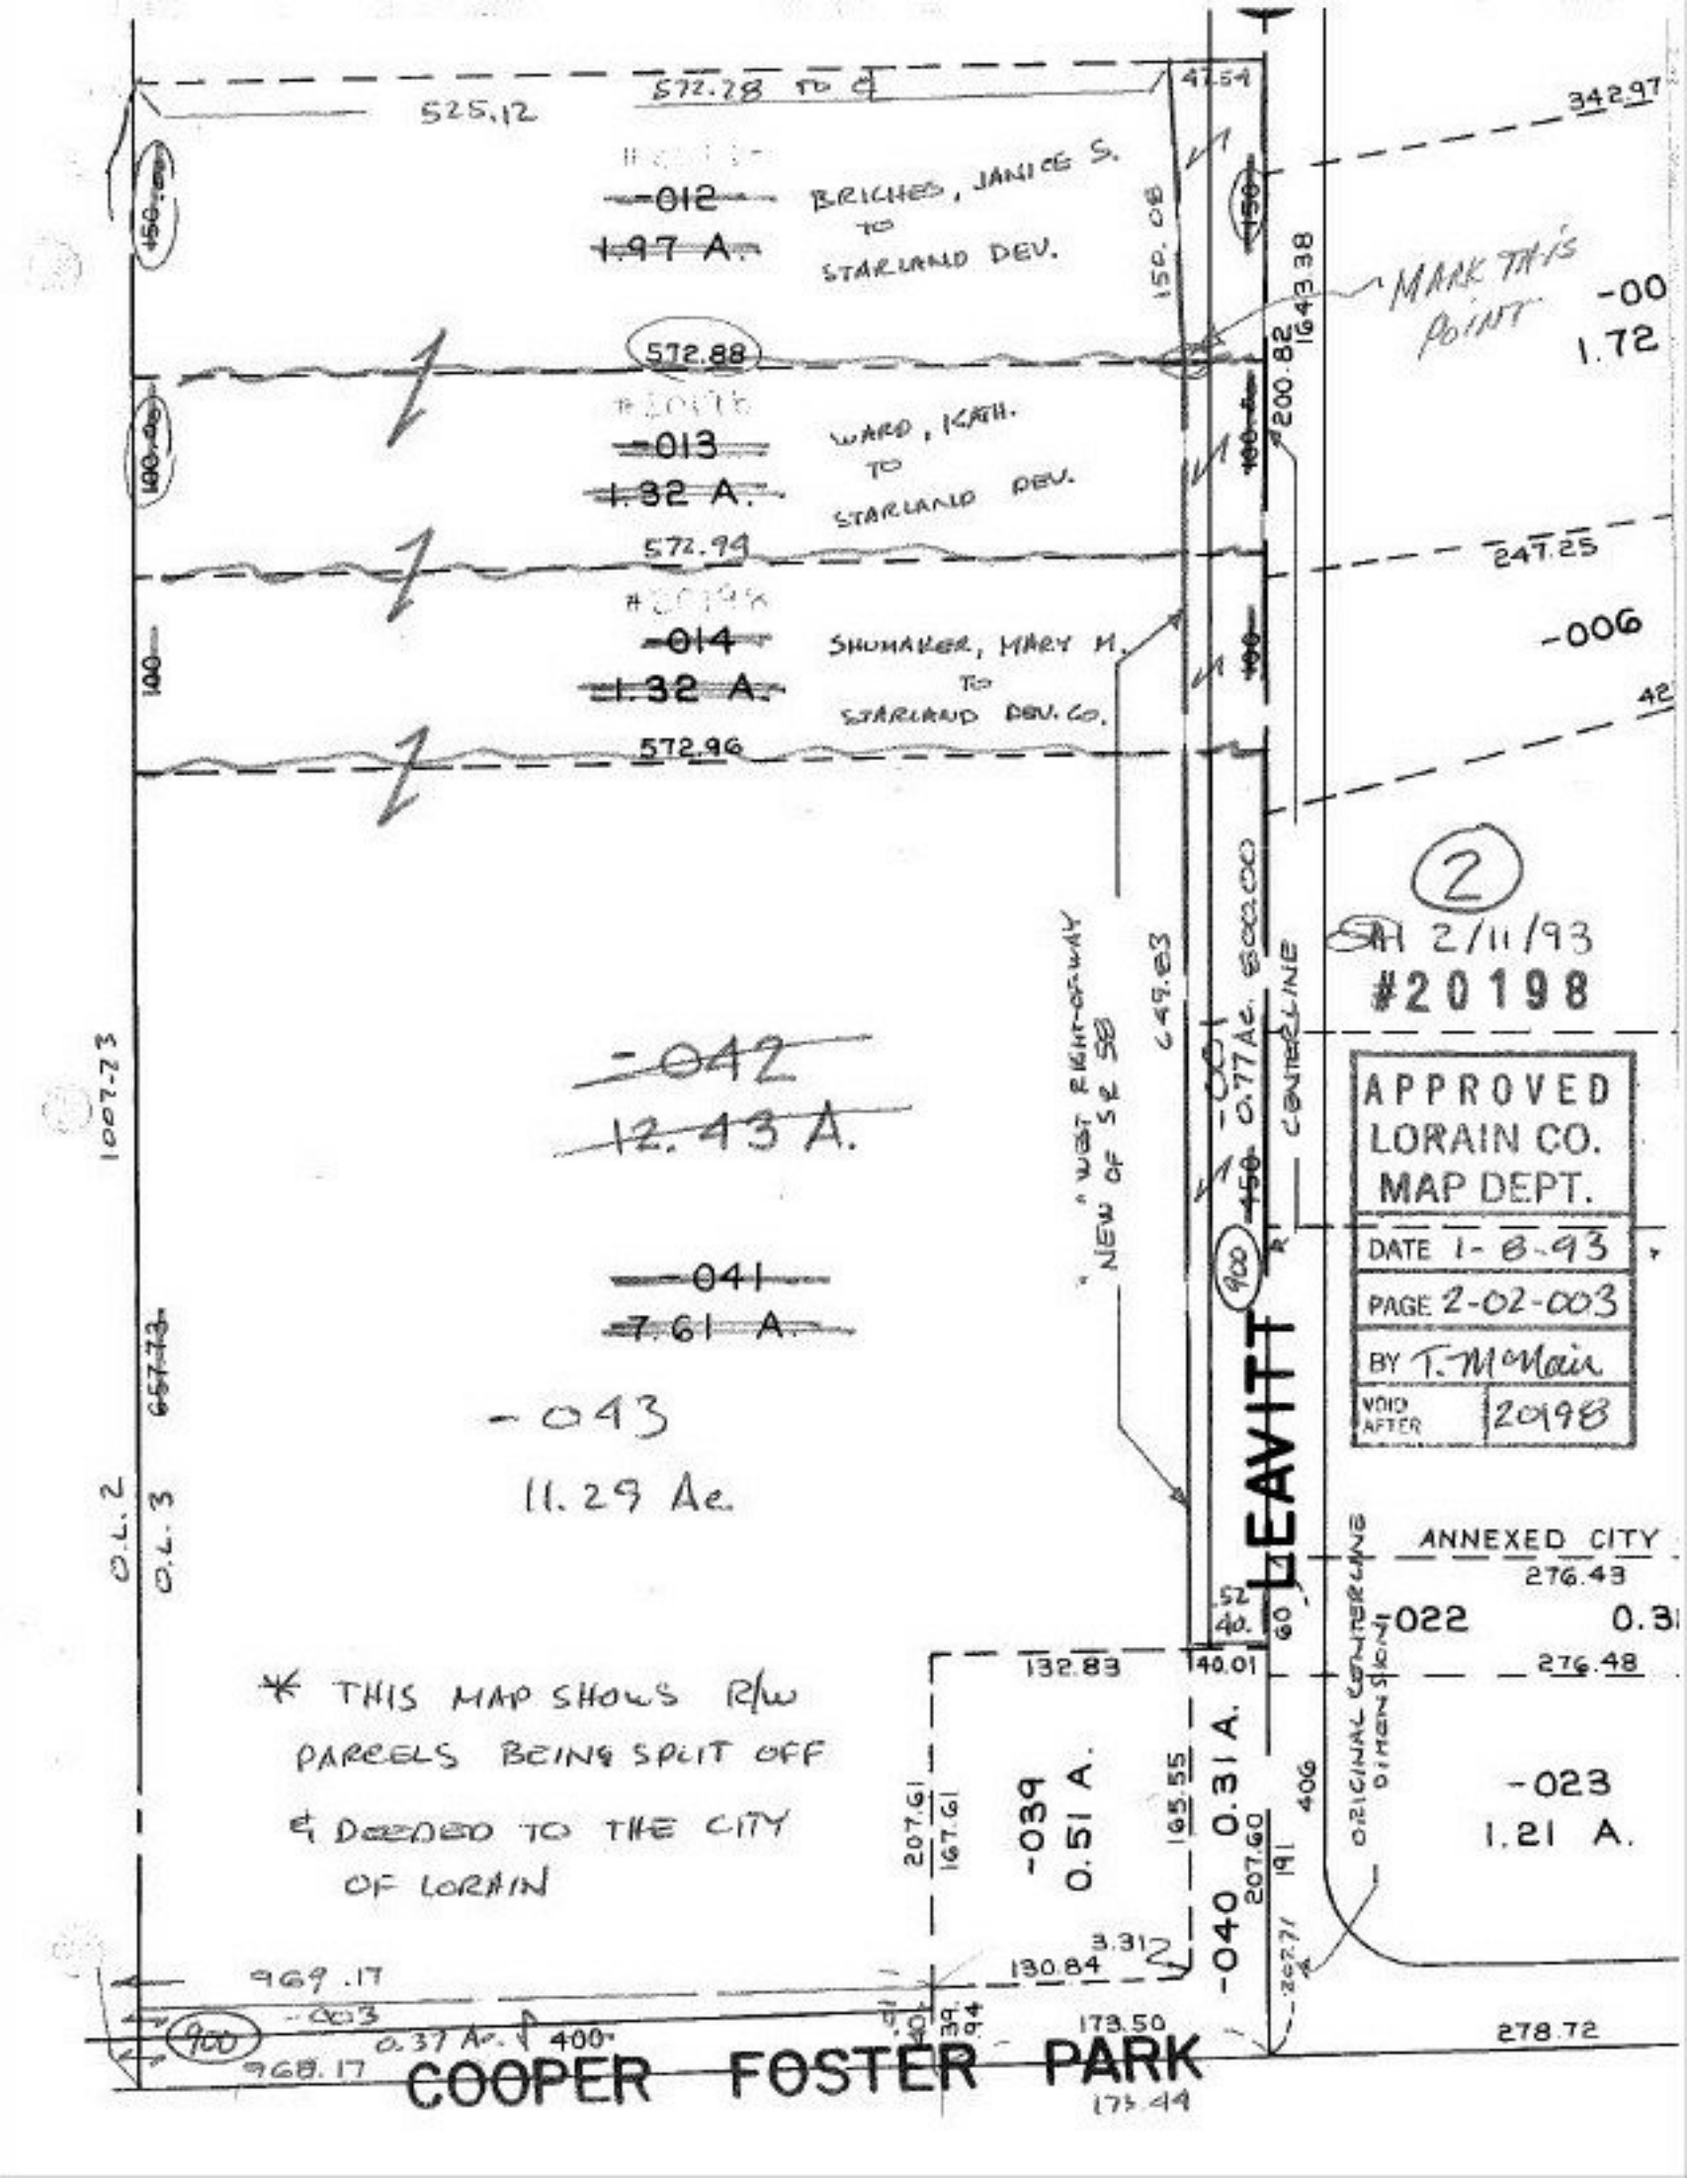

572.28 TO ℄
525.12
47.54
342.97
-012
1.97 A.
BRICHES, JANICE S.
TO
STARLAND DEV.
150.08
1643.38
MARK THIS POINT
-00
1.72
572.88
200.82
-013
1.32 A.
WARD, KATH.
TO
STARLAND DEV.
572.94
247.25
-014
1.32 A.
SHUMAKER, MARY M.
TO
STARLAND DEV. CO.
-006
572.96
2
SH 2/11/93
#20198
APPROVED
LORAIN CO.
MAP DEPT.
DATE 1-8-93
PAGE 2-02-003
BY T. McNair
VOID AFTER 20198
-042
12.43 A.
"WEST RIGHT-OF-WAY
NEW OF SR 58
649.83
-001
0.77 Ac.
800.00
CENTERLINE
1007.73
-041
7.61 A.
-043
11.29 Ac.
LEAVITT
ANNEXED CITY
276.43
-022
0.31
276.48
O.L. 2
O.L. 3
132.83
40.01
* THIS MAP SHOWS R/W
PARCELS BEING SPLIT OFF
& DEEDED TO THE CITY
OF LORAIN
-039
0.51 A.
-040
0.31 A.
ORIGINAL CENTERLINE DIMENSION
-023
1.21 A.
207.61
167.61
165.55
207.60
406
191
3.31
130.84
969.17
-003
0.37 Ac.
400
968.17
173.50
278.72
COOPER FOSTER PARK
173.44