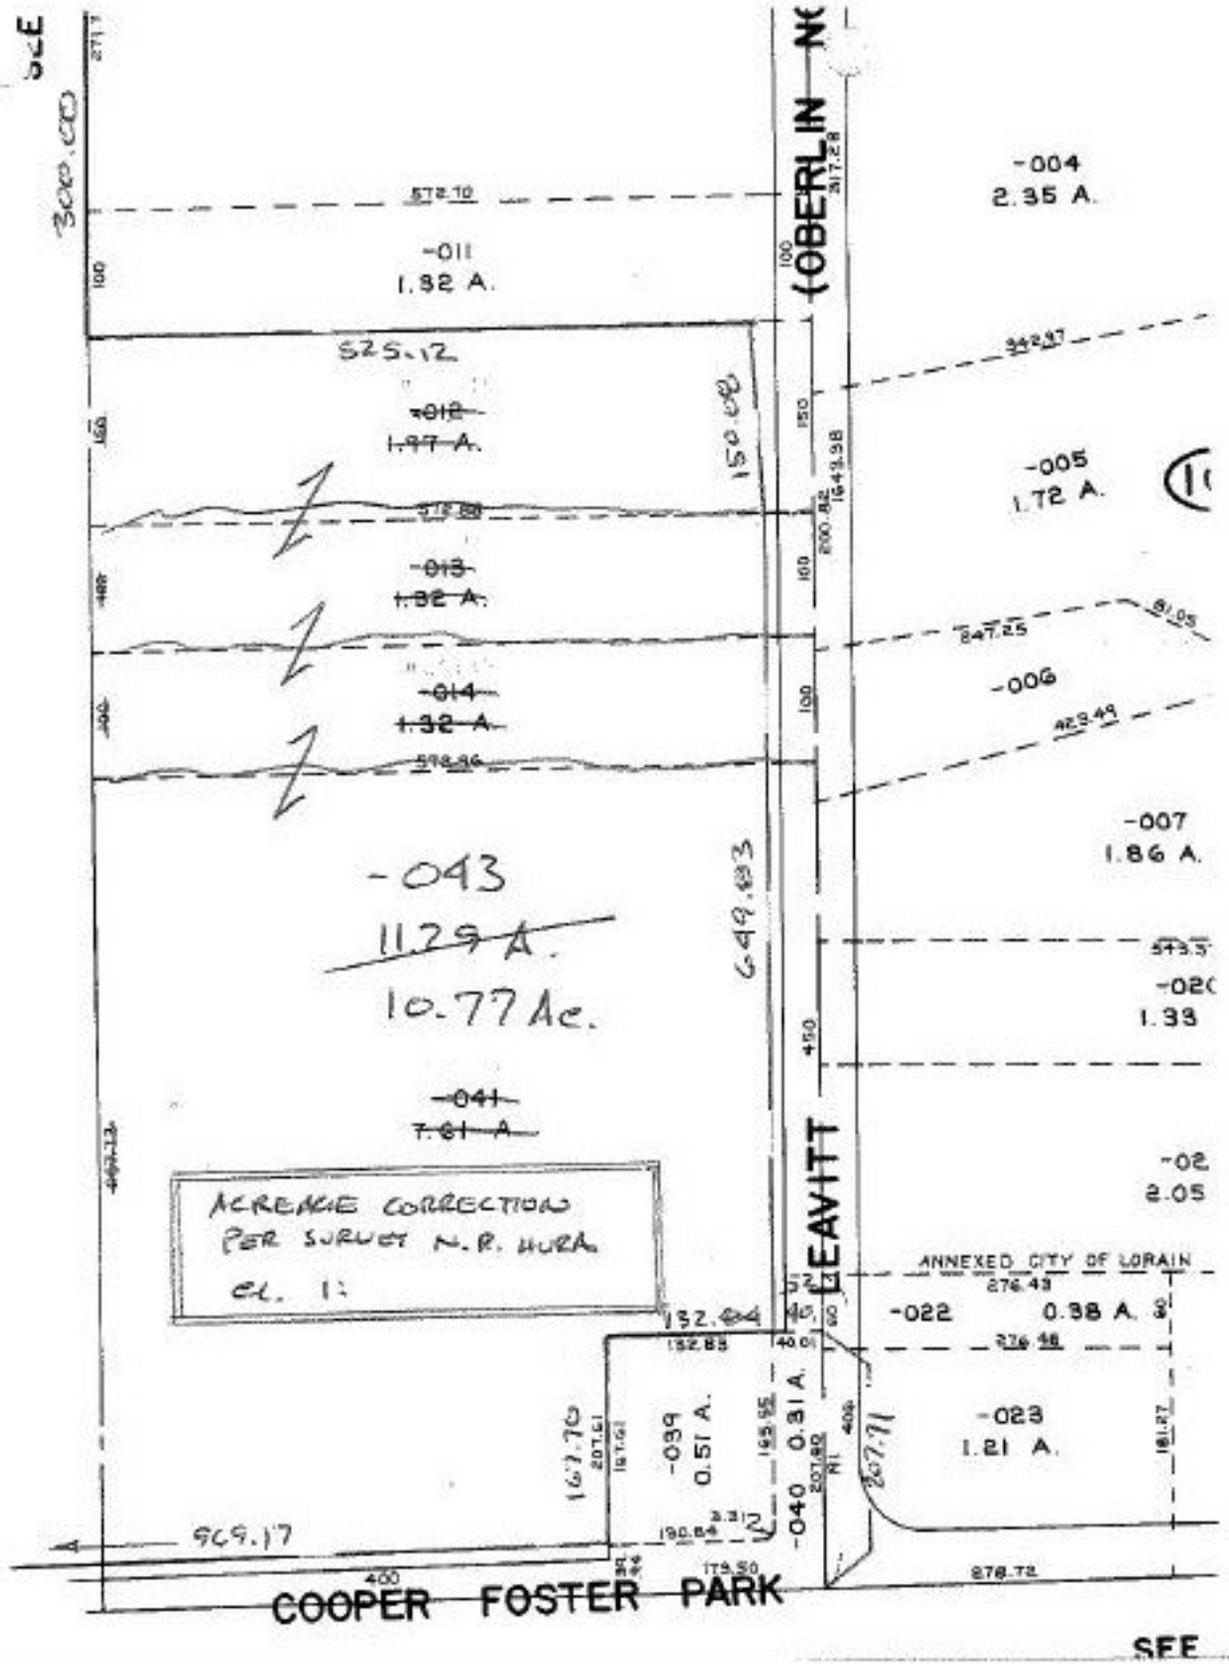

ACREAGE CORRECTION

(3)

2/11/93

#20198

APPROVED
LORAIN CO.
MAP DEPT.
DATE 1-8-93
PAGE 2-02-003
BY T. McNair
WORD AFTER 20198

02-02-003