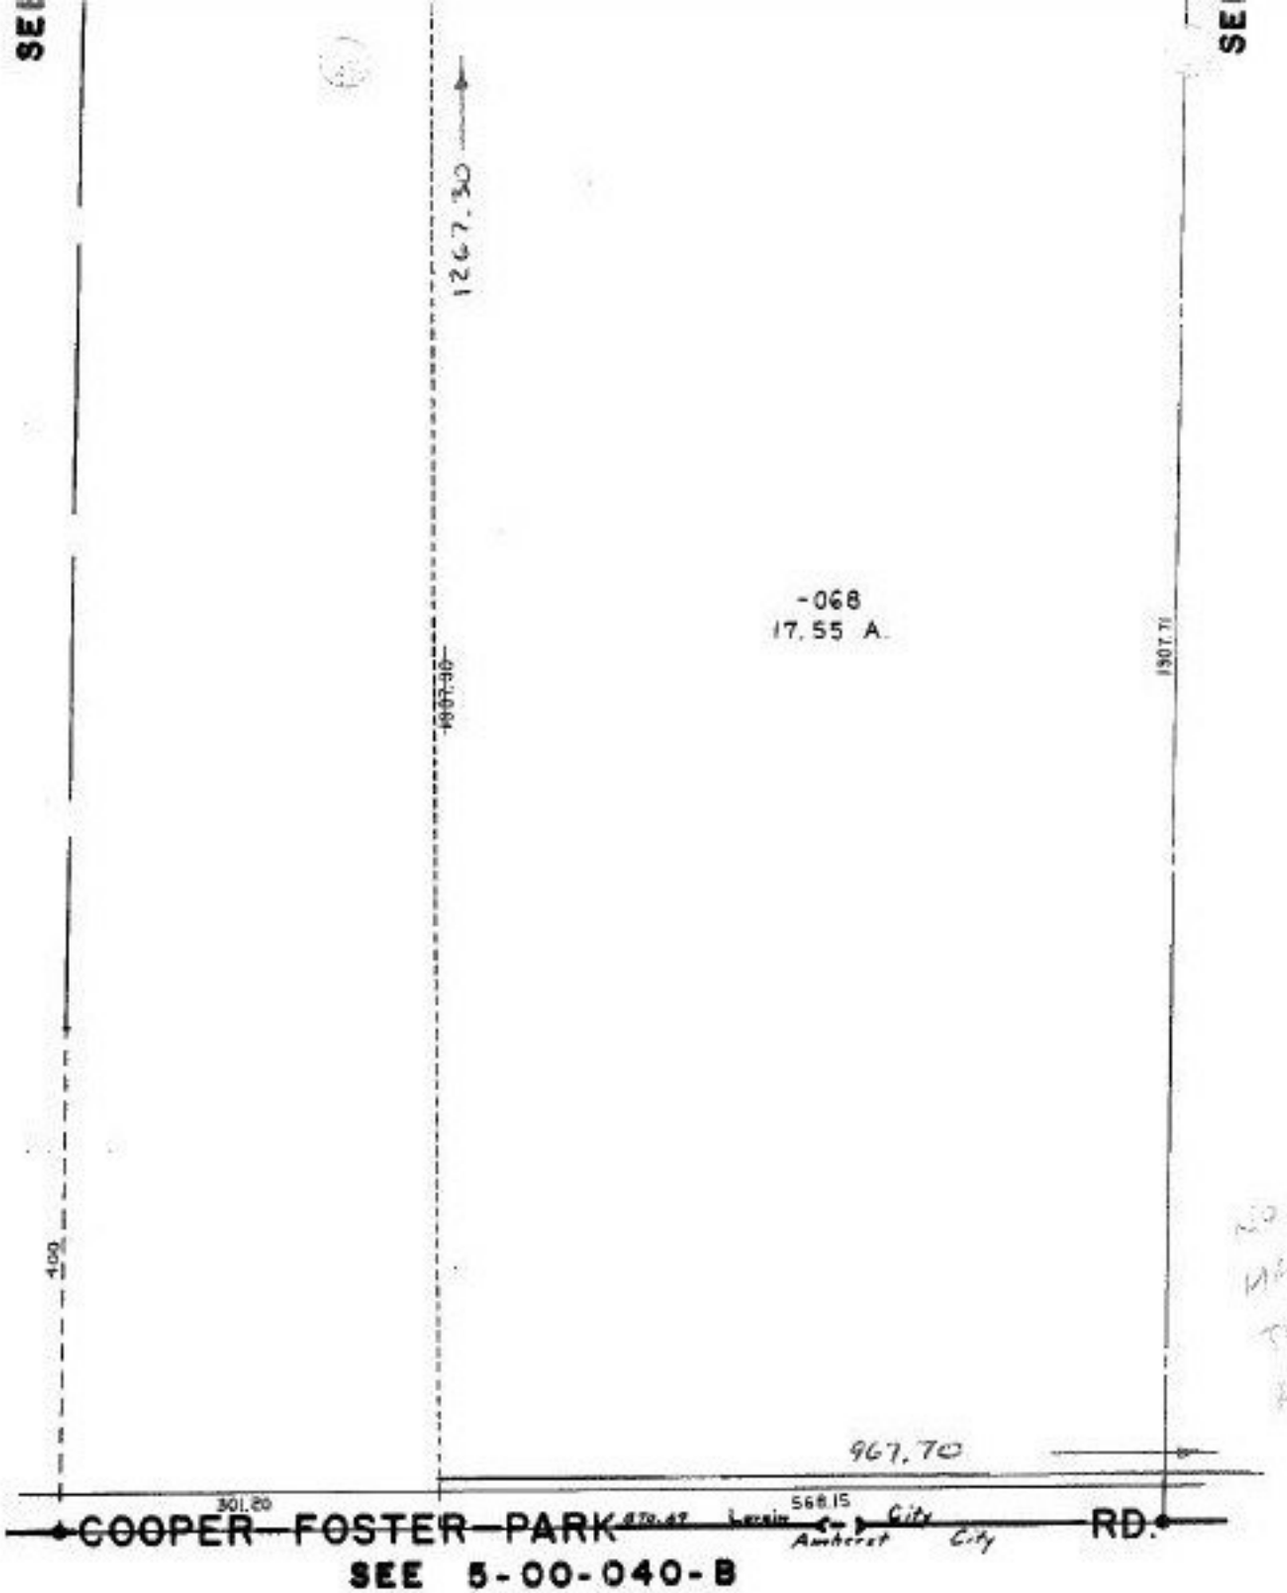
SEE
SEE
1267.30
-068
17.55 A.
1307.70
100
967.70
301.20
568.15
COOPER FOSTER PARK
Lorain
Amherst
City
City
RD.
SEE 5-00-040-B