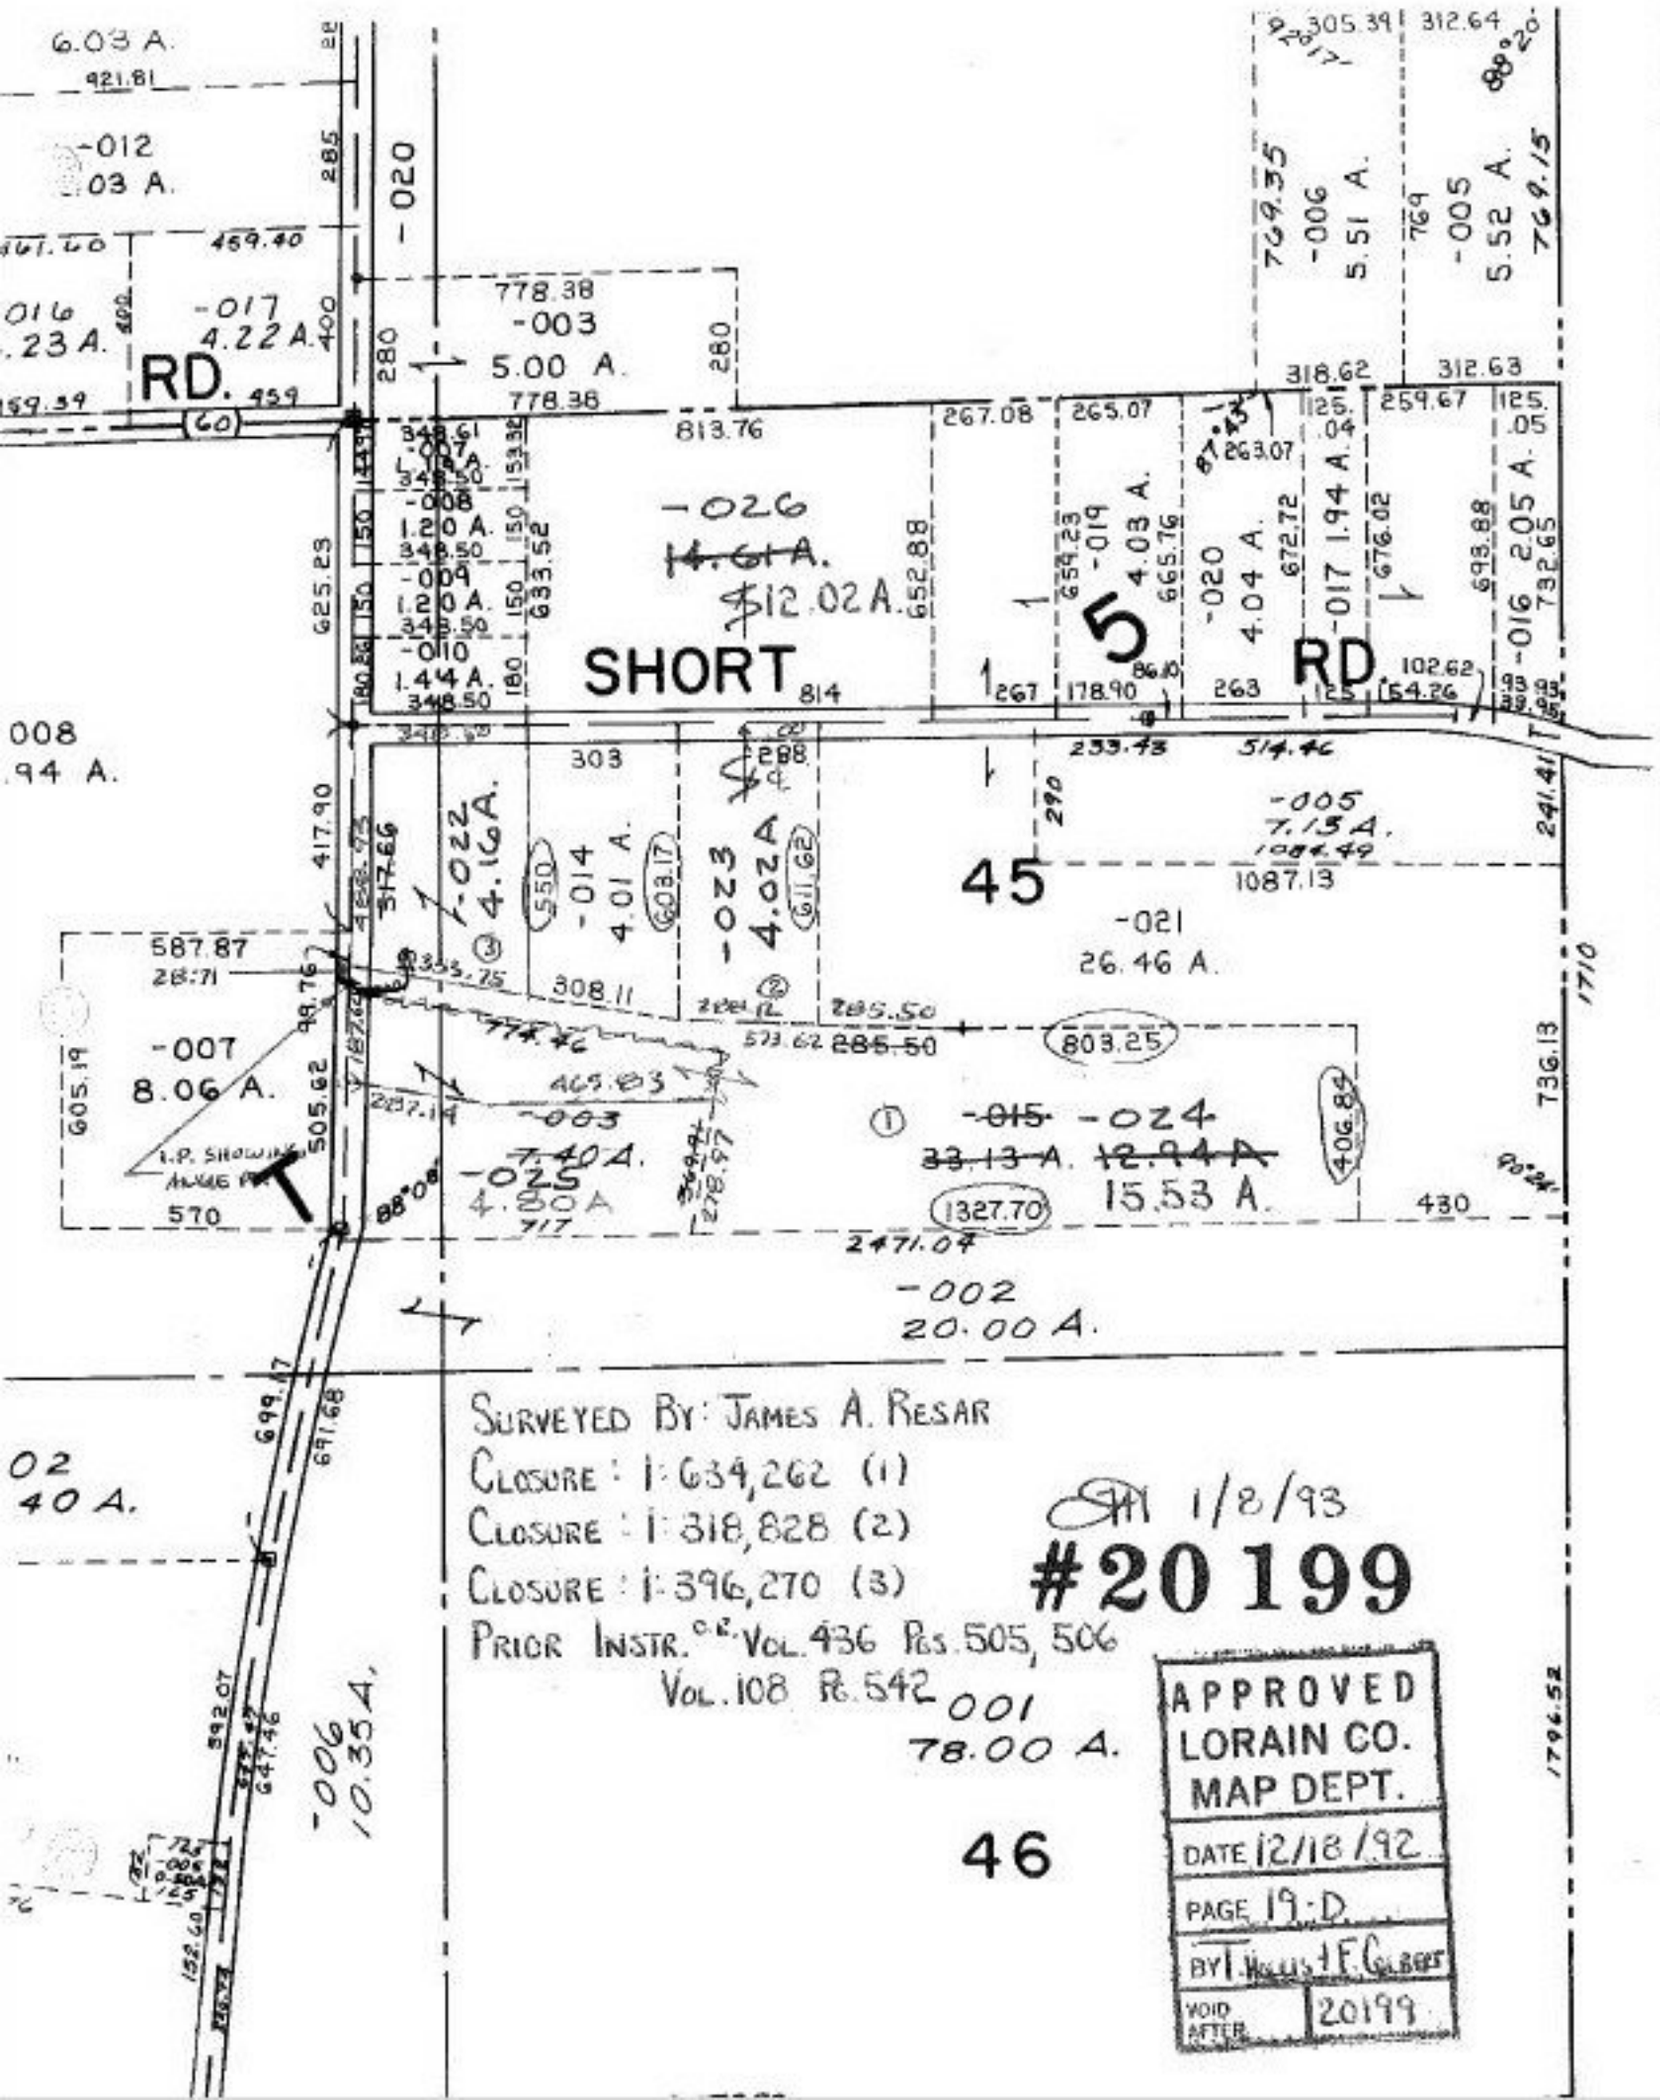
6.03 A.
-012
03 A.
-020
-017
4.22 A.
RD.
-003
5.00 A.
778.38
-026
14.61 A.
12.02 A.
SHORT
814
-019
4.03 A.
-020
4.04 A.
-017 1.94 A.
-016 2.05 A.
RD
5
-005
5.52 A.
-006
5.51 A.
-008
1.20 A.
-009
1.20 A.
-010
1.44 A.
008
.94 A.
-022
4.16A.
-014
4.01 A.
-023
4.02A.
-005
7.15A.
45
-021
26.46 A.
-007
8.06 A.
-024
15.53 A.
-025
4.80A
-003
7.40A.
-002
20.00 A.
-006
10.35A.
78.00 A.
46
SURVEYED BY: JAMES A. RESAR
CLOSURE 1: 634,262 (1)
CLOSURE 2: 318,828 (2)
CLOSURE 3: 396,270 (3)
PRIOR INSTR. O.R. VOL. 436 PGS. 505, 506
VOL. 108 PG. 542
1/8/93
#20199
APPROVED
LORAIN CO.
MAP DEPT.
DATE 12/18/92
PAGE 19-D
BY T. Wells & F.C. Gilbert
VOID AFTER 20199