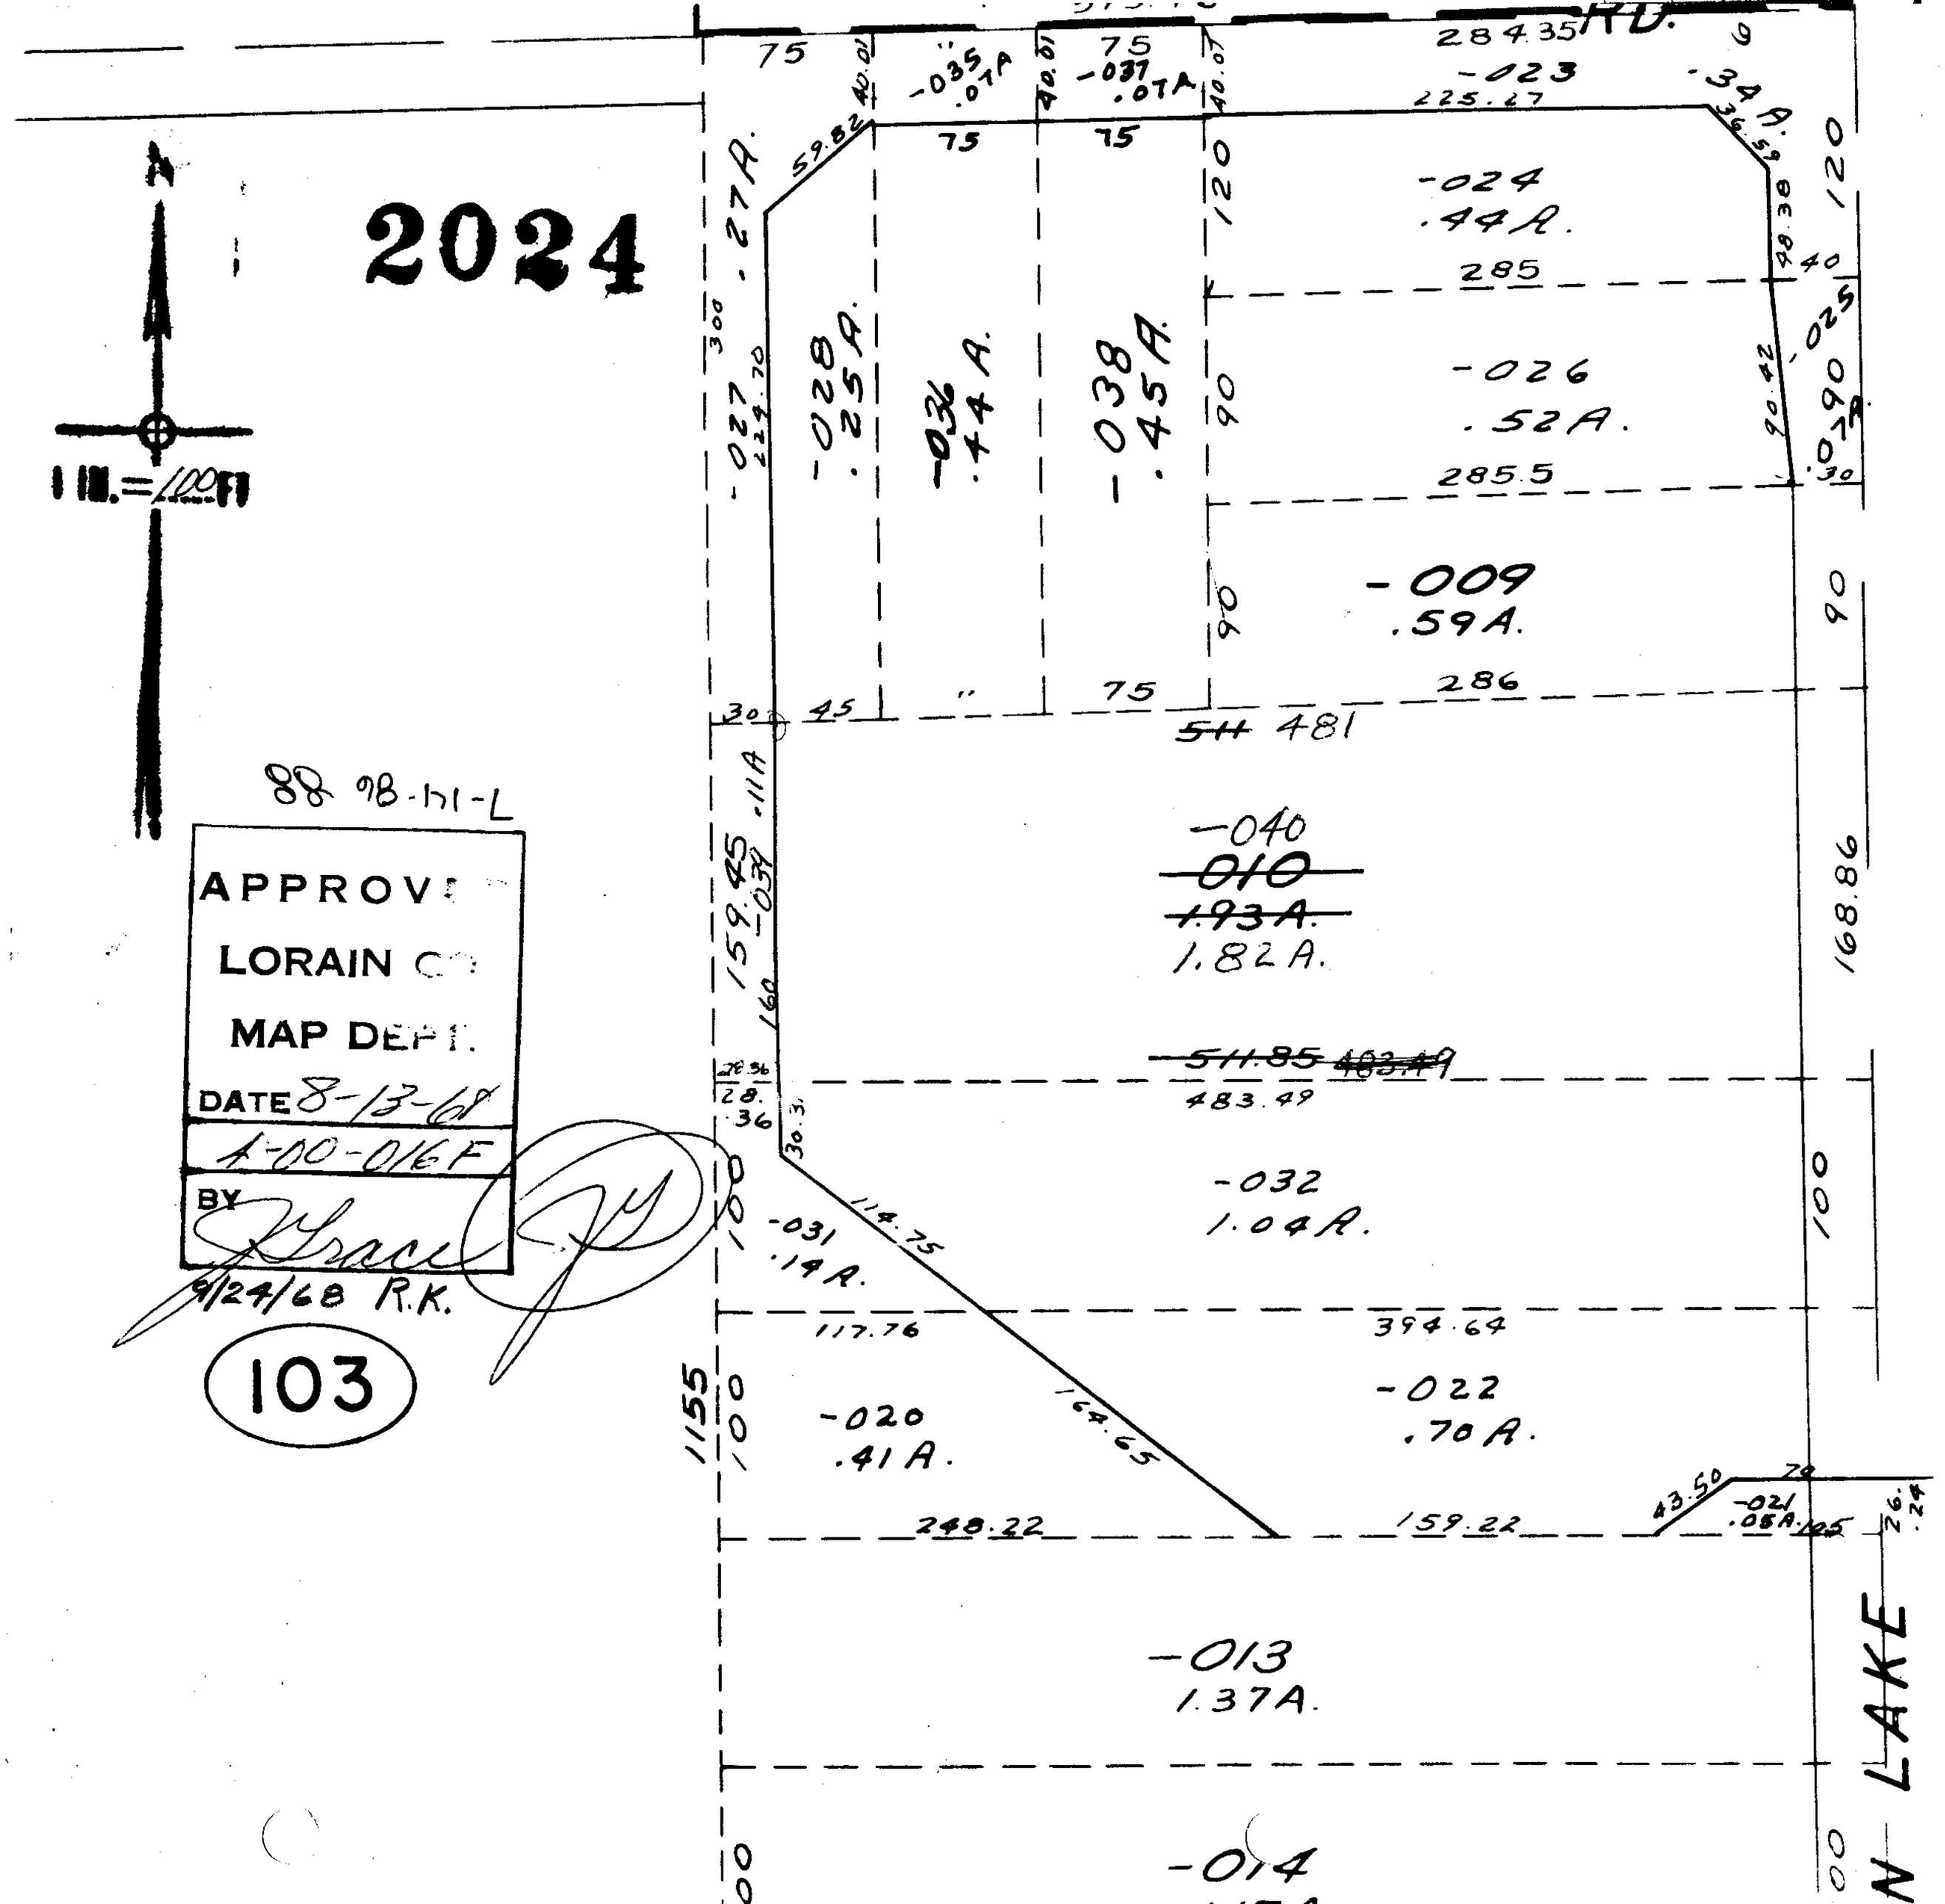
2024
1 IN.=100 FT
APPROV
LORAIN C
MAP DEPT.
DATE 8-13-68
4-00-016F
BY
9/24/68 R.K.
103
-023
-024
.44A.
-026
.52A.
-009
.59A.
-028
.25A.
-036
.44A.
-038
.45A.
-040
~~010~~
~~1.93A.~~
1.82A.
~~511.85~~ ~~483.49~~
483.49
-032
1.04A.
-031
.14A.
-020
.41A.
-022
.70A.
-013
1.37A.
-014
LAKE
RD.