2027

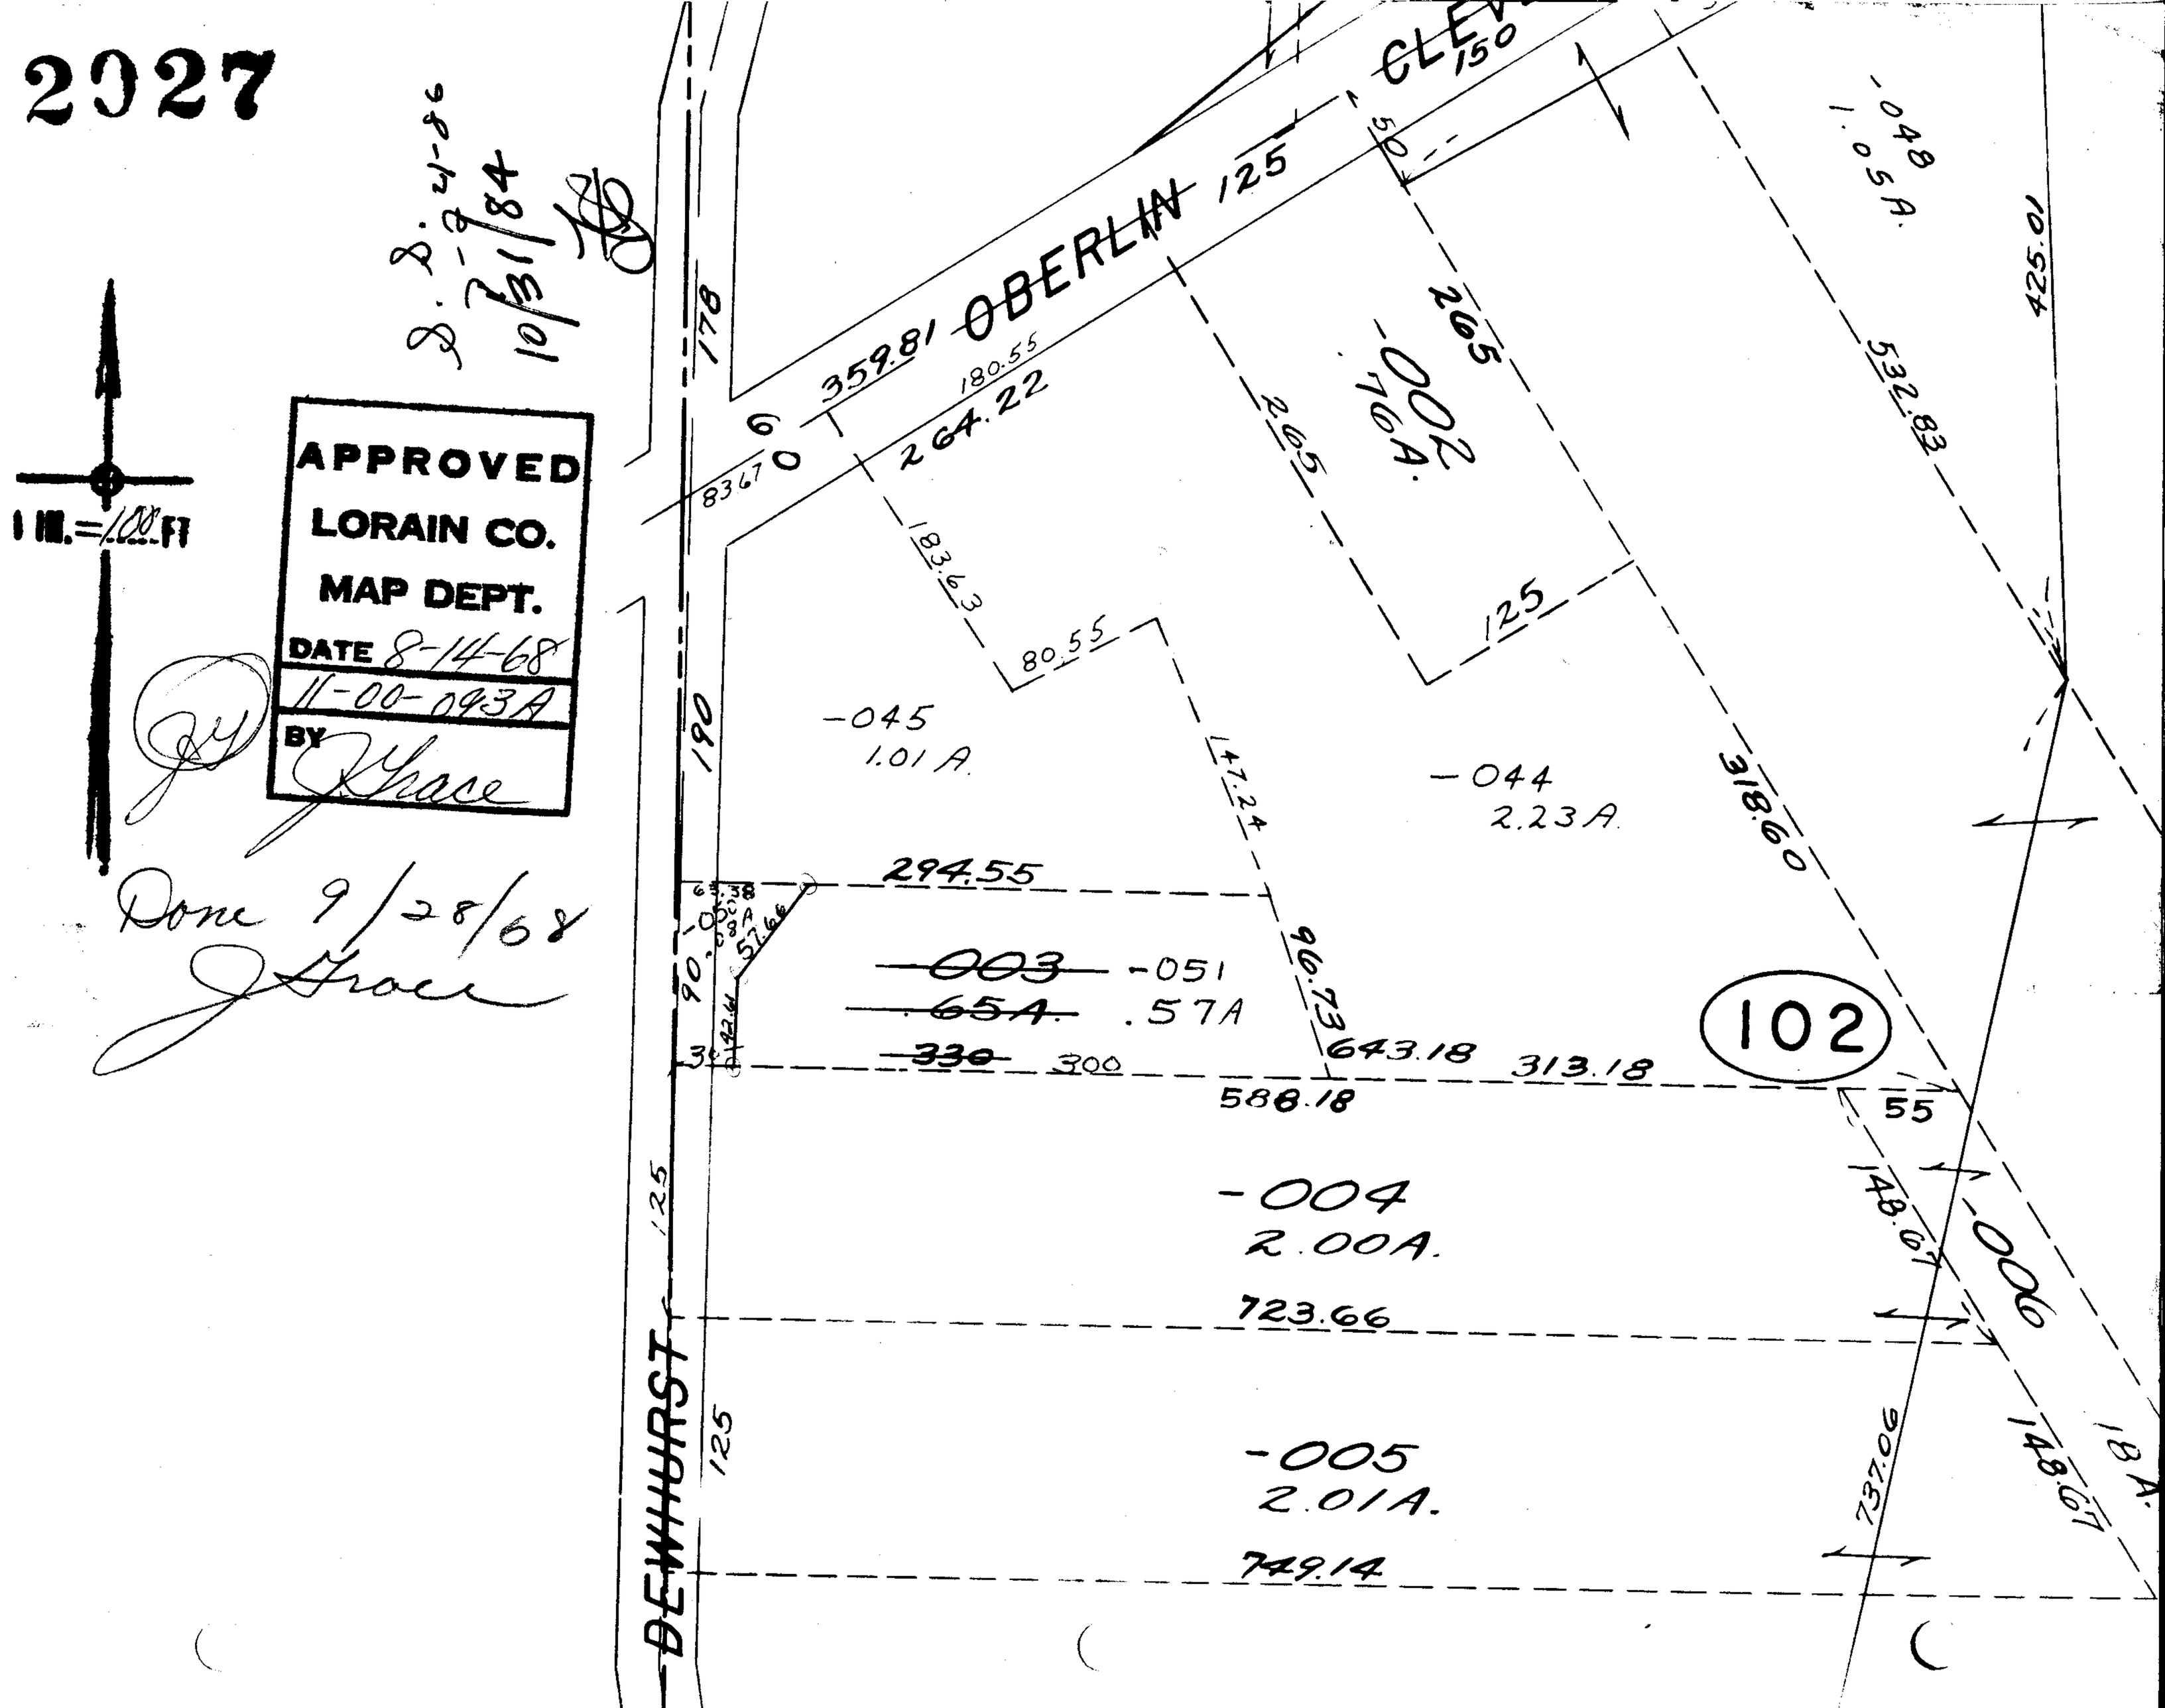

1 IN. = 100 FT
APPROVED
LORAIN CO.
MAP DEPT.
DATE 8-14-68
11-00-093A
BY J Grace
Done 9/28/68
J Grace
S. S. 4-86
10/31/84
OBERLIN
CLEV
150
125
359.81
180.55
264.22
83.67
178
190
265
-002
76A.
265
125
-048
1.05A.
425.01
532.83
183.63
80.55
-045
1.01 A.
147.24
-044
2.23A.
318.60
294.55
-003
-051
.65A.
.57A
330
300
96.73
643.18
313.18
588.18
102
55
-004
2.00A.
723.66
148.67
-006
148.67
18A.
737.06
-005
2.01A.
749.14
DEWHURST
125
125