12-1-87 Cf

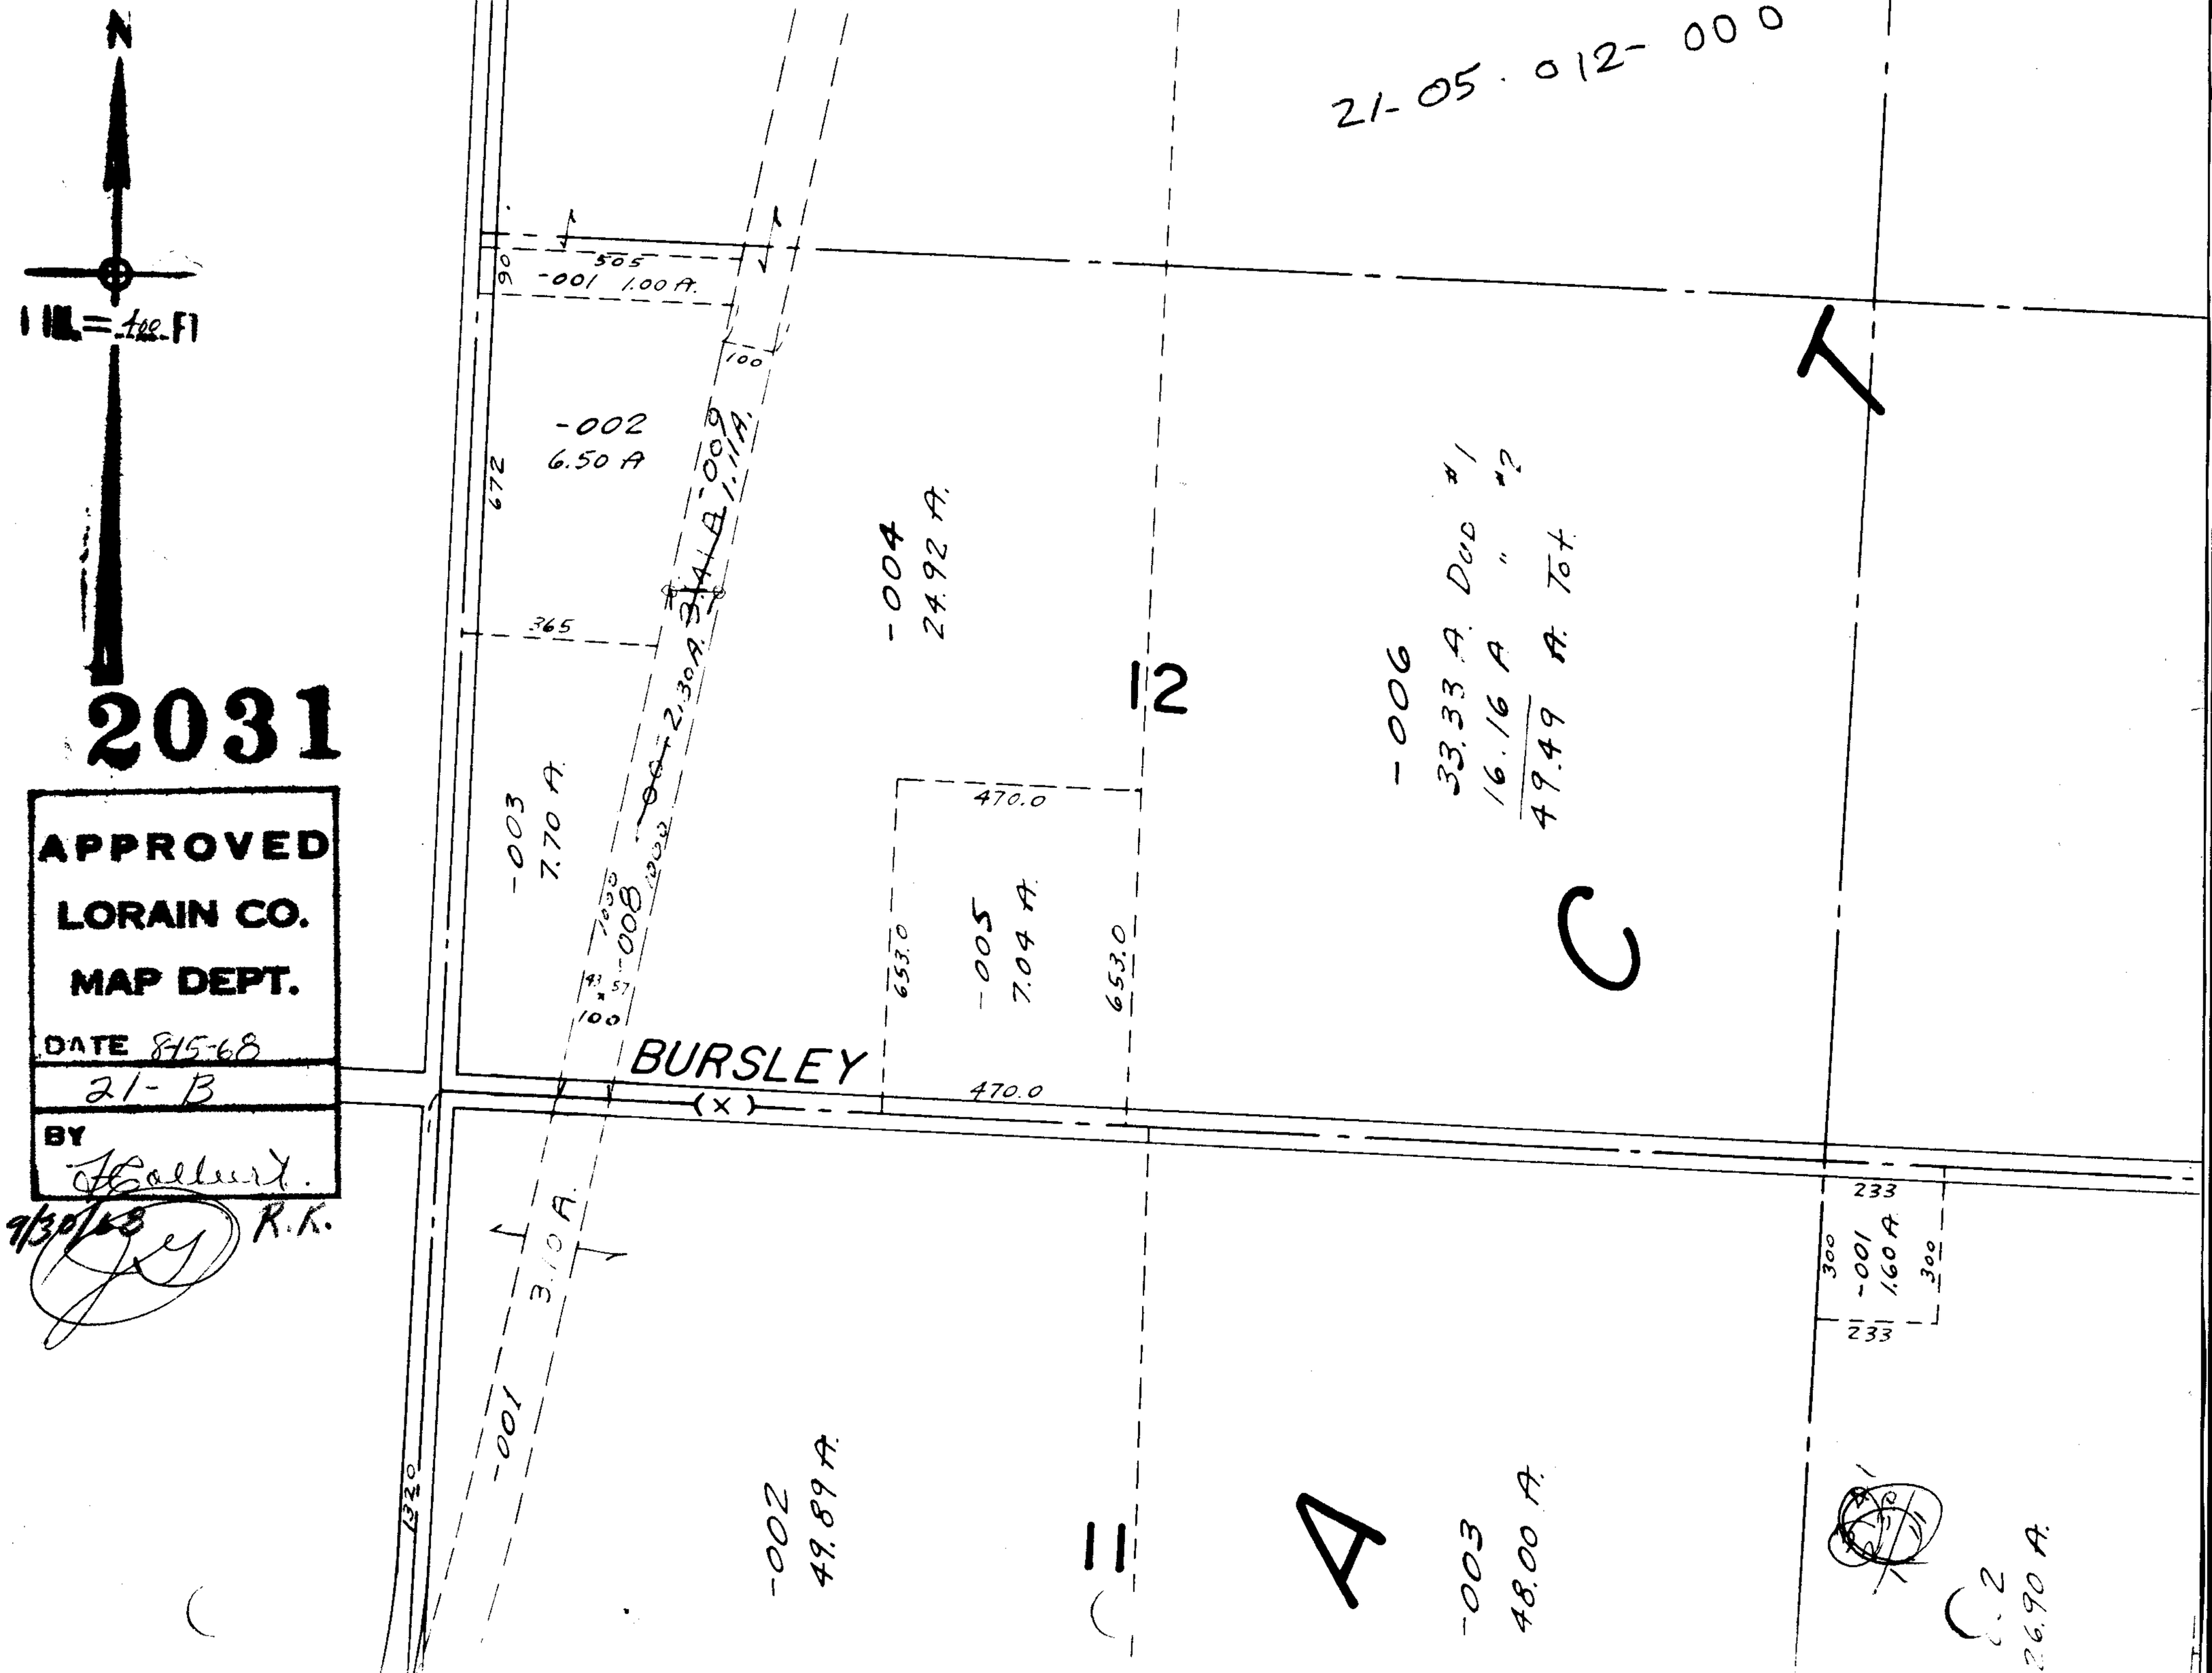

2031

APPROVED
LORAIN CO.
MAP DEPT.
DATE 8-15-68
21-B
BY
9/30/68 R.K.