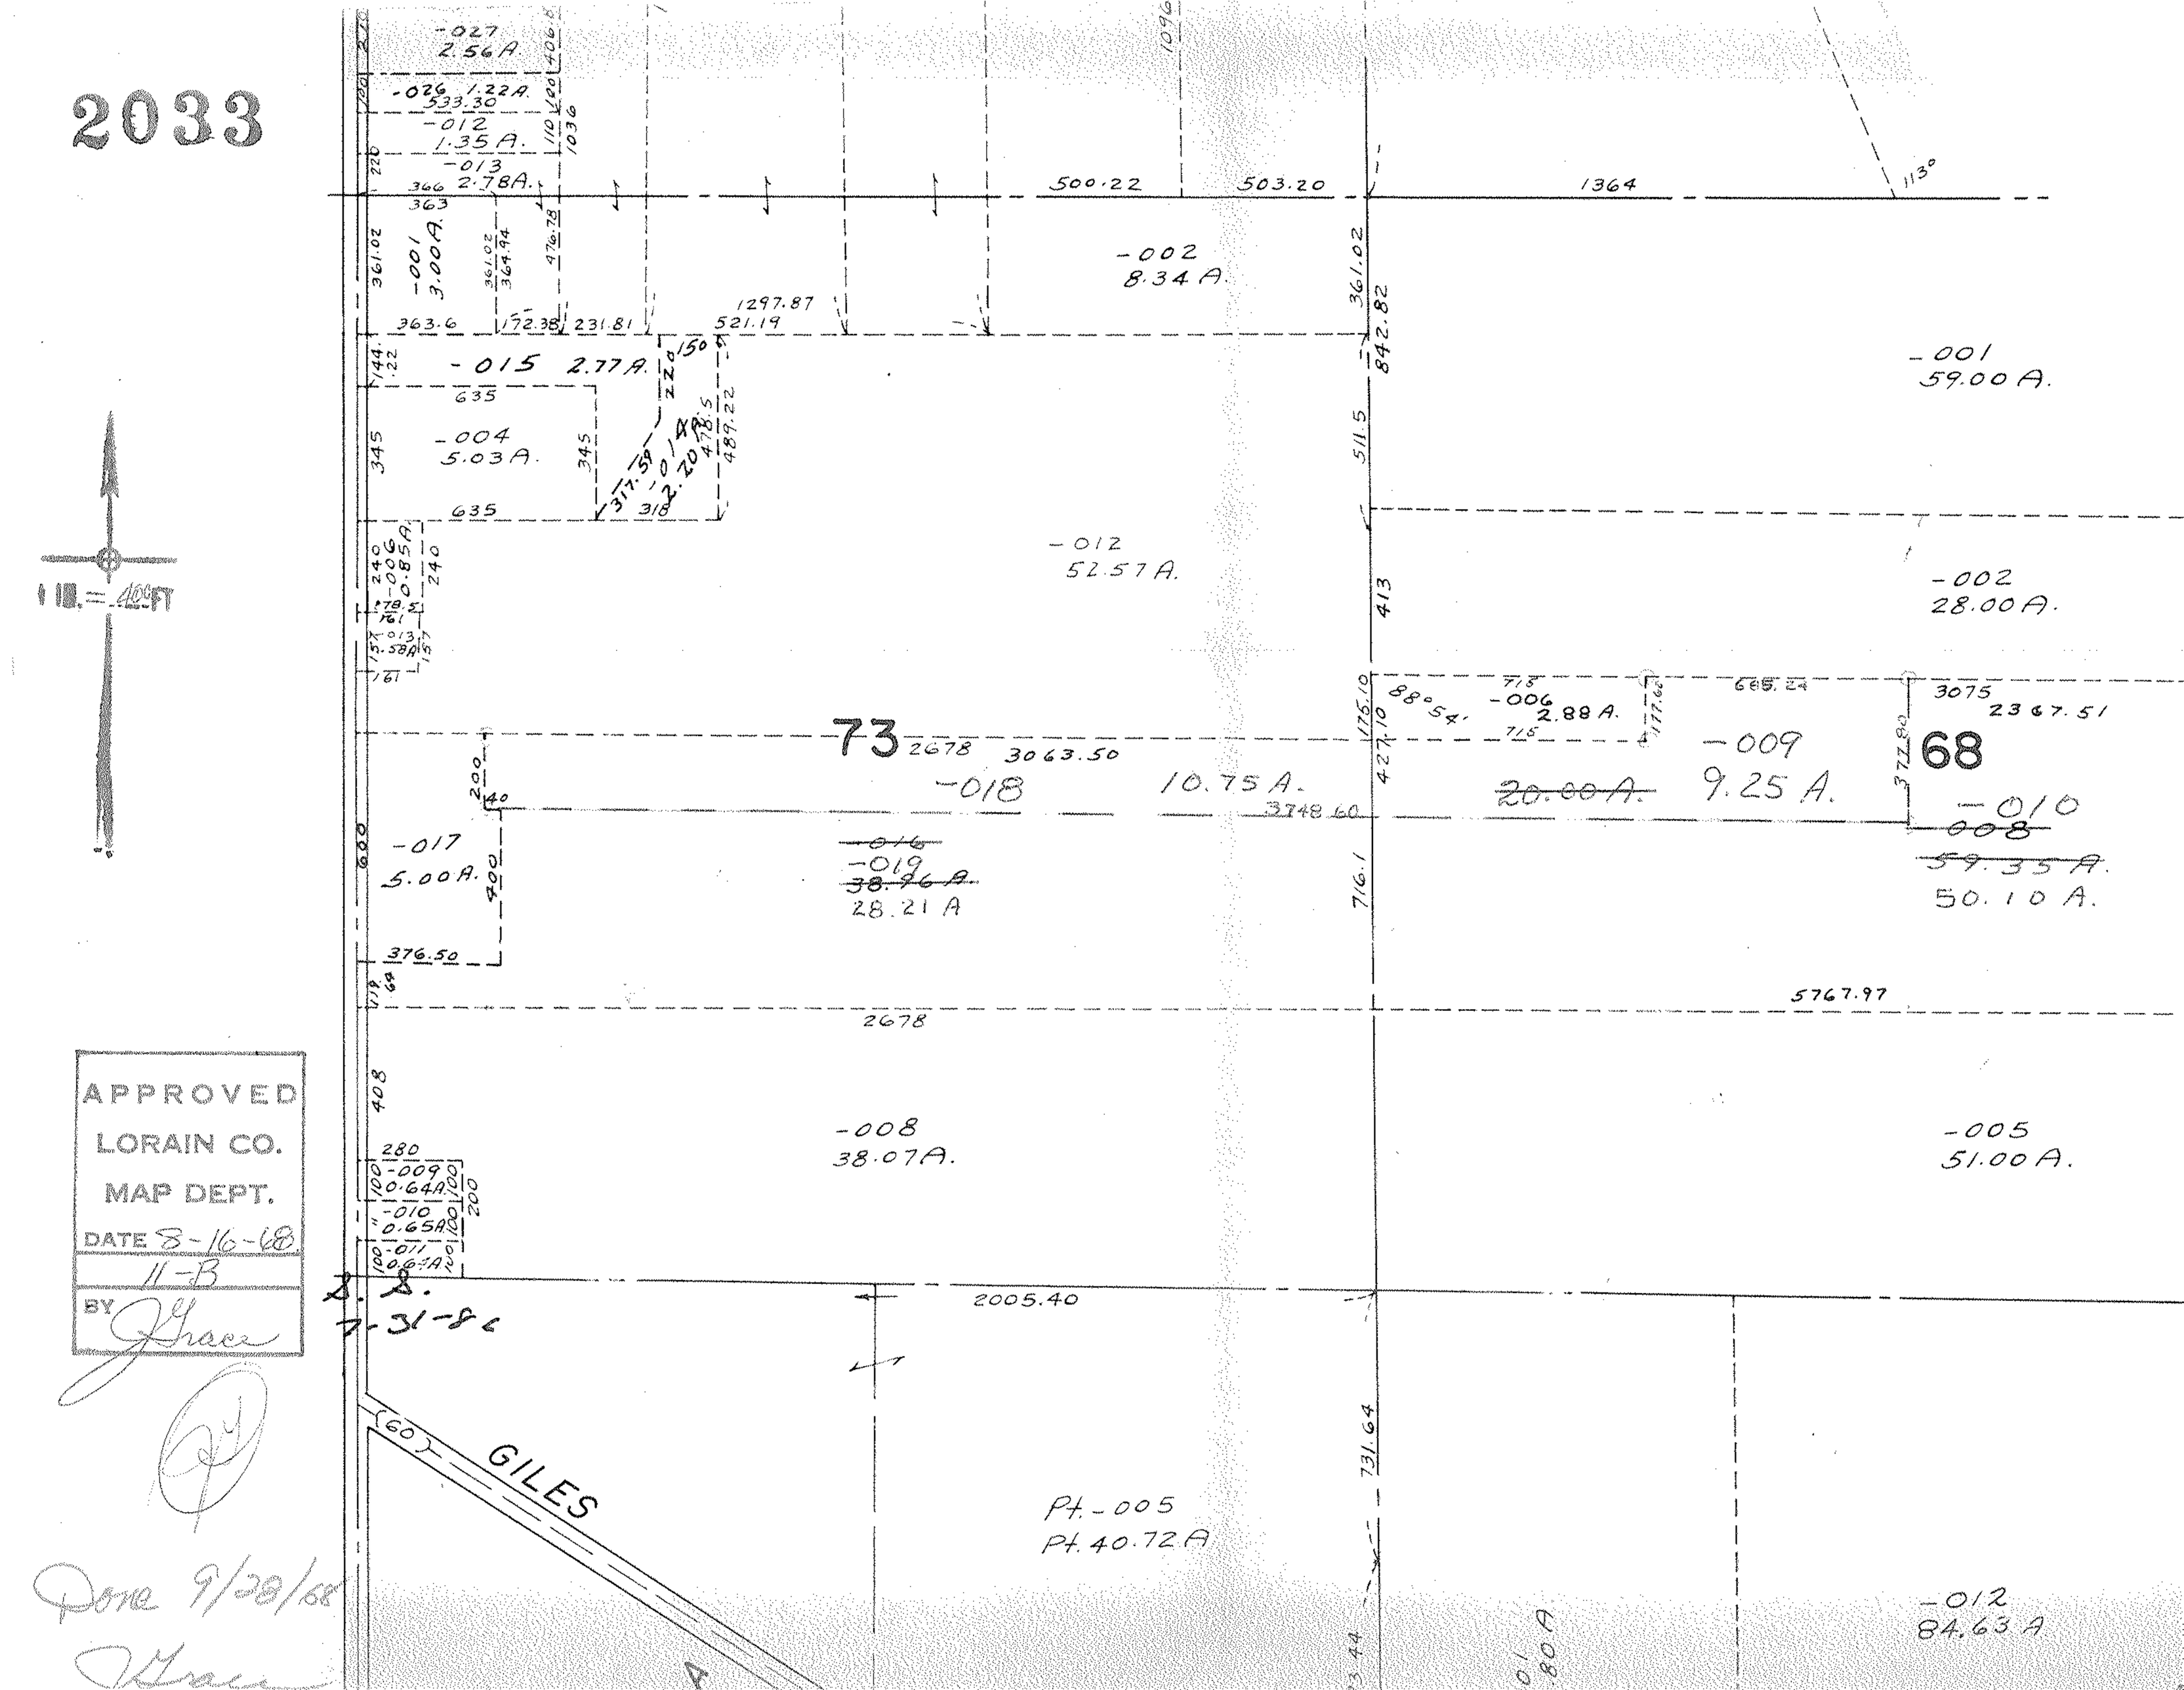
2033
-027
2.56A.
-026 1.22A.
533.30
-012
1.35A.
-013
2.78A.
366
363
500.22
503.20
1364
113°
-001
3.00A.
361.02
363.6
172.38
231.81
1297.87
521.19
-002
8.34A.
842.82
-015 2.77A.
635
-004
5.03A.
345
-014
2.20A.
489.22
-001
59.00A.
511.5
-012
52.57A.
413
-002
28.00A.
-006
0.85A.
240
73
2678
3063.50
-018
10.75A.
3748.60
88°54'
-006
2.88A.
-009
9.25A.
20.00A.
3075
2367.51
68
-010
-008
59.35A.
50.10A.
-017
5.00A.
400
376.50
-016
-019
38.96A.
28.21A
716.1
5767.97
2678
-008
38.07A.
-005
51.00A.
280
-009
0.64A.
-010
0.65A.
-011
0.64A.
2005.40
GILES
(60)
Pt.-005
Pt.40.72A
731.64
-012
84.63A
APPROVED
LORAIN CO.
MAP DEPT.
DATE 8-16-68
11-B
BY J Grace
Done 9/28/68
J Grace