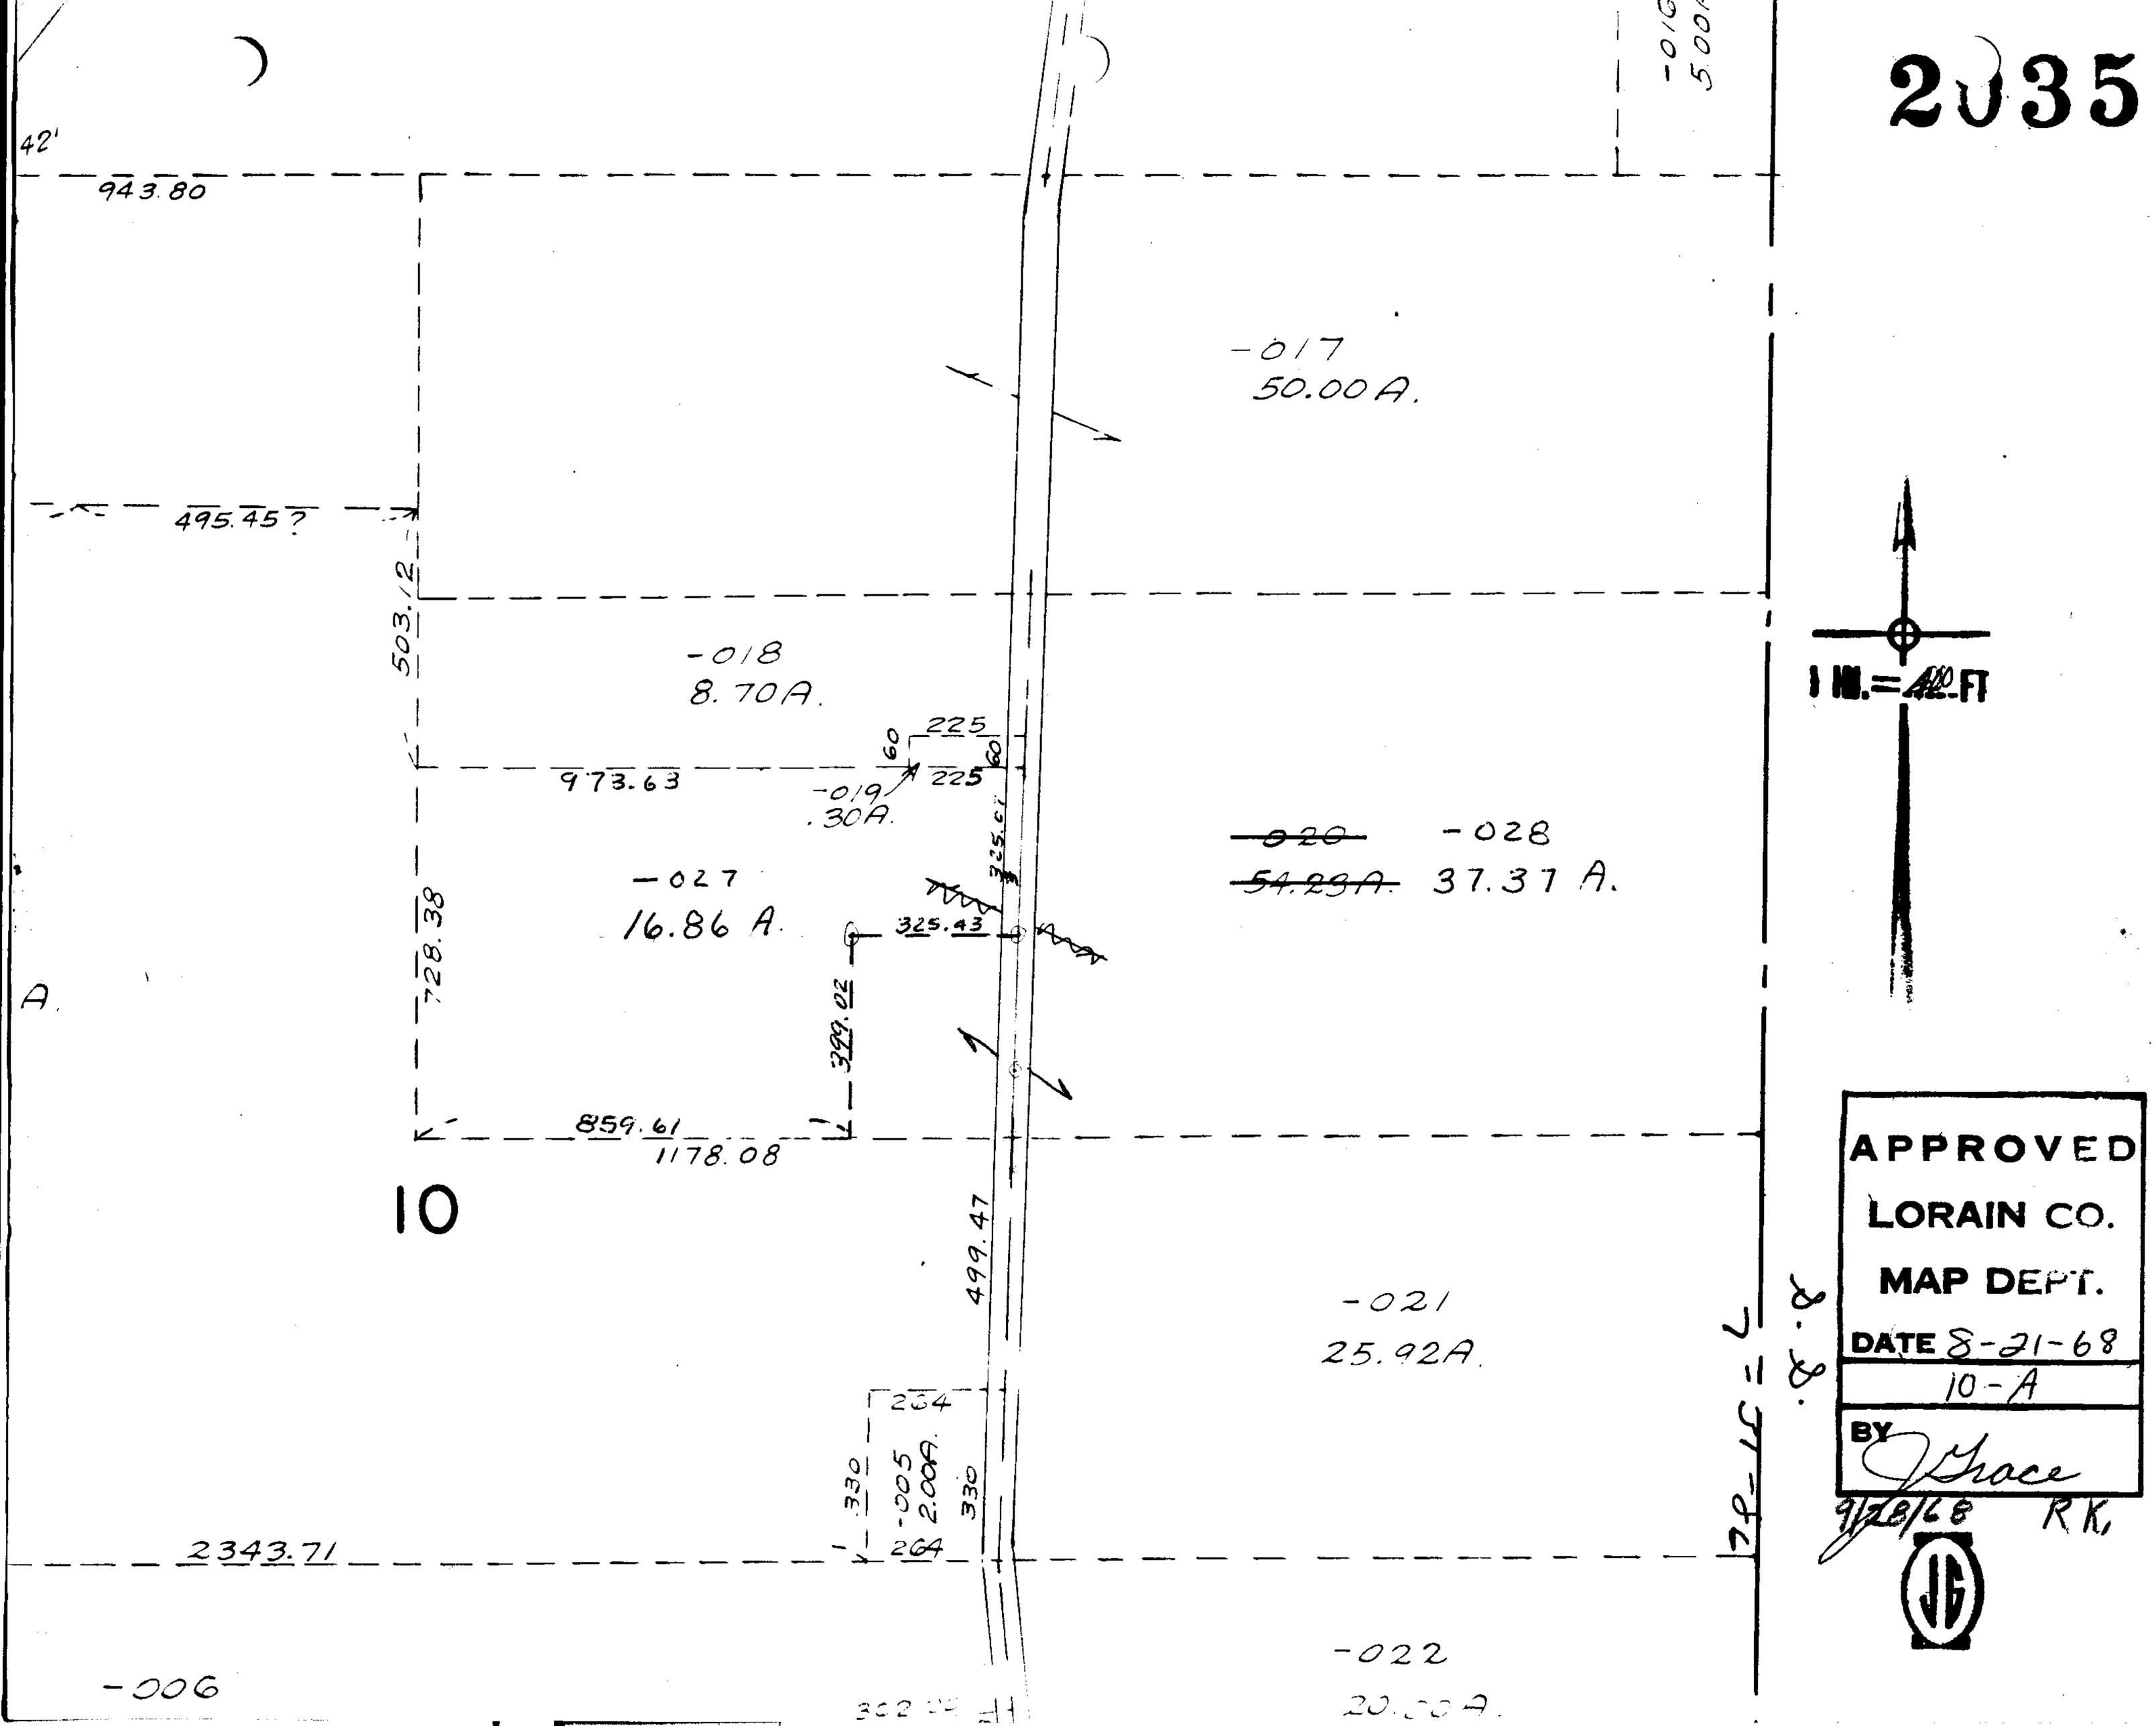
2035
42'
943.80
495.45?
503.12
-017
50.00A.
-018
8.70A.
225
60
60
225
973.63
-019
.30A.
325.43
-027
16.86 A.
728.38
399.02
859.61
1178.08
10
499.47
-020
54.23A.
-028
37.37 A.
-021
25.92A.
264
330
-005
2.00A.
330
264
2343.71
-006
-022
20.00A.
1 IN.=400 FT
APPROVED
LORAIN CO.
MAP DEPT.
DATE 8-21-68
10-A
BY J Grace
9/28/68 RK,