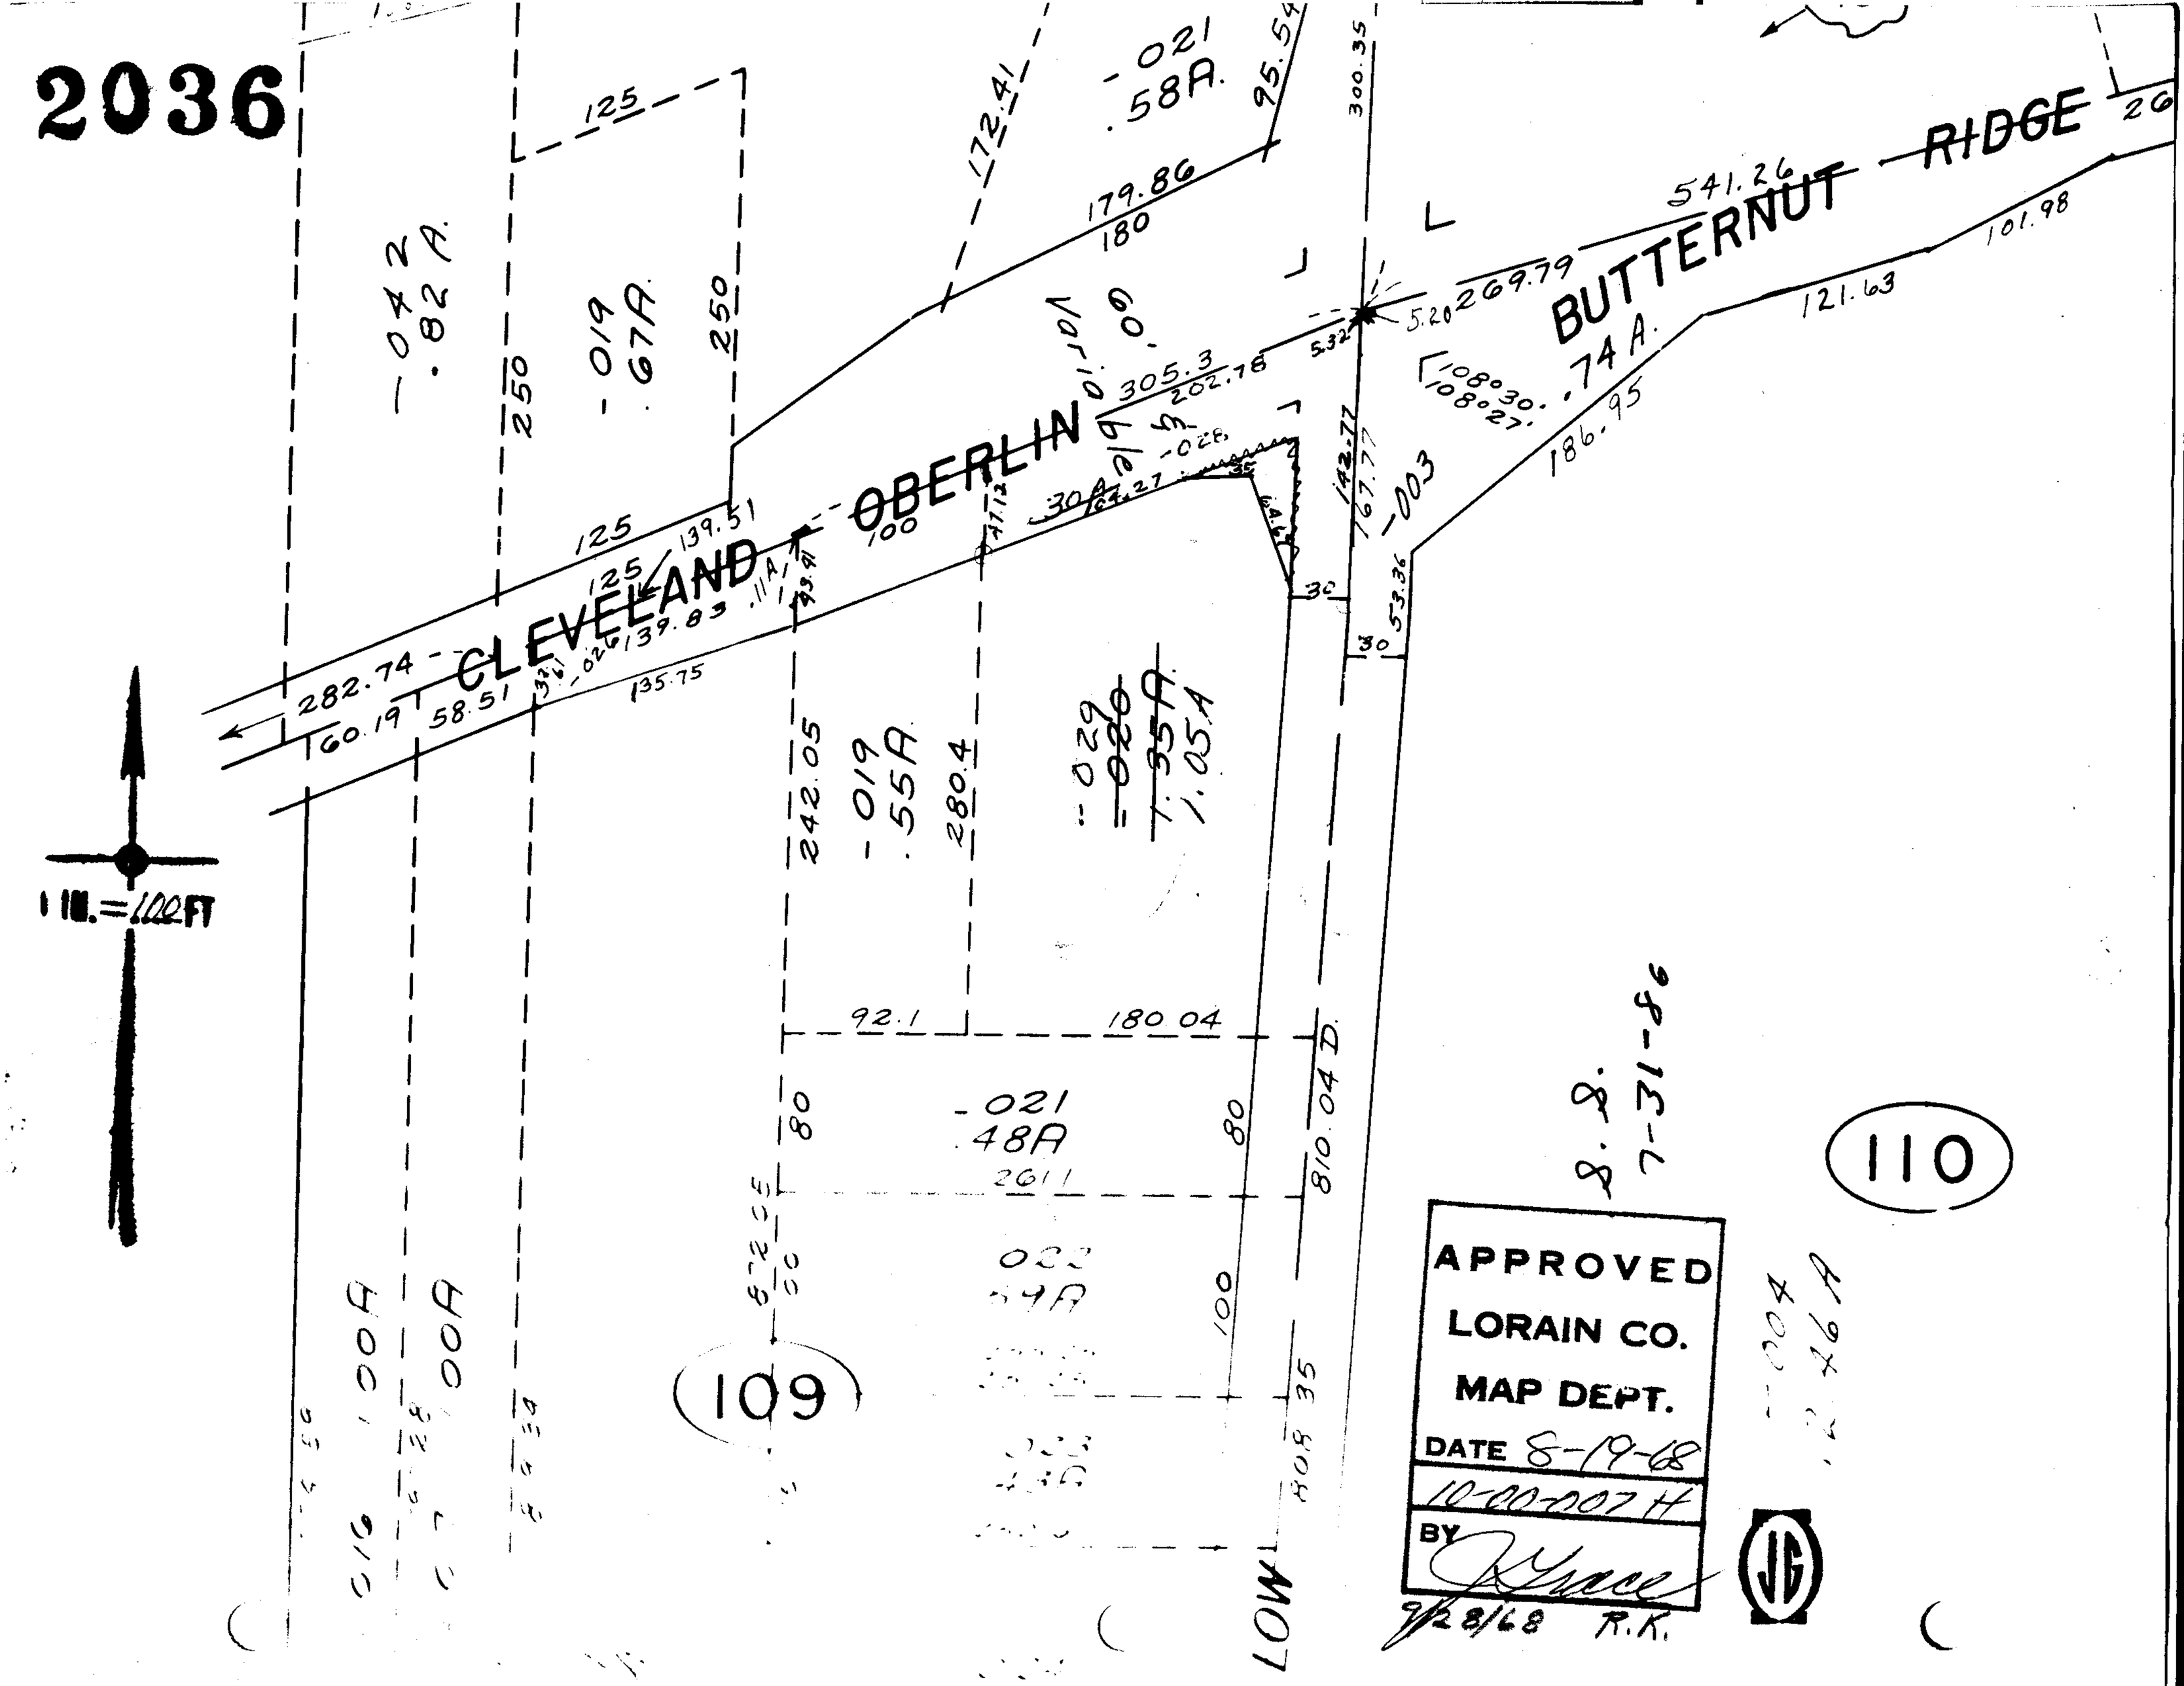
2036
CLEVELAND - OBERLIN
BUTTERNUT RIDGE
1 IN. = 100 FT
109
110
LOW
APPROVED
LORAIN CO.
MAP DEPT.
DATE 8-19-68
10-00-007 H
BY
9/28/68 R.K.
S.S. 7-31-86