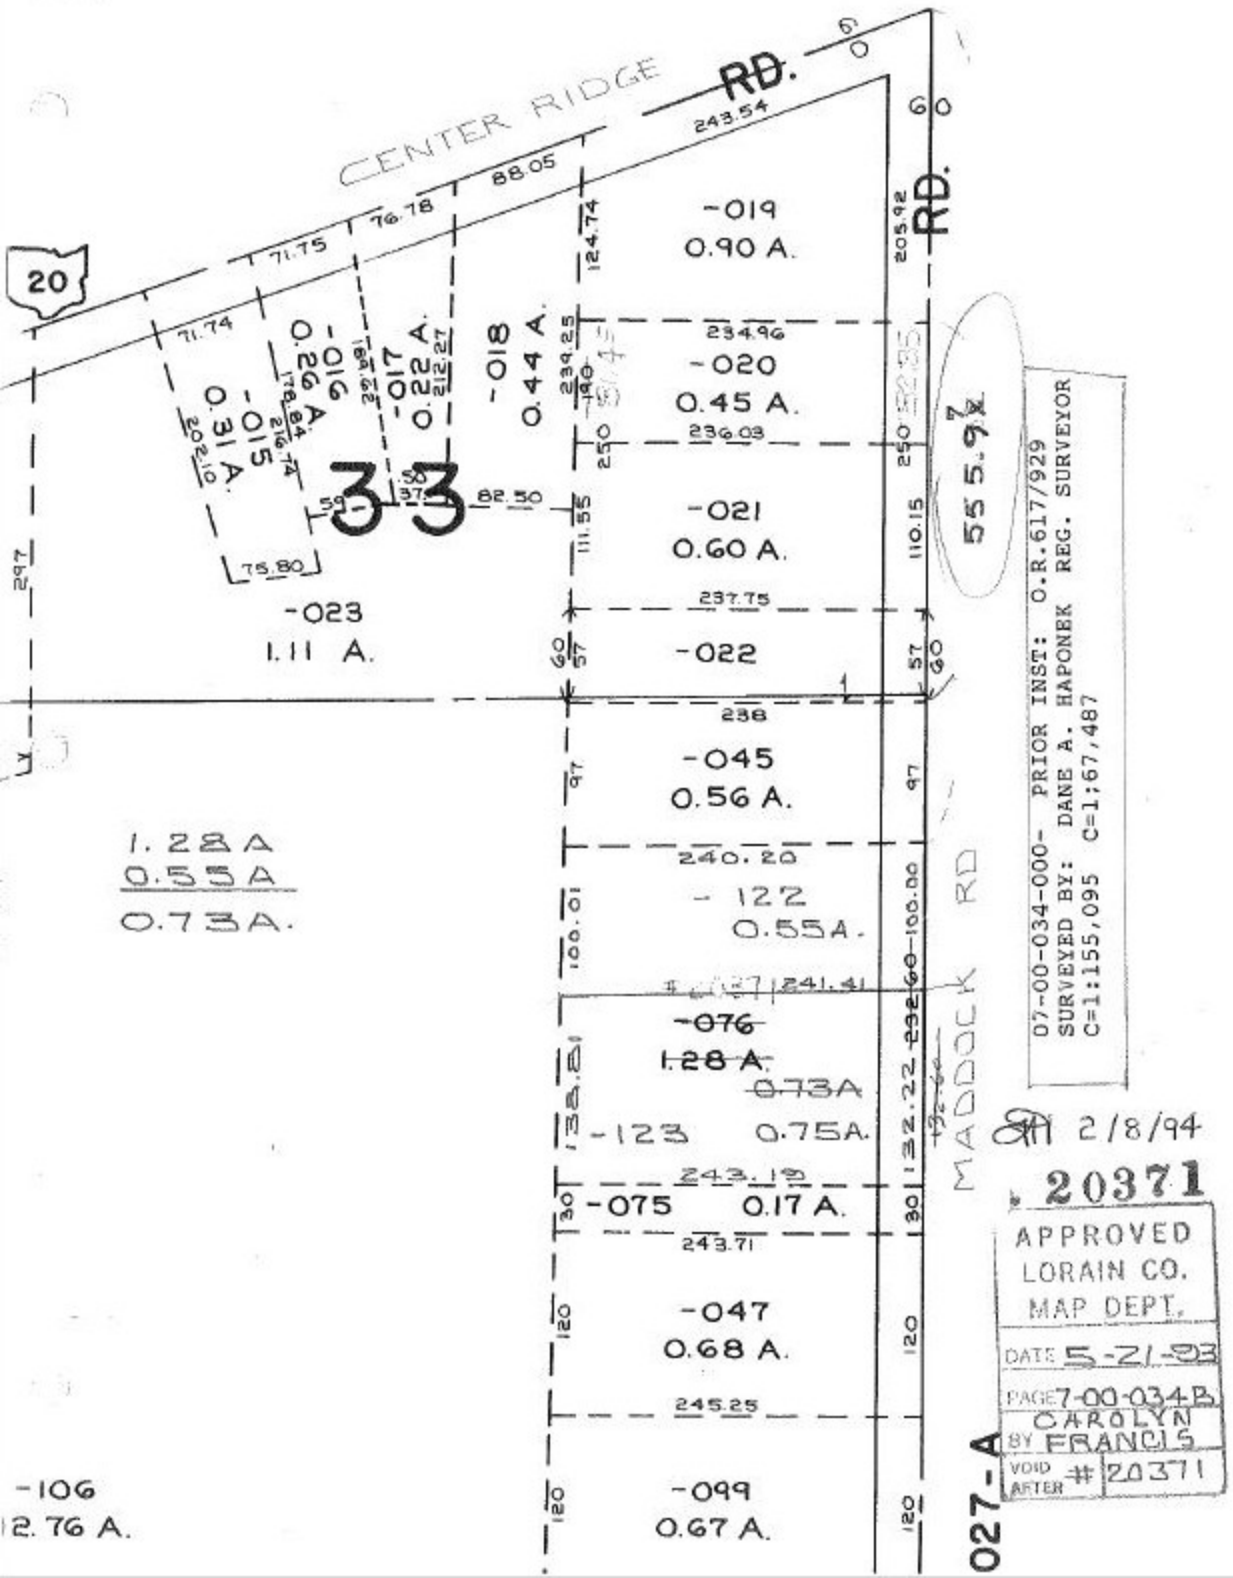
CENTER RIDGE
RD.
20
RD.
MADDOCK RD
33
-019
0.90 A.
-020
0.45 A.
-021
0.60 A.
-022
-023
1.11 A.
-045
0.56 A.
-122
0.55A.
-076
1.28 A.
0.73A
-123
0.75A.
-075
0.17 A.
-047
0.68 A.
-099
0.67 A.
-015
0.31 A.
-016
0.26 A.
-017
0.22 A.
-018
0.44 A.
1.28A
0.55A
0.73A.
-106
12.76 A.
555.97
07-00-034-000- PRIOR INST: O.R.617/929
SURVEYED BY: DANE A. HAPONEK REG. SURVEYOR
C=1:155,095 C=1;67,487
2/8/94
20371
APPROVED
LORAIN CO.
MAP DEPT.
DATE 5-21-93
PAGE 7-00-034B
BY CAROLYN FRANCIS
VOID AFTER # 20371
027-A