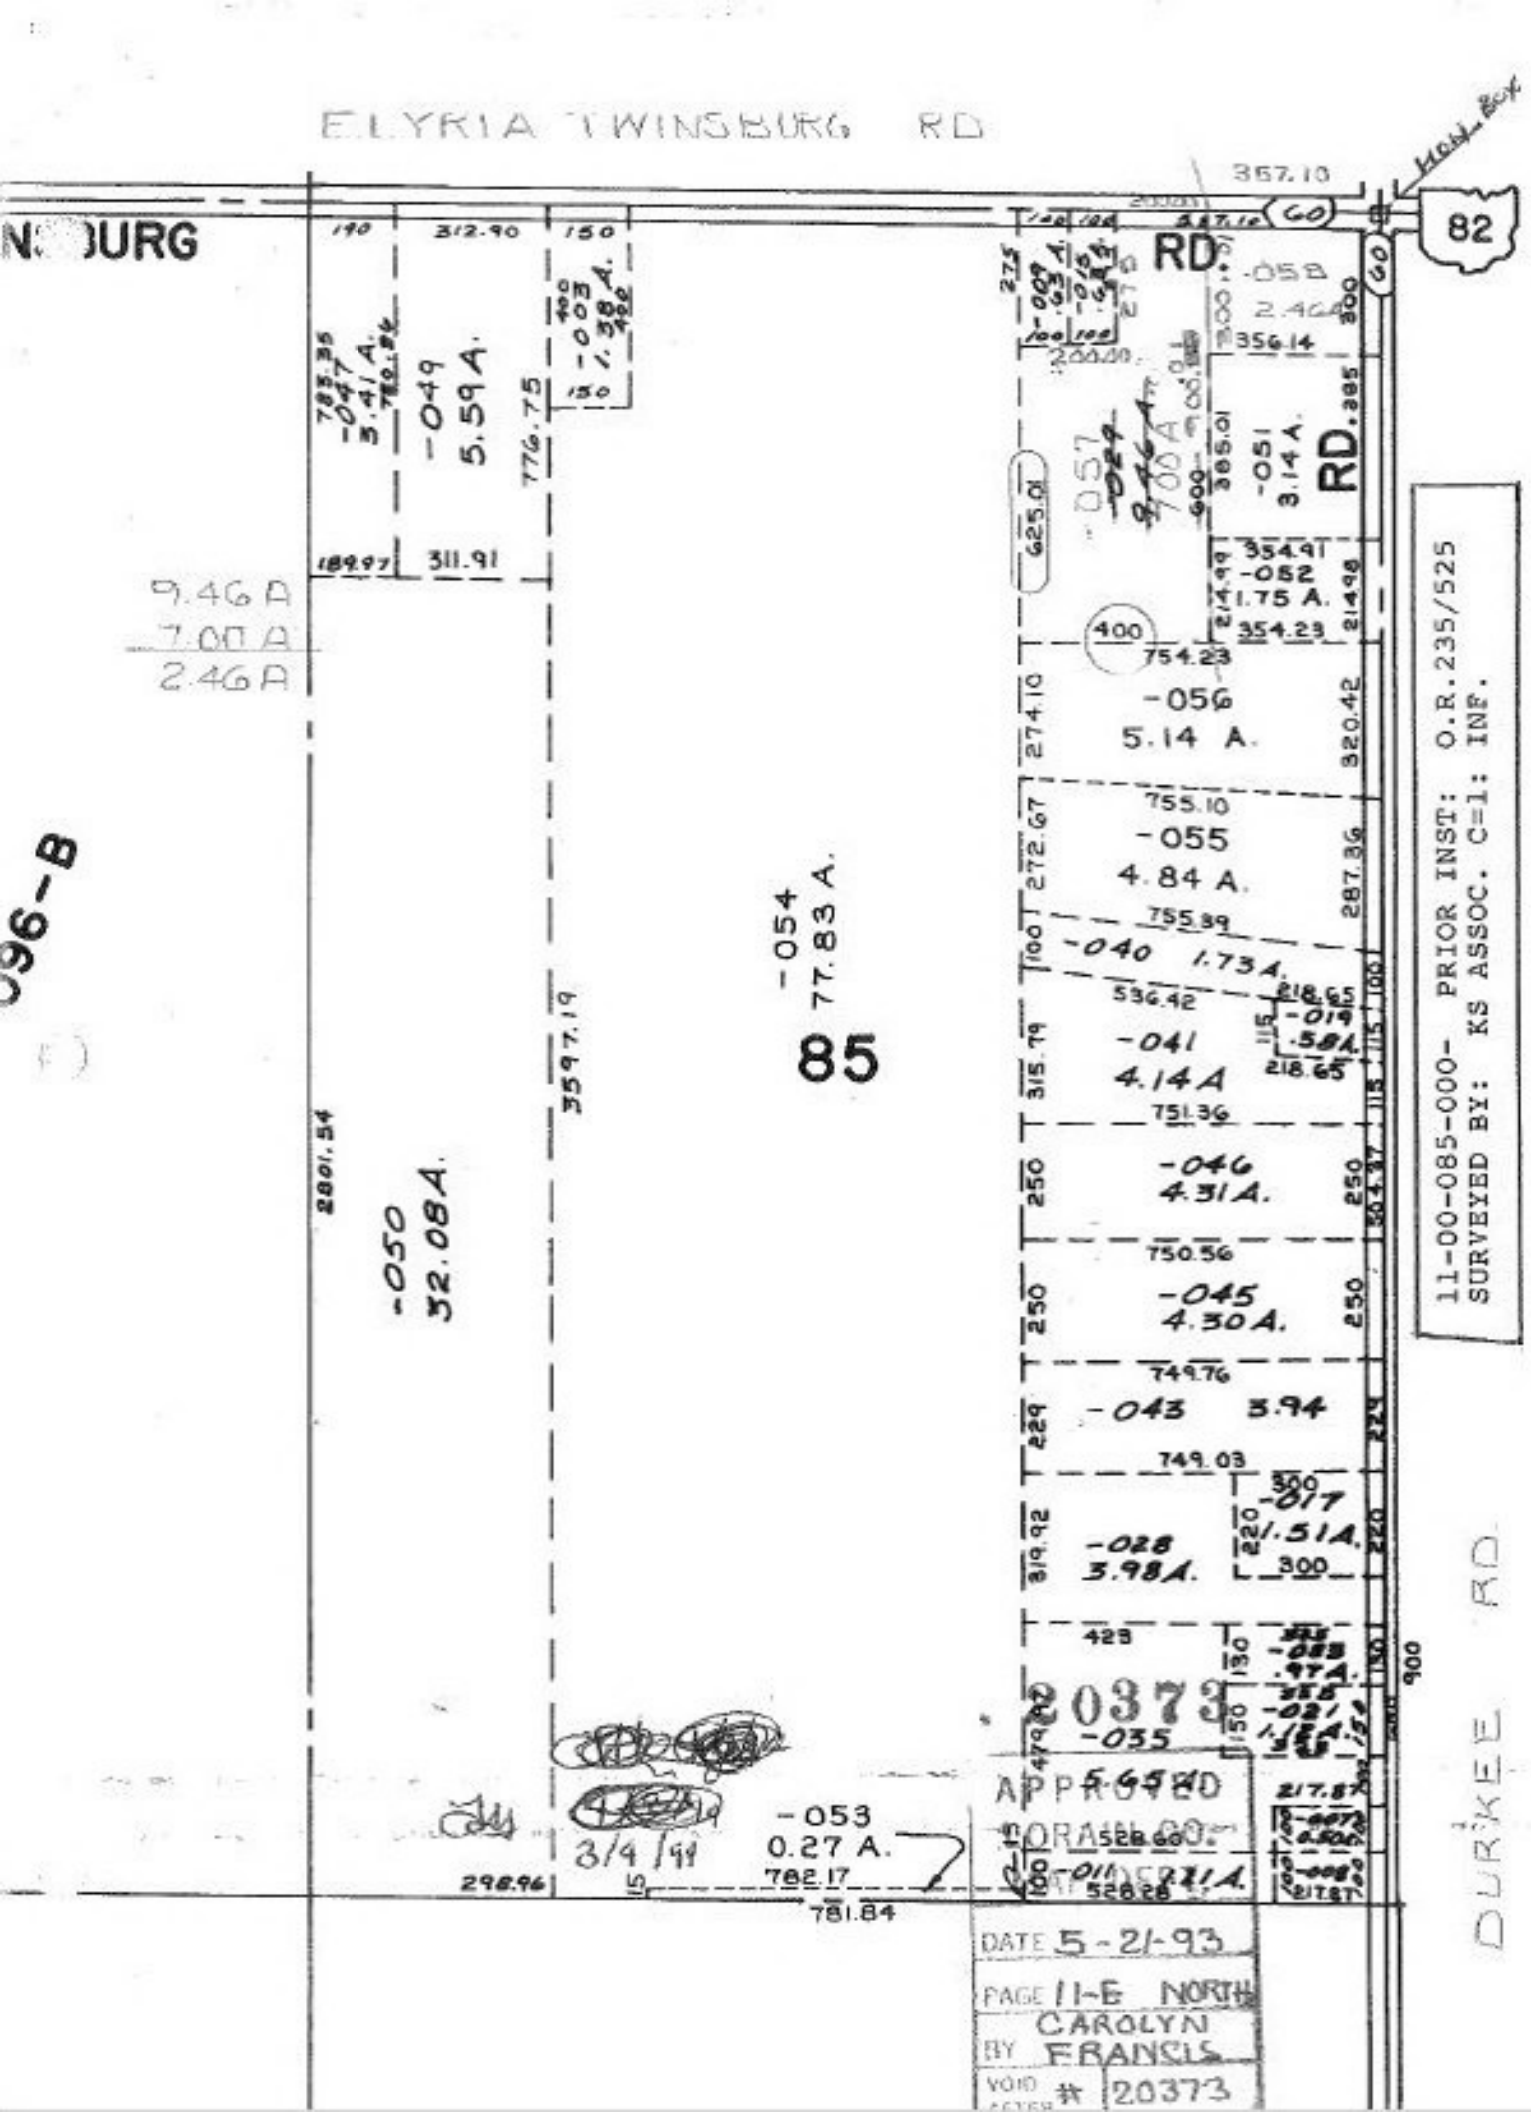
ELYRIA TWINSBURG RD.
N. DURG
RD.
82
-058
2.40A.
-057
7.00A.
-029
2.46A.
-051
3.14 A.
-052
1.75 A.
-056
5.14 A.
-055
4.84 A.
-040
1.73A.
-041
4.14A
-046
4.31A.
-045
4.30A.
-043
3.94
-028
3.98A.
-017
1.51A.
-035
5.65AC.
-053
0.27 A.
-054
77.83 A.
85
-050
32.08A.
-049
5.59A.
-047
3.41A.
-003
1.38A.
9.46 A
7.00 A
2.46 A
11-00-085-000- PRIOR INST: O.R.235/525
SURVEYED BY: KS ASSOC. C=1: INF.
APPROVED
FOR ASSESSMENT
DATE 5-21-93
PAGE 11-E NORTH
BY CAROLYN FRANCIS
VOID AFTER # 20373
3/4/99
DURKEE RD.