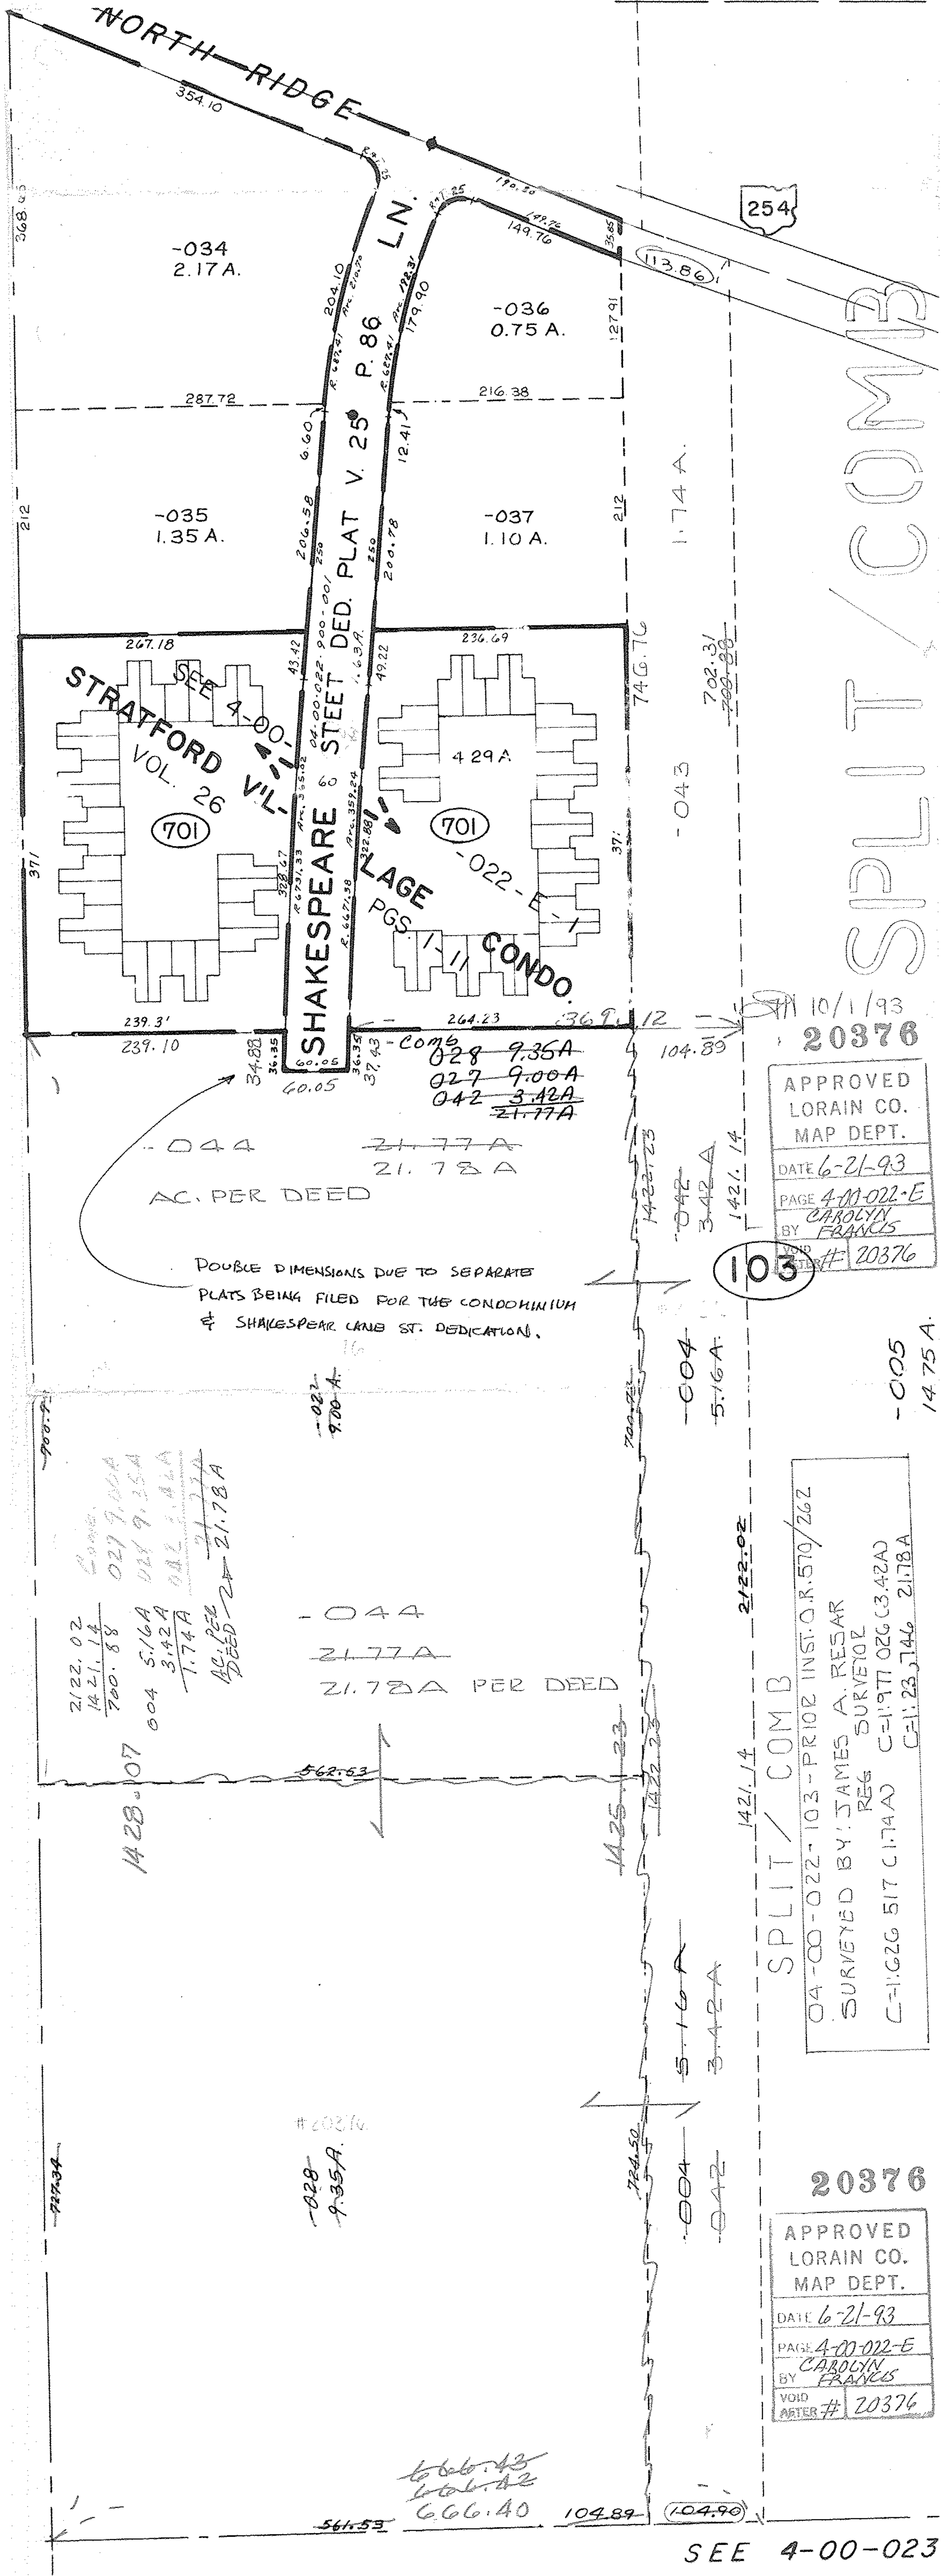
NORTH RIDGE
254
-034
2.17 A.
-036
0.75 A.
-035
1.35 A.
-037
1.10 A.
SHAKESPEARE STEET DED. PLAT V. 25 P. 86 LN.
STRATFORD VIL-LAGE CONDO.
VOL. 26
SEE 4-00-
701
701
-022-E-1
PGS. 1-11
429 A
-043
1.74 A.
SPLIT / COMB
10/1/93
20376
APPROVED
LORAIN CO.
MAP DEPT.
DATE 6-21-93
PAGE 4-00-022-E
BY CAROLYN FRANCIS
VOID AFTER # 20376
-044
21.77 A
21.78 A
AC. PER DEED
DOUBLE DIMENSIONS DUE TO SEPARATE PLATS BEING FILED FOR THE CONDOMINIUM & SHAKESPEAR LANE ST. DEDICATION.
103
-004
5.16 A.
-005
14.75 A.
-044
21.77 A
21.78 A PER DEED
SPLIT / COMB
04-00-022-103-PRIOR INST. O.R. 570/262
SURVEYED BY: JAMES A. RESAR
REG SURVEYOR
C=1:626 517 (1.74 A)
C=1:977 026 (3.42 A)
C=1:23,746 21.78 A
20376
APPROVED
LORAIN CO.
MAP DEPT.
DATE 6-21-93
PAGE 4-00-022-E
BY CAROLYN FRANCIS
VOID AFTER # 20376
666.40
104.89
104.90
SEE 4-00-023