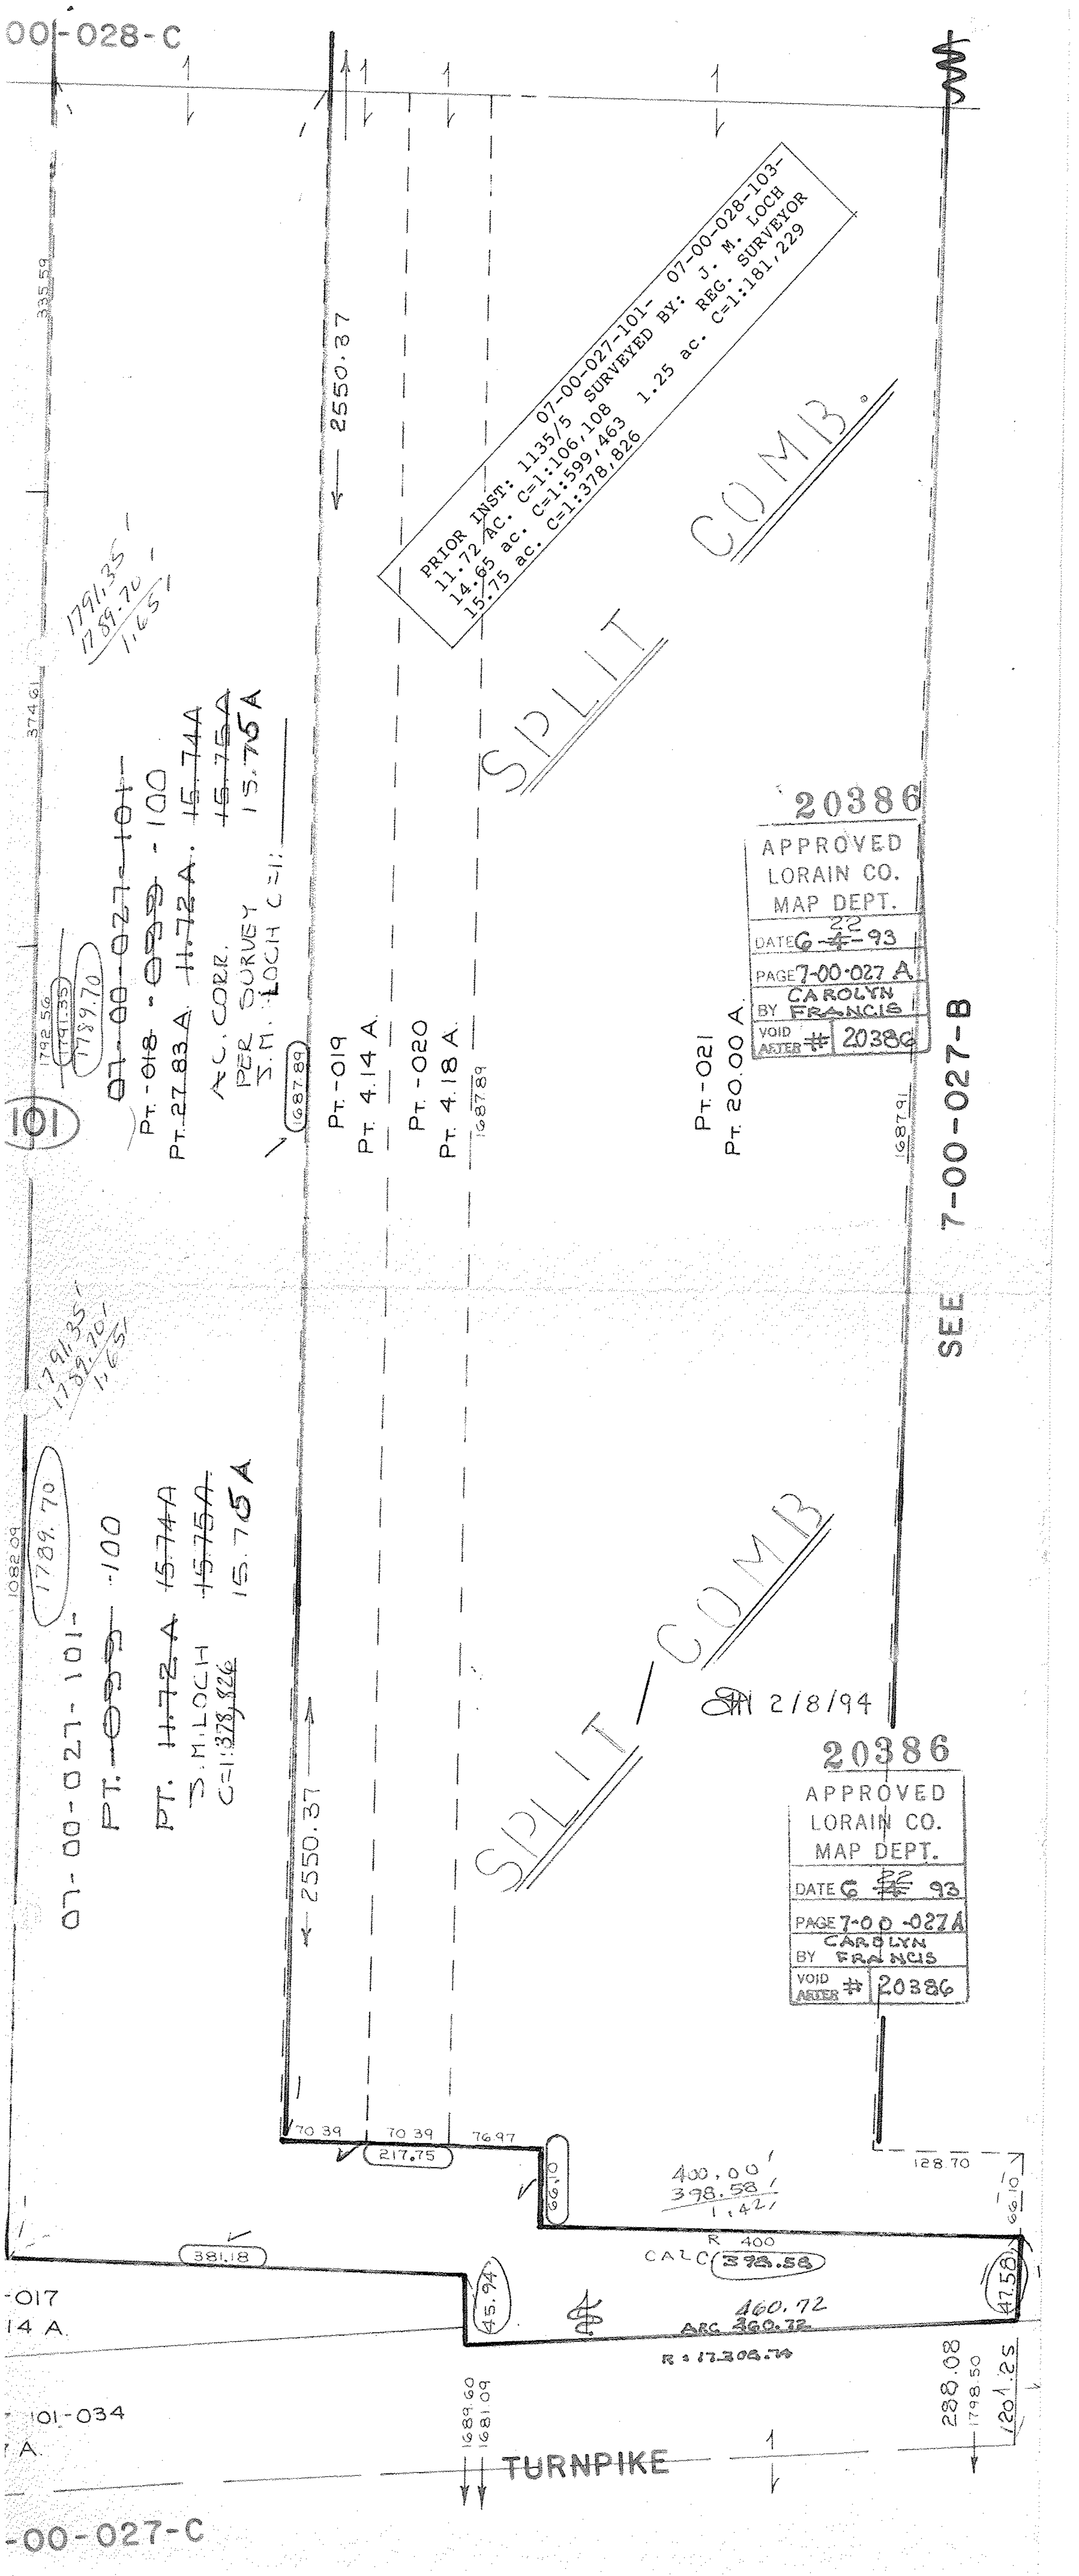
00-028-C
PRIOR INST: 1135/5 07-00-027-101- 07-00-028-103-
11.72 AC. C=1:106,108 SURVEYED BY: J. M. LOCH
14.65 ac. C=1:599,463 1.25 ac. C=1:181/229
15.75 ac. C=1:378,826 REG. SURVEYOR
2550.37
COMB.
SPLIT
335.59
1791.35'
1789.70'
1,651'
374.61
07-00-027-101-
PT. -035 -100
PT. 11.72 A. 15.74 A
S.M. LOCH C=1:378,826 15.75 A
792.56
1791.35
1789.70
101
PT.-018 - 035 - 100
PT. 27.83 A. 11.72 A. 15.74 A
15.75 A
A.C. COR.
PER SURVEY
S.M. LOCH C=1:
687.89
PT.-019
PT. 4.14 A.
PT.-020
PT. 4.18 A.
687.89
20386
APPROVED
LORAIN CO.
MAP DEPT.
DATE 6-22-93
PAGE 7-00-027 A
BY CAROLYN FRANCIS
VOID AFTER # 20386
PT.-021
PT. 20.00 A.
687.91
SEE 7-00-027-B
1791.35'
1789.70'
1,651'
1082.09
07-00-027-101-
PT. -035 -100
PT. 11.72 A. 15.74 A
S.M. LOCH 15.75 A
C=1:378,826
1789.70
2550.37
SPLIT
COMB
2/18/94
20386
APPROVED
LORAIN CO.
MAP DEPT.
DATE 6-22-93
PAGE 7-00-027A
BY CAROLYN FRANCIS
VOID AFTER # 20386
70.39
70.39
76.97
217.75
66.10
400.00'
398.58'
1,421'
128.70
66.10
381.18
R 400
CALC 398.58
460.72
ARC 460.72
R = 17,209.74
45.94
47.58
-017
14 A.
101-034
A.
1989.60
1981.09
288.08
1798.50
1201.25
TURNPIKE
-00-027-C