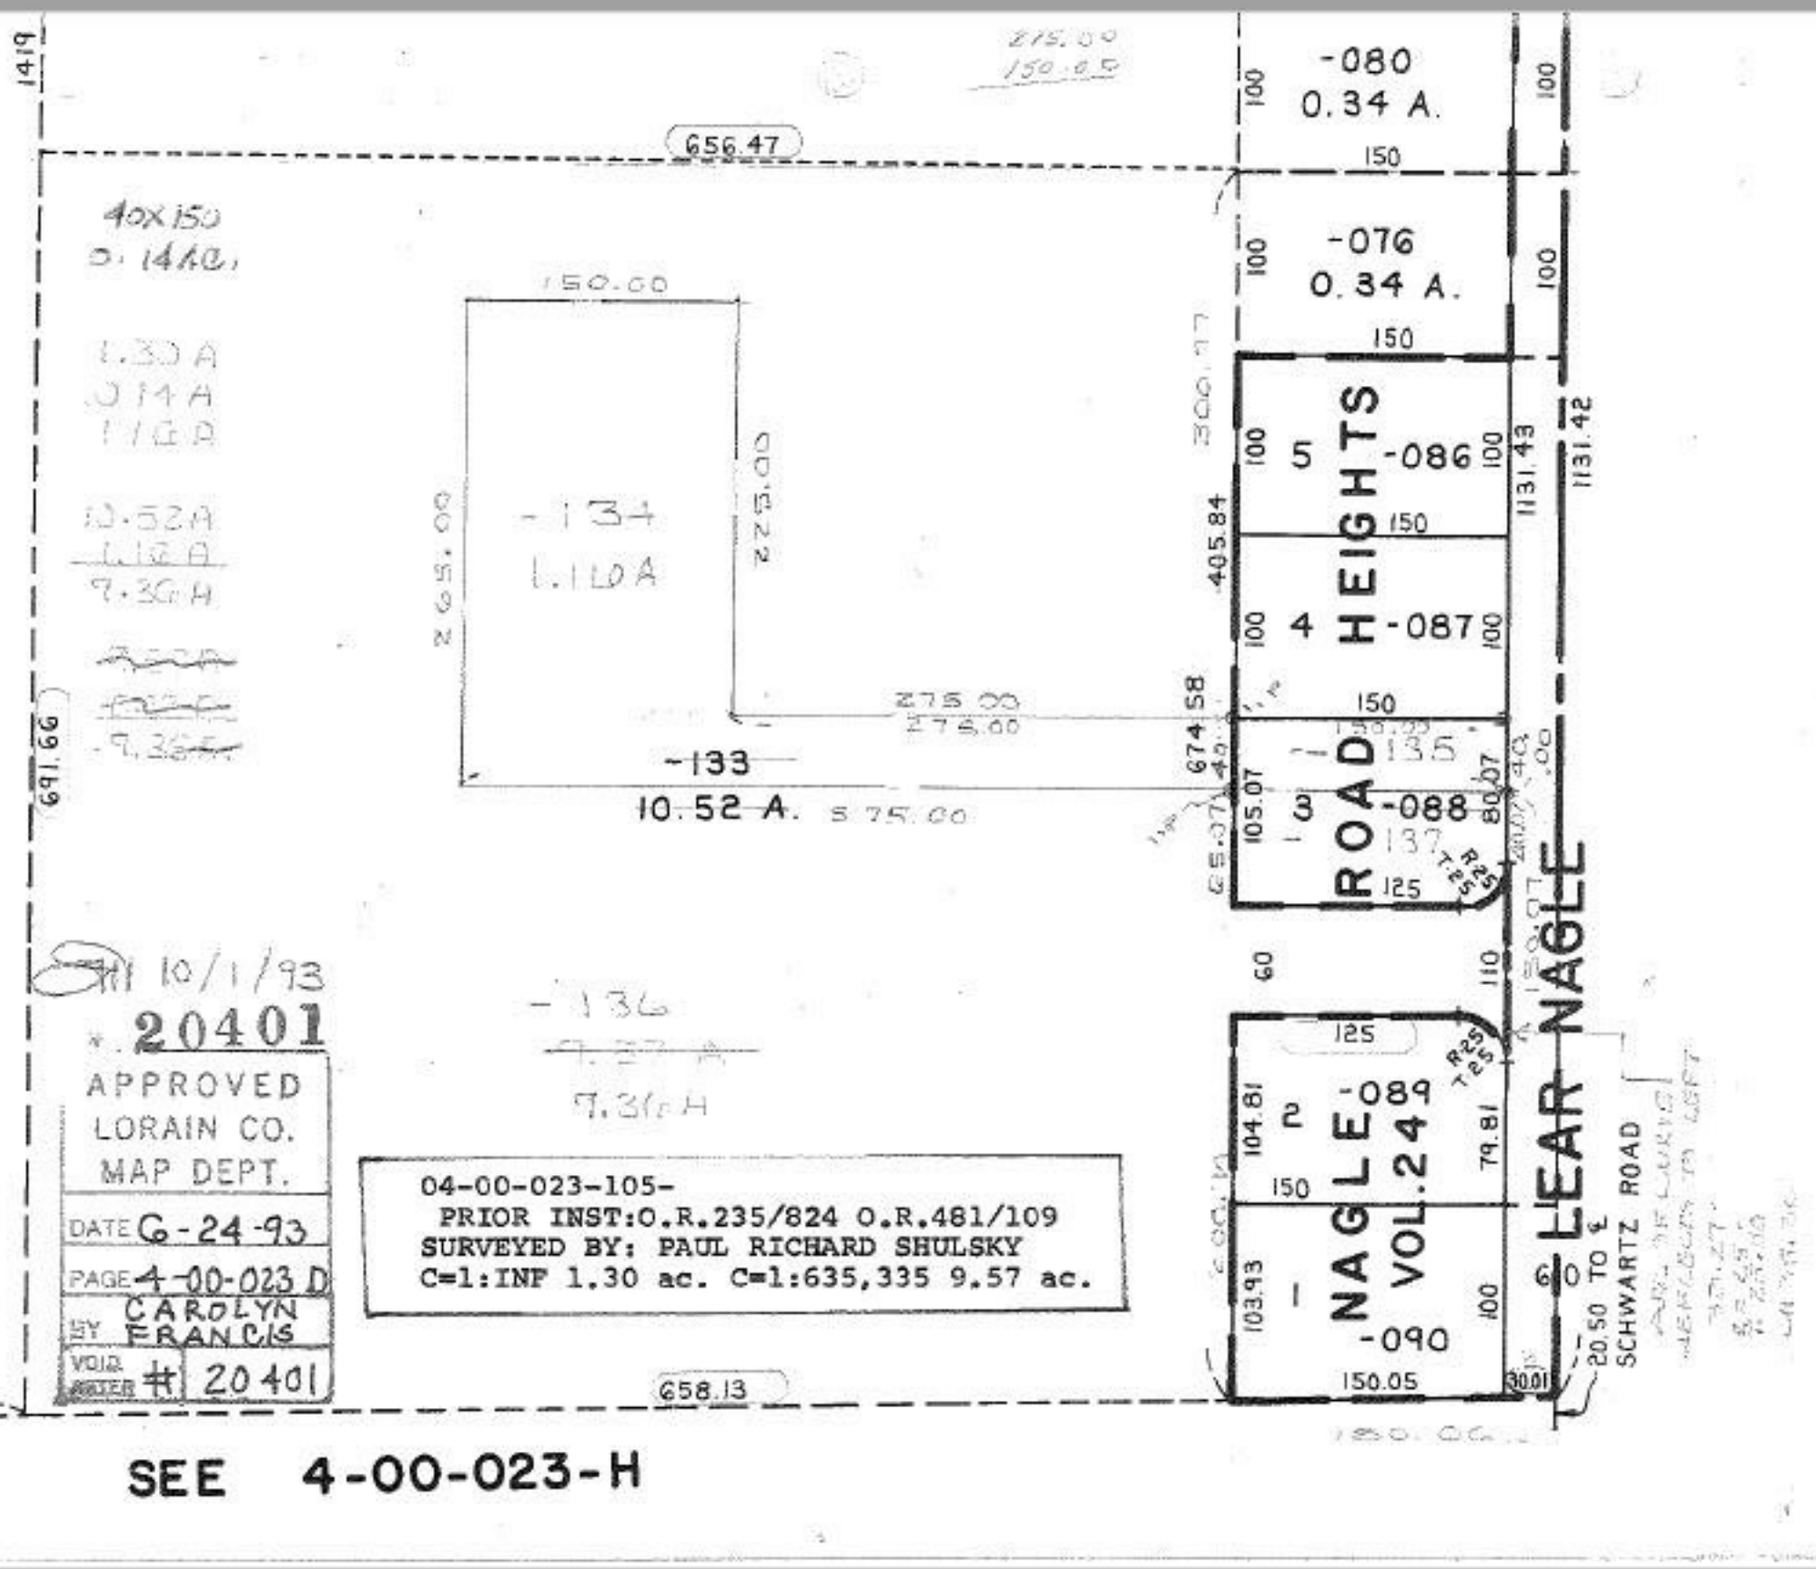

10/1/93

20401

APPROVED
LORAIN CO.
MAP DEPT.

DATE 6-24-93
PAGE 4-00-023 D
BY CAROLYN FRANCIS
VOID ENTER # 20401

04-00-023-105-
PRIOR INST:O.R.235/824 O.R.481/109
SURVEYED BY: PAUL RICHARD SHULSKY
C=1:INF 1.30 ac. C=1:635,335 9.57 ac.

SEE 4-00-023-H