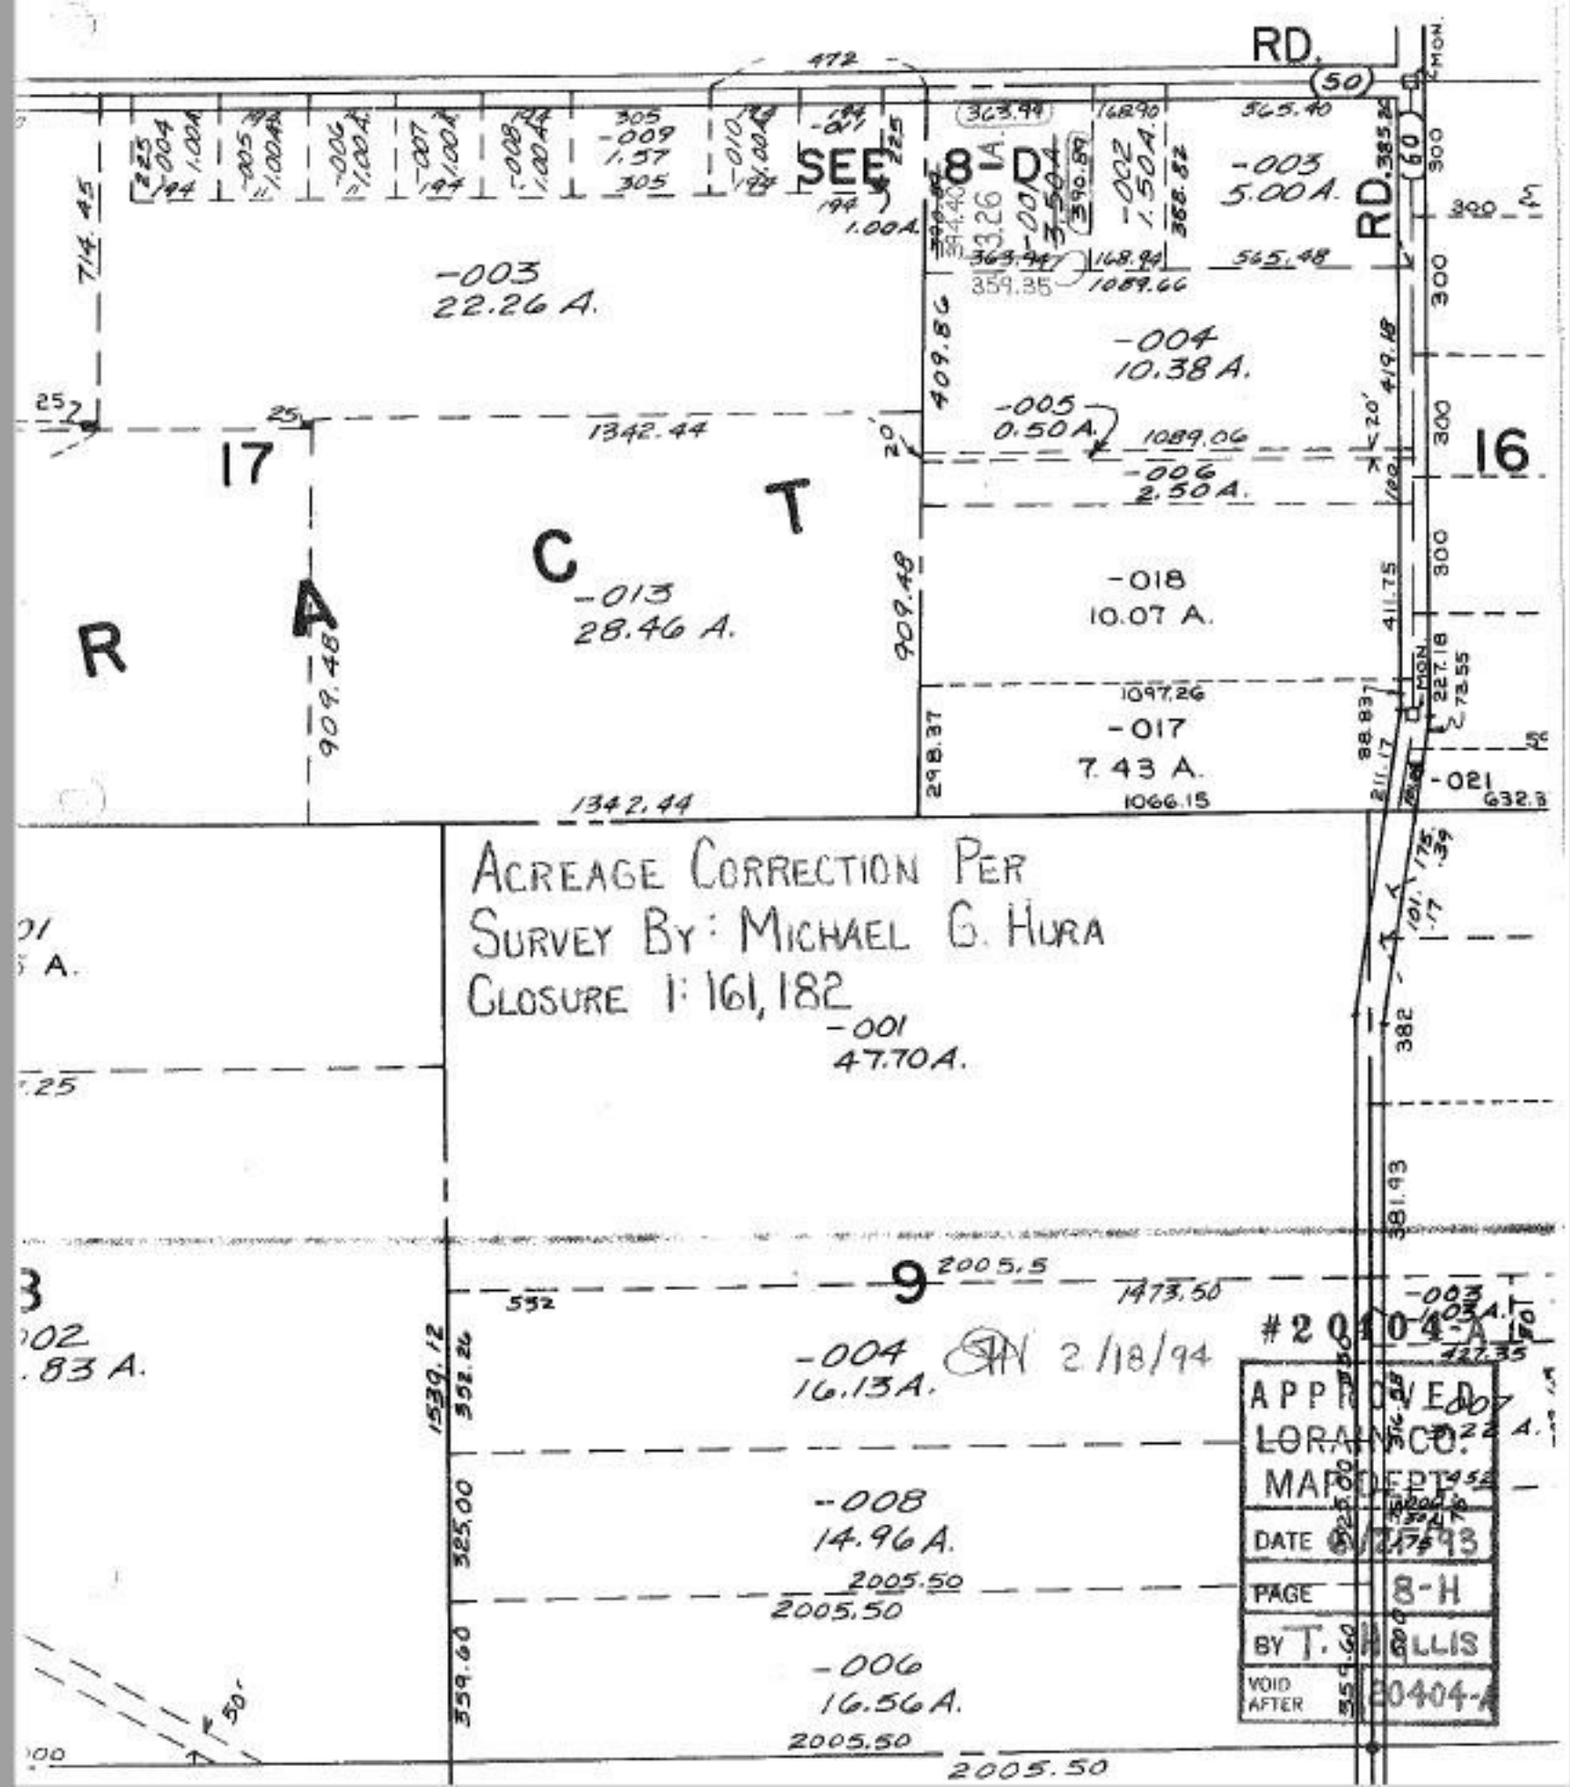

RD.
SEE 8-D
-003
22.26 A.
-004
10.38 A.
-005
0.50 A.
-006
2.50 A.
-003
5.00 A.
-018
10.07 A.
-017
7.43 A.
-013
28.46 A.
17
16
R
A
C
T
ACREAGE CORRECTION PER
SURVEY BY: MICHAEL G. HURA
CLOSURE 1: 161,182
-001
47.70 A.
9
-004
16.13 A.
-008
14.96 A.
-006
16.56 A.
2005.50
1342.44
909.48
1473.50
#20404-A
APPROVED
LORAIN CO.
MAP DEPT.
DATE
PAGE 8-H
BY T. HELLIS
VOID AFTER