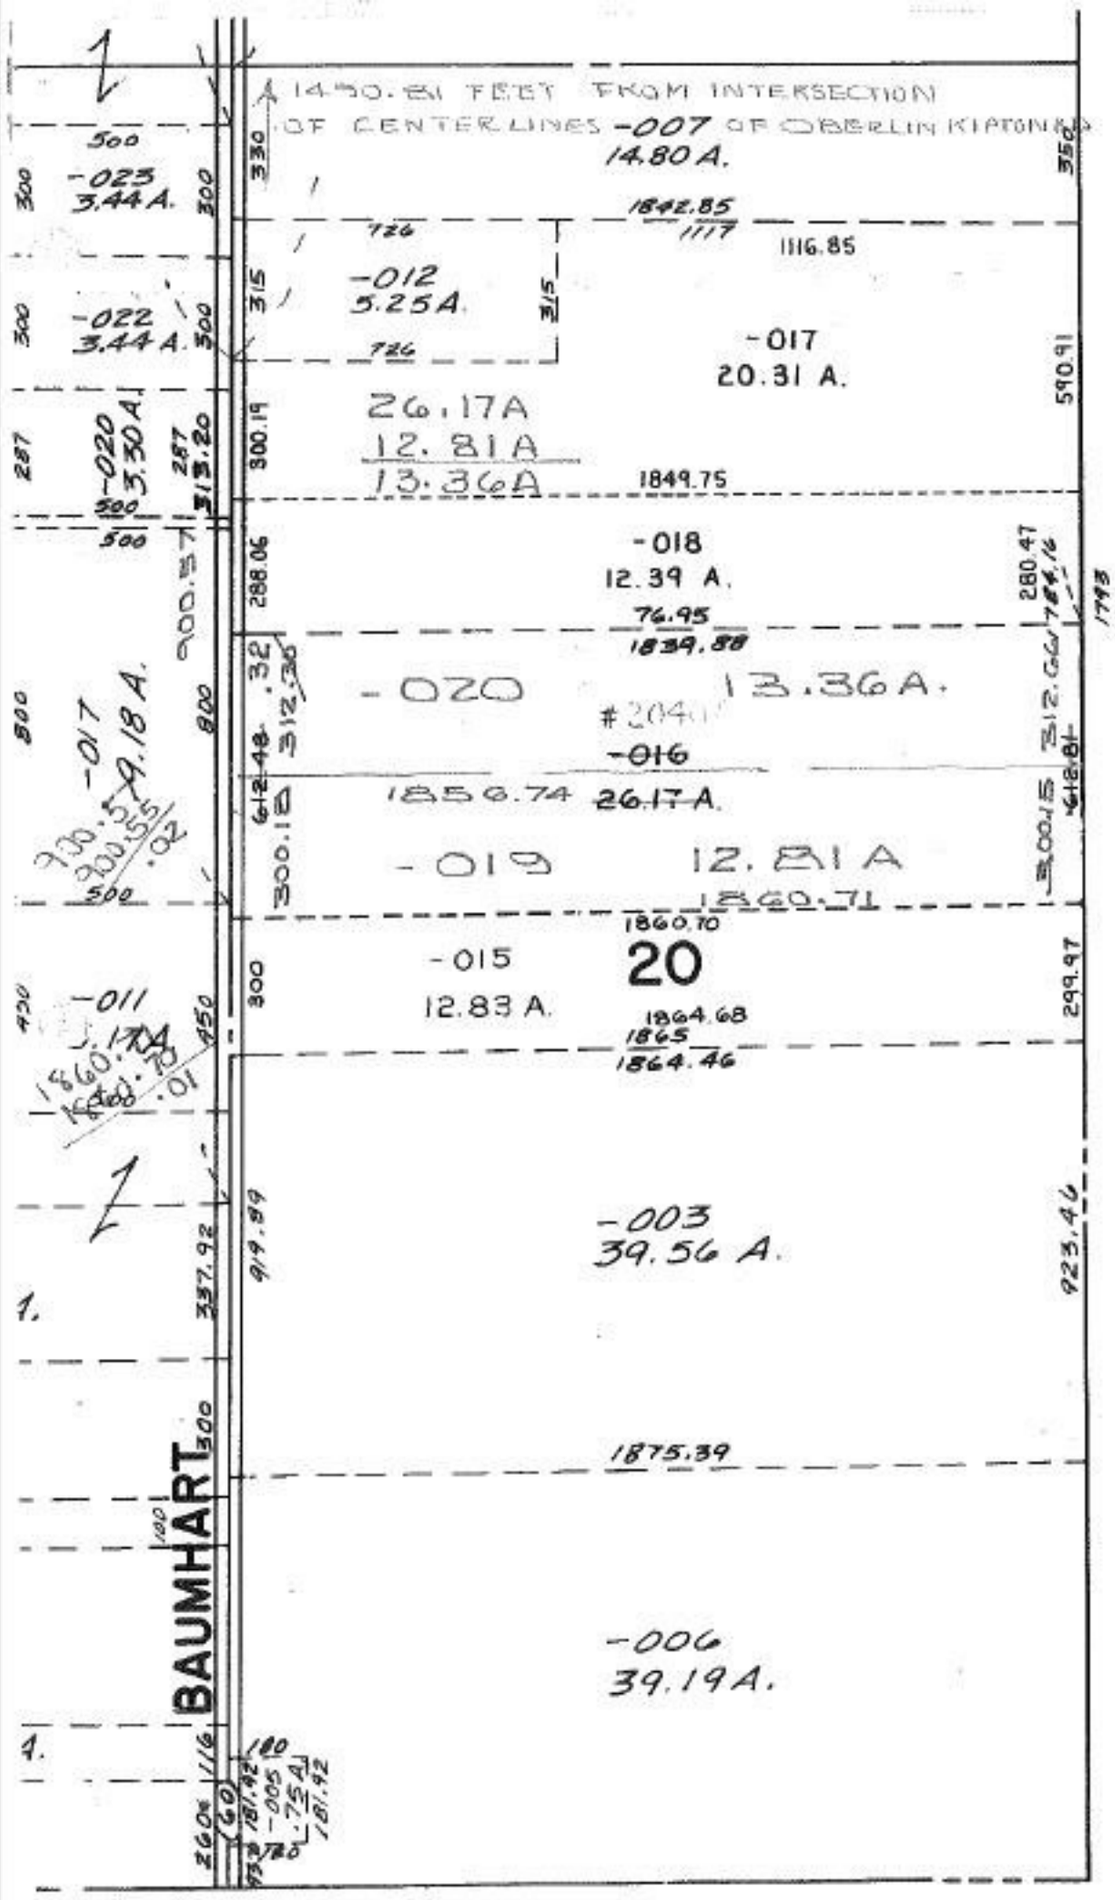

08-12-020-000- PRIOR INST: O.R.591/679
SURVEYED BY: THOMAS M. SNEZEK REG. SURVEYOR
C=1: 869 98

2/10/94
20407
APPROVED
LORAIN CO.
MAP DEPT.
DATE 6-30-93
PAGE 8-H
BY CAROLYN FRANCIS
VOID AFTER # 20407