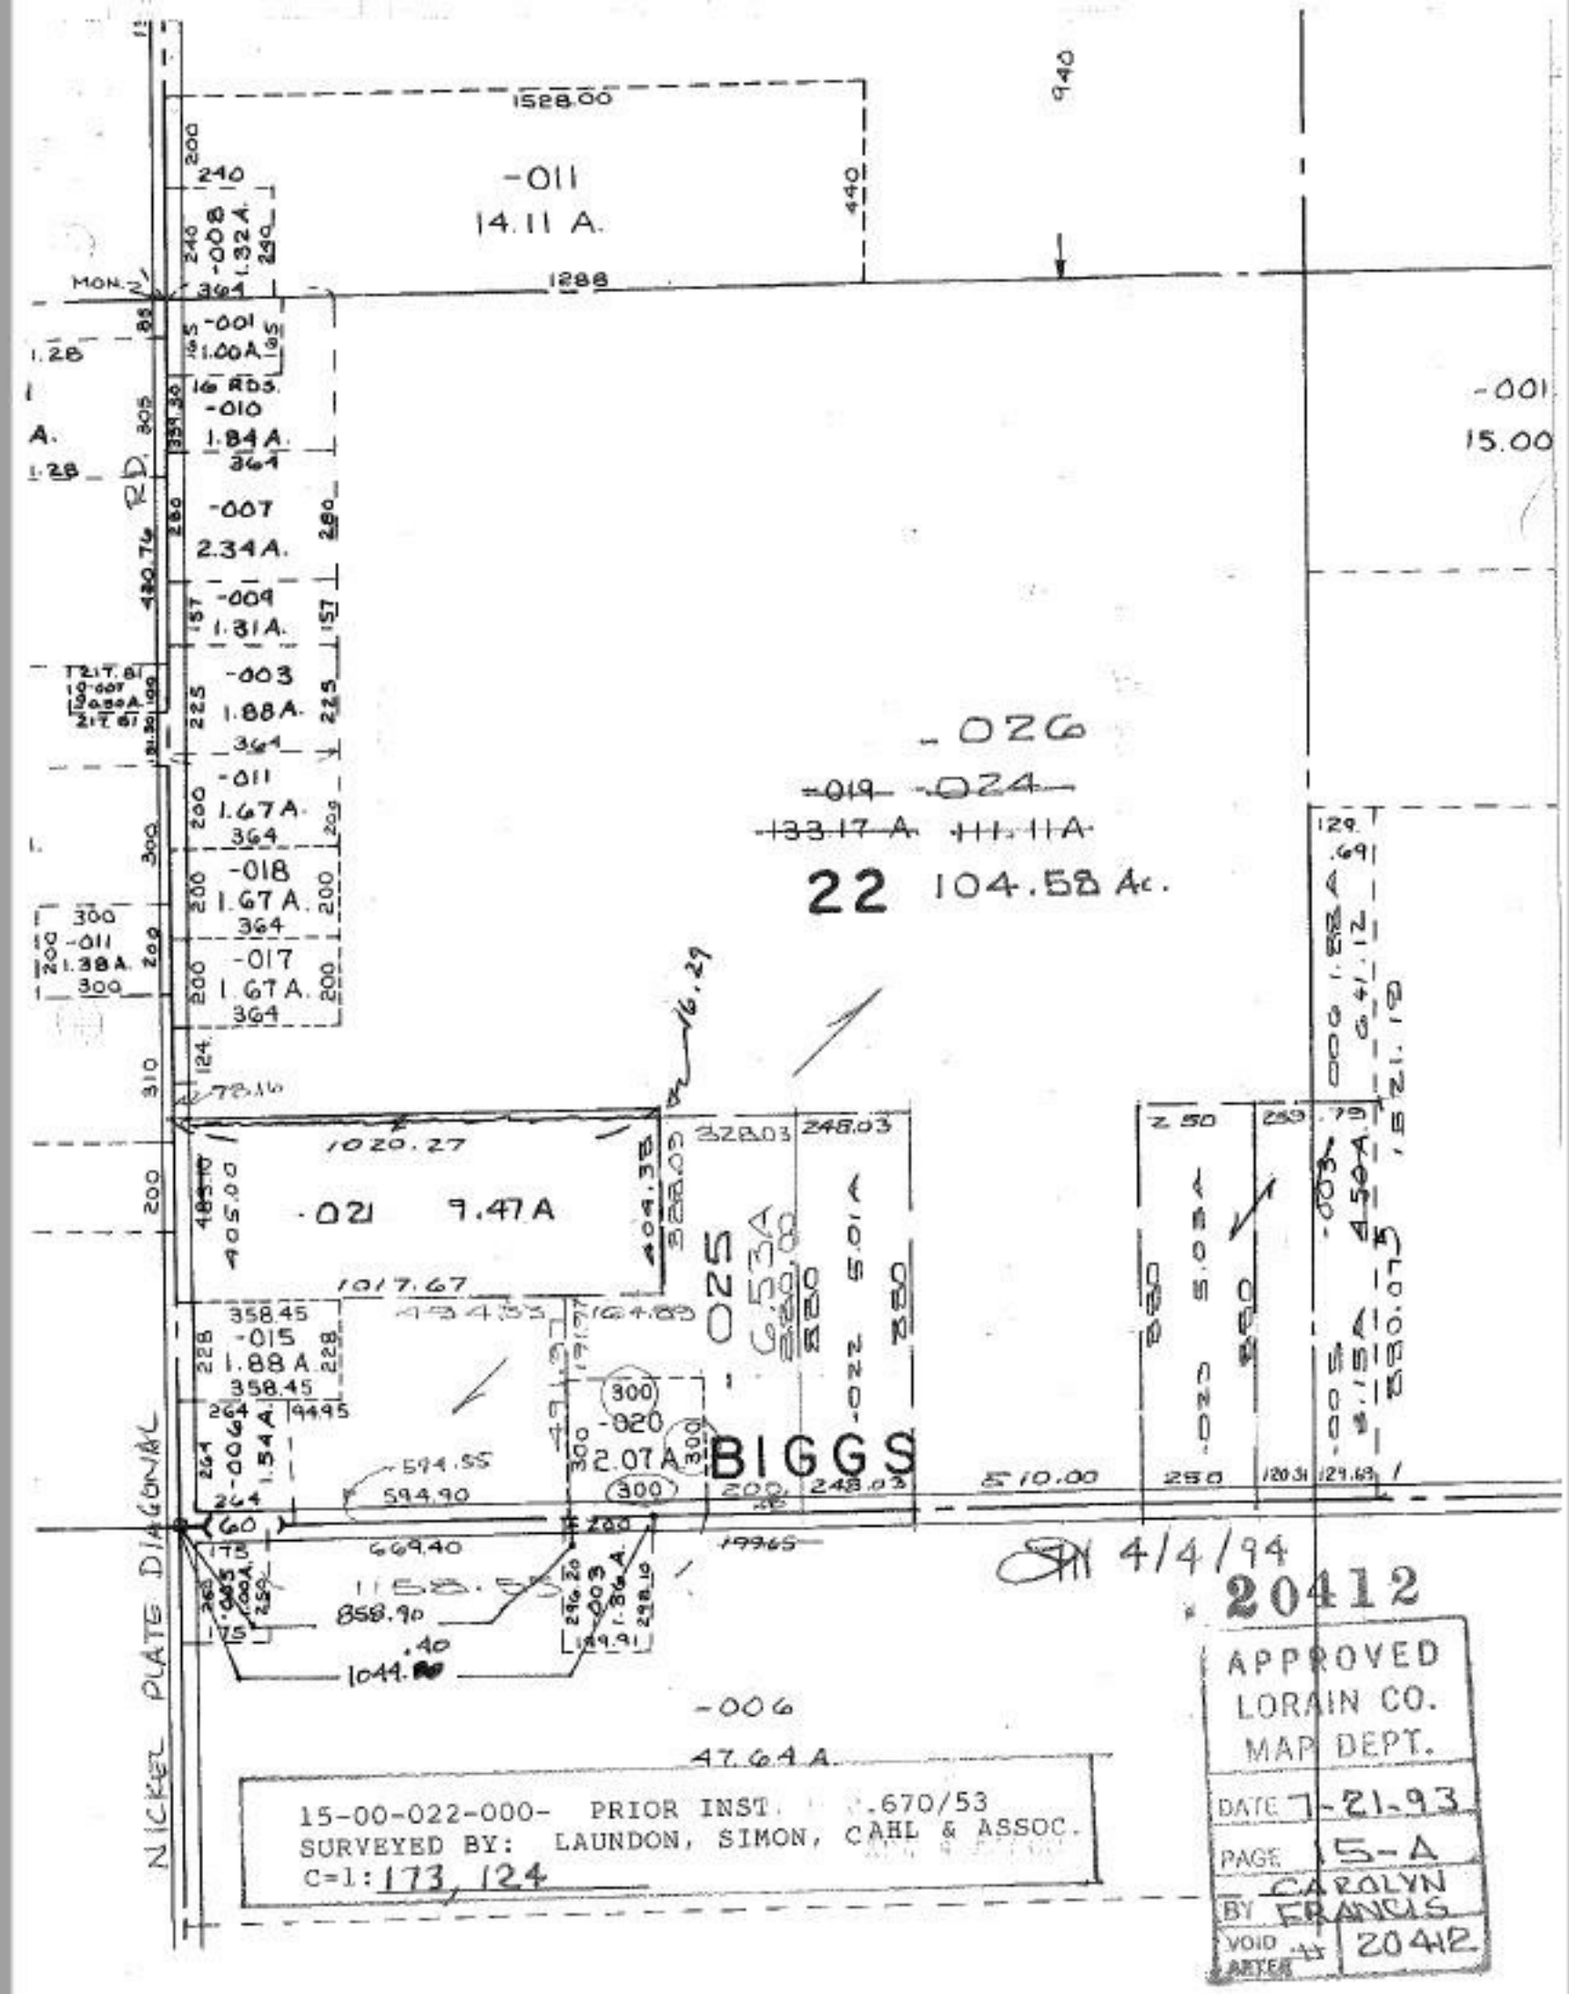

1528.00
-011
14.11 A.
1288
940
440
-001
15.00
-026
-019 -024
133.17 A. 111.11 A.
22 104.58 Ac.
-021 9.47 A
1020.27
1017.67
-015
1.88 A.
-020
2.07 A.
BIGGS
-006
47.64 A.
NICKEL PLATE DIAGONAL
15-00-022-000- PRIOR INST. .670/53
SURVEYED BY: LAUNDON, SIMON, CAHL & ASSOC.
C=1: 173, 124
4/4/94
20412
APPROVED
LORAIN CO.
MAP DEPT.
DATE 7-21-93
PAGE 15-A
BY CAROLYN FRANCIS
VOID AFTER 20412