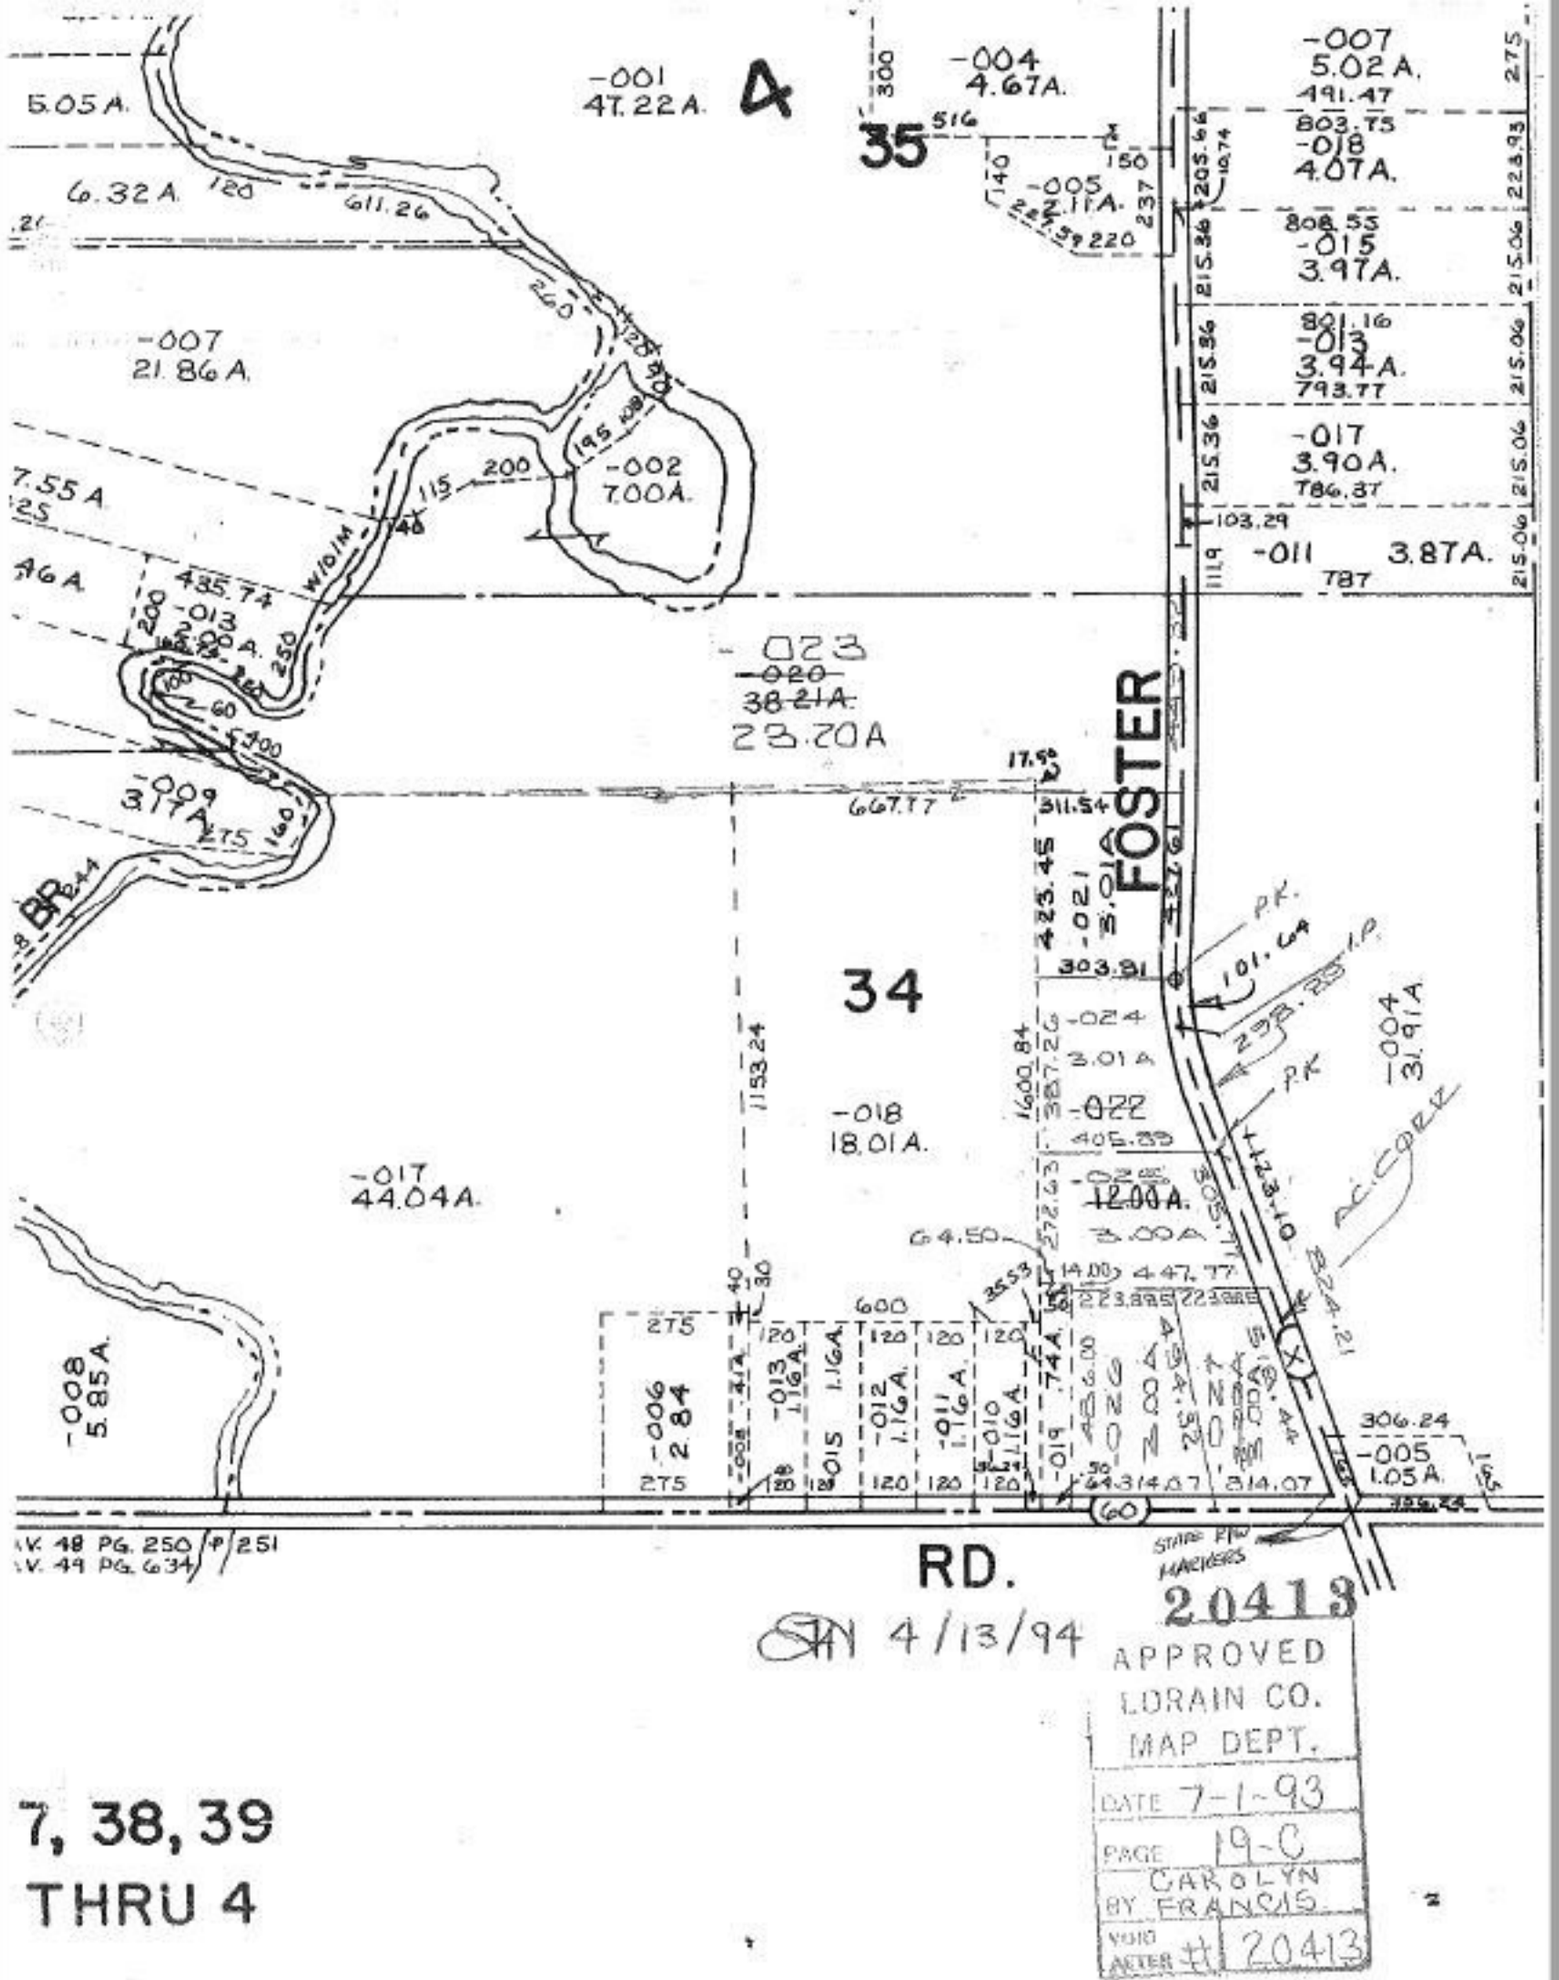

SAN 4/13/94

20413

APPROVED
LORAIN CO.
MAP DEPT.
DATE 7-1-93
PAGE 19-C
CAROLYN
BY FRANCIS
VOID
AFTER # 20413

7, 38, 39
THRU 4