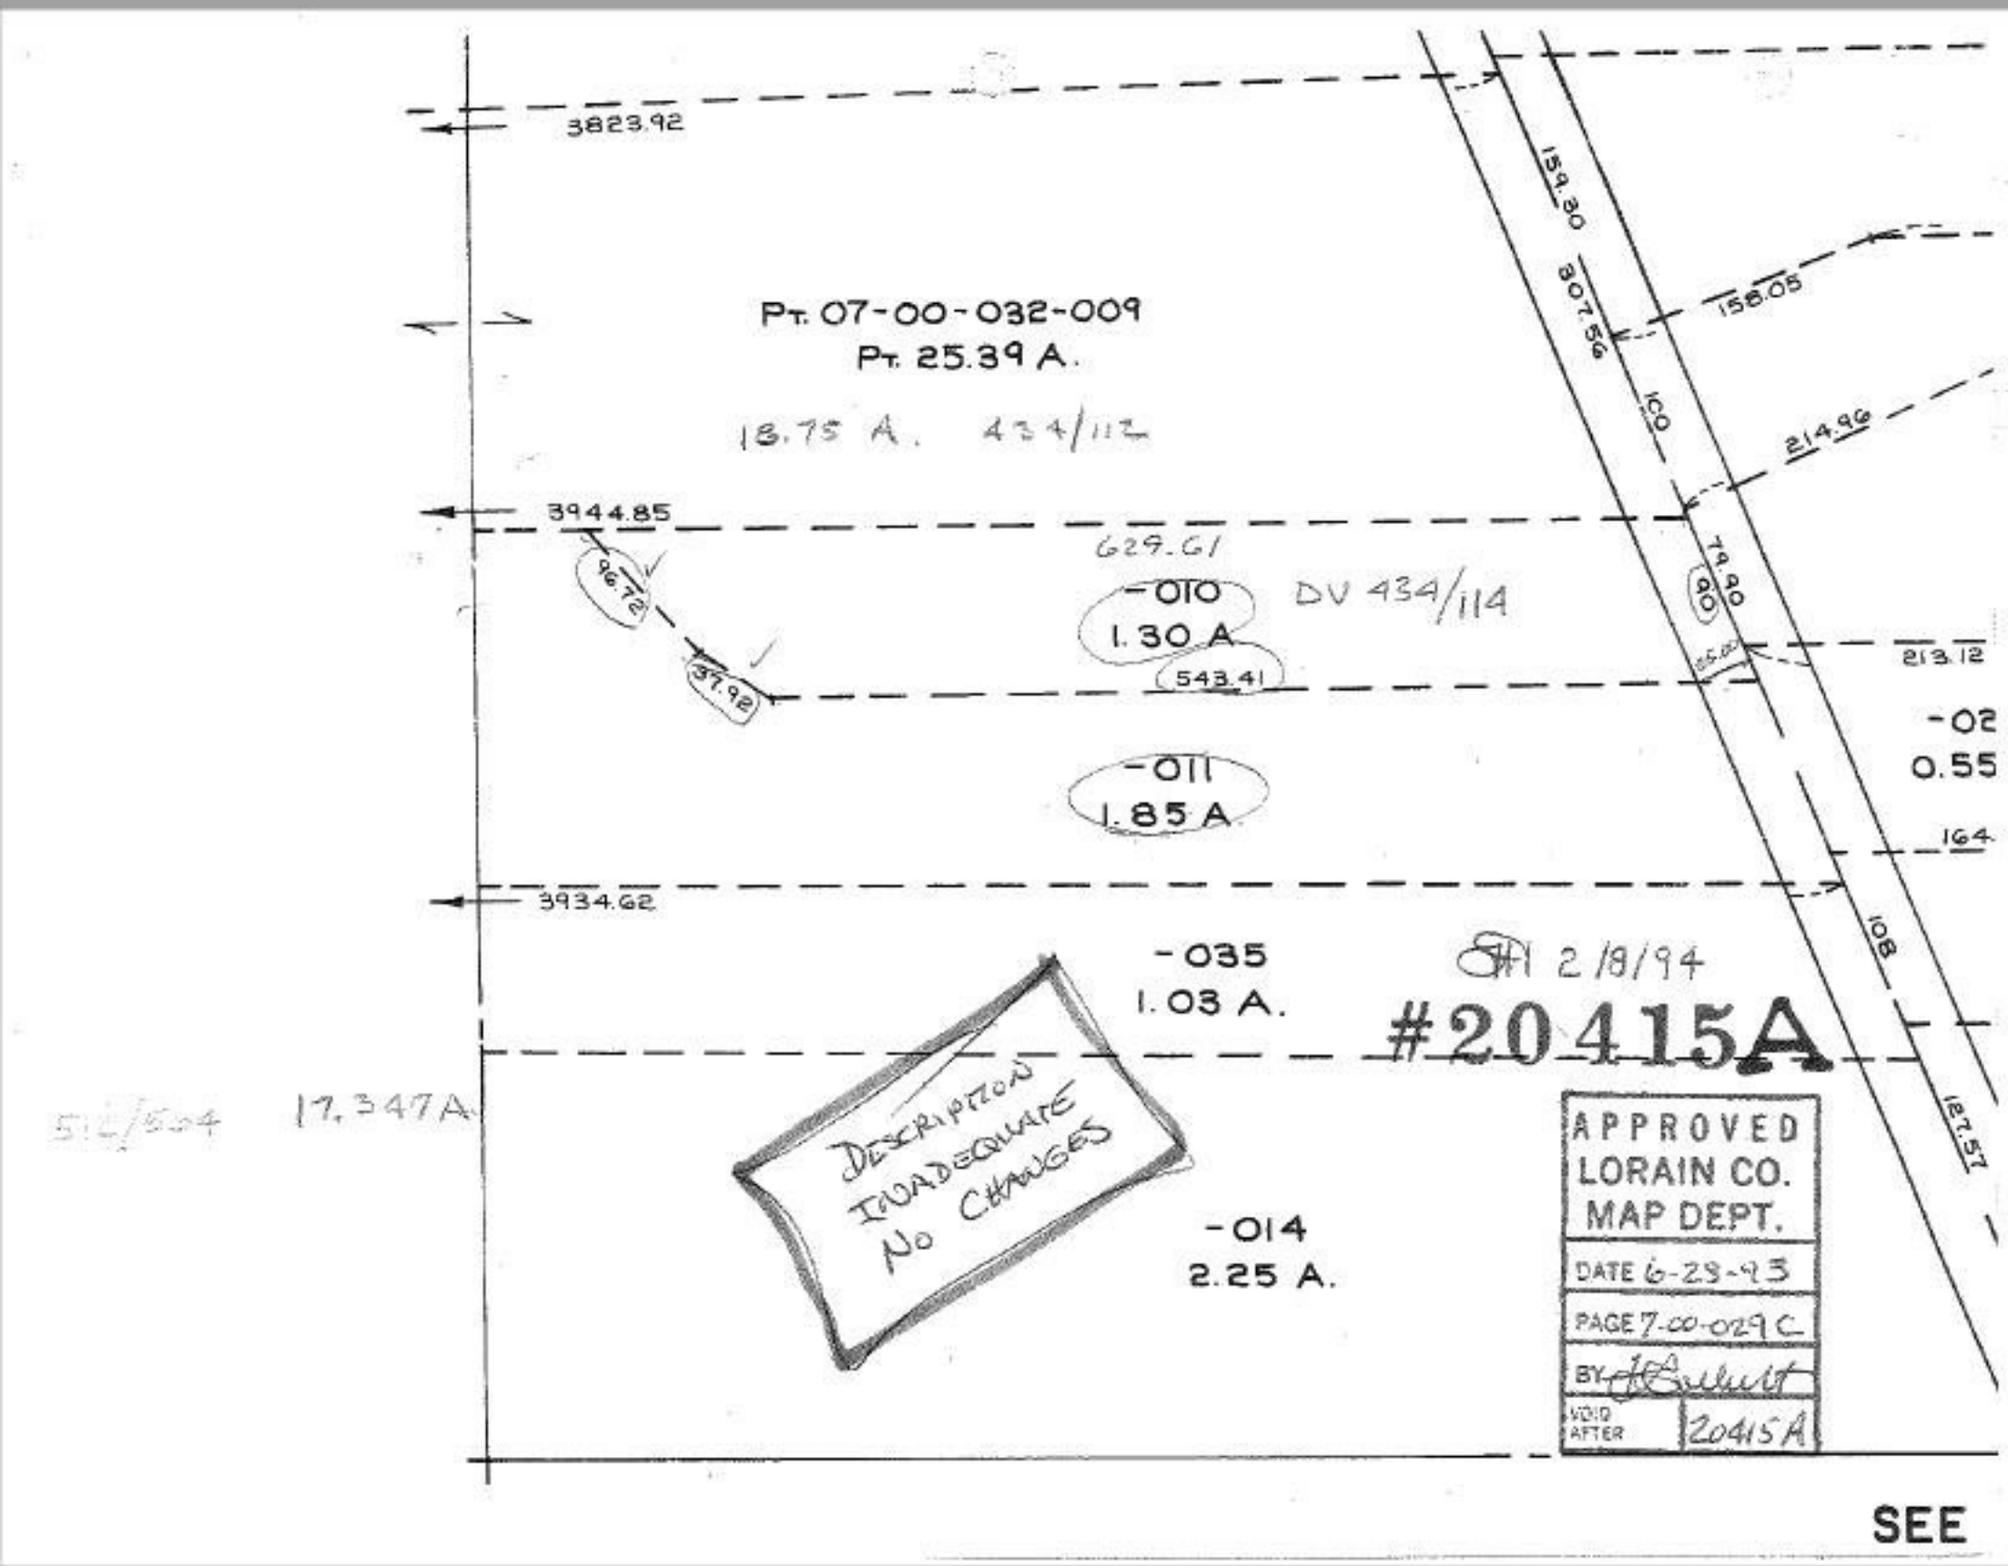
3823.92
Pt. 07-00-032-009
Pt. 25.39 A.
18.75 A. 434/112
3944.85
629.61
-010
1.30 A
DV 434/114
543.41
96.72
37.92
-011
1.85 A
3934.62
-035
1.03 A.
2/8/94
#20415A
17.347A
DESCRIPTION INADEQUATE NO CHANGES
-014
2.25 A.
159.30
307.56
158.05
100
214.96
79.90
90
213.12
-02
0.55
164
108
127.57
APPROVED
LORAIN CO.
MAP DEPT.
DATE 6-28-93
PAGE 7-00-029 C
BY
VOID AFTER
20415A
SEE