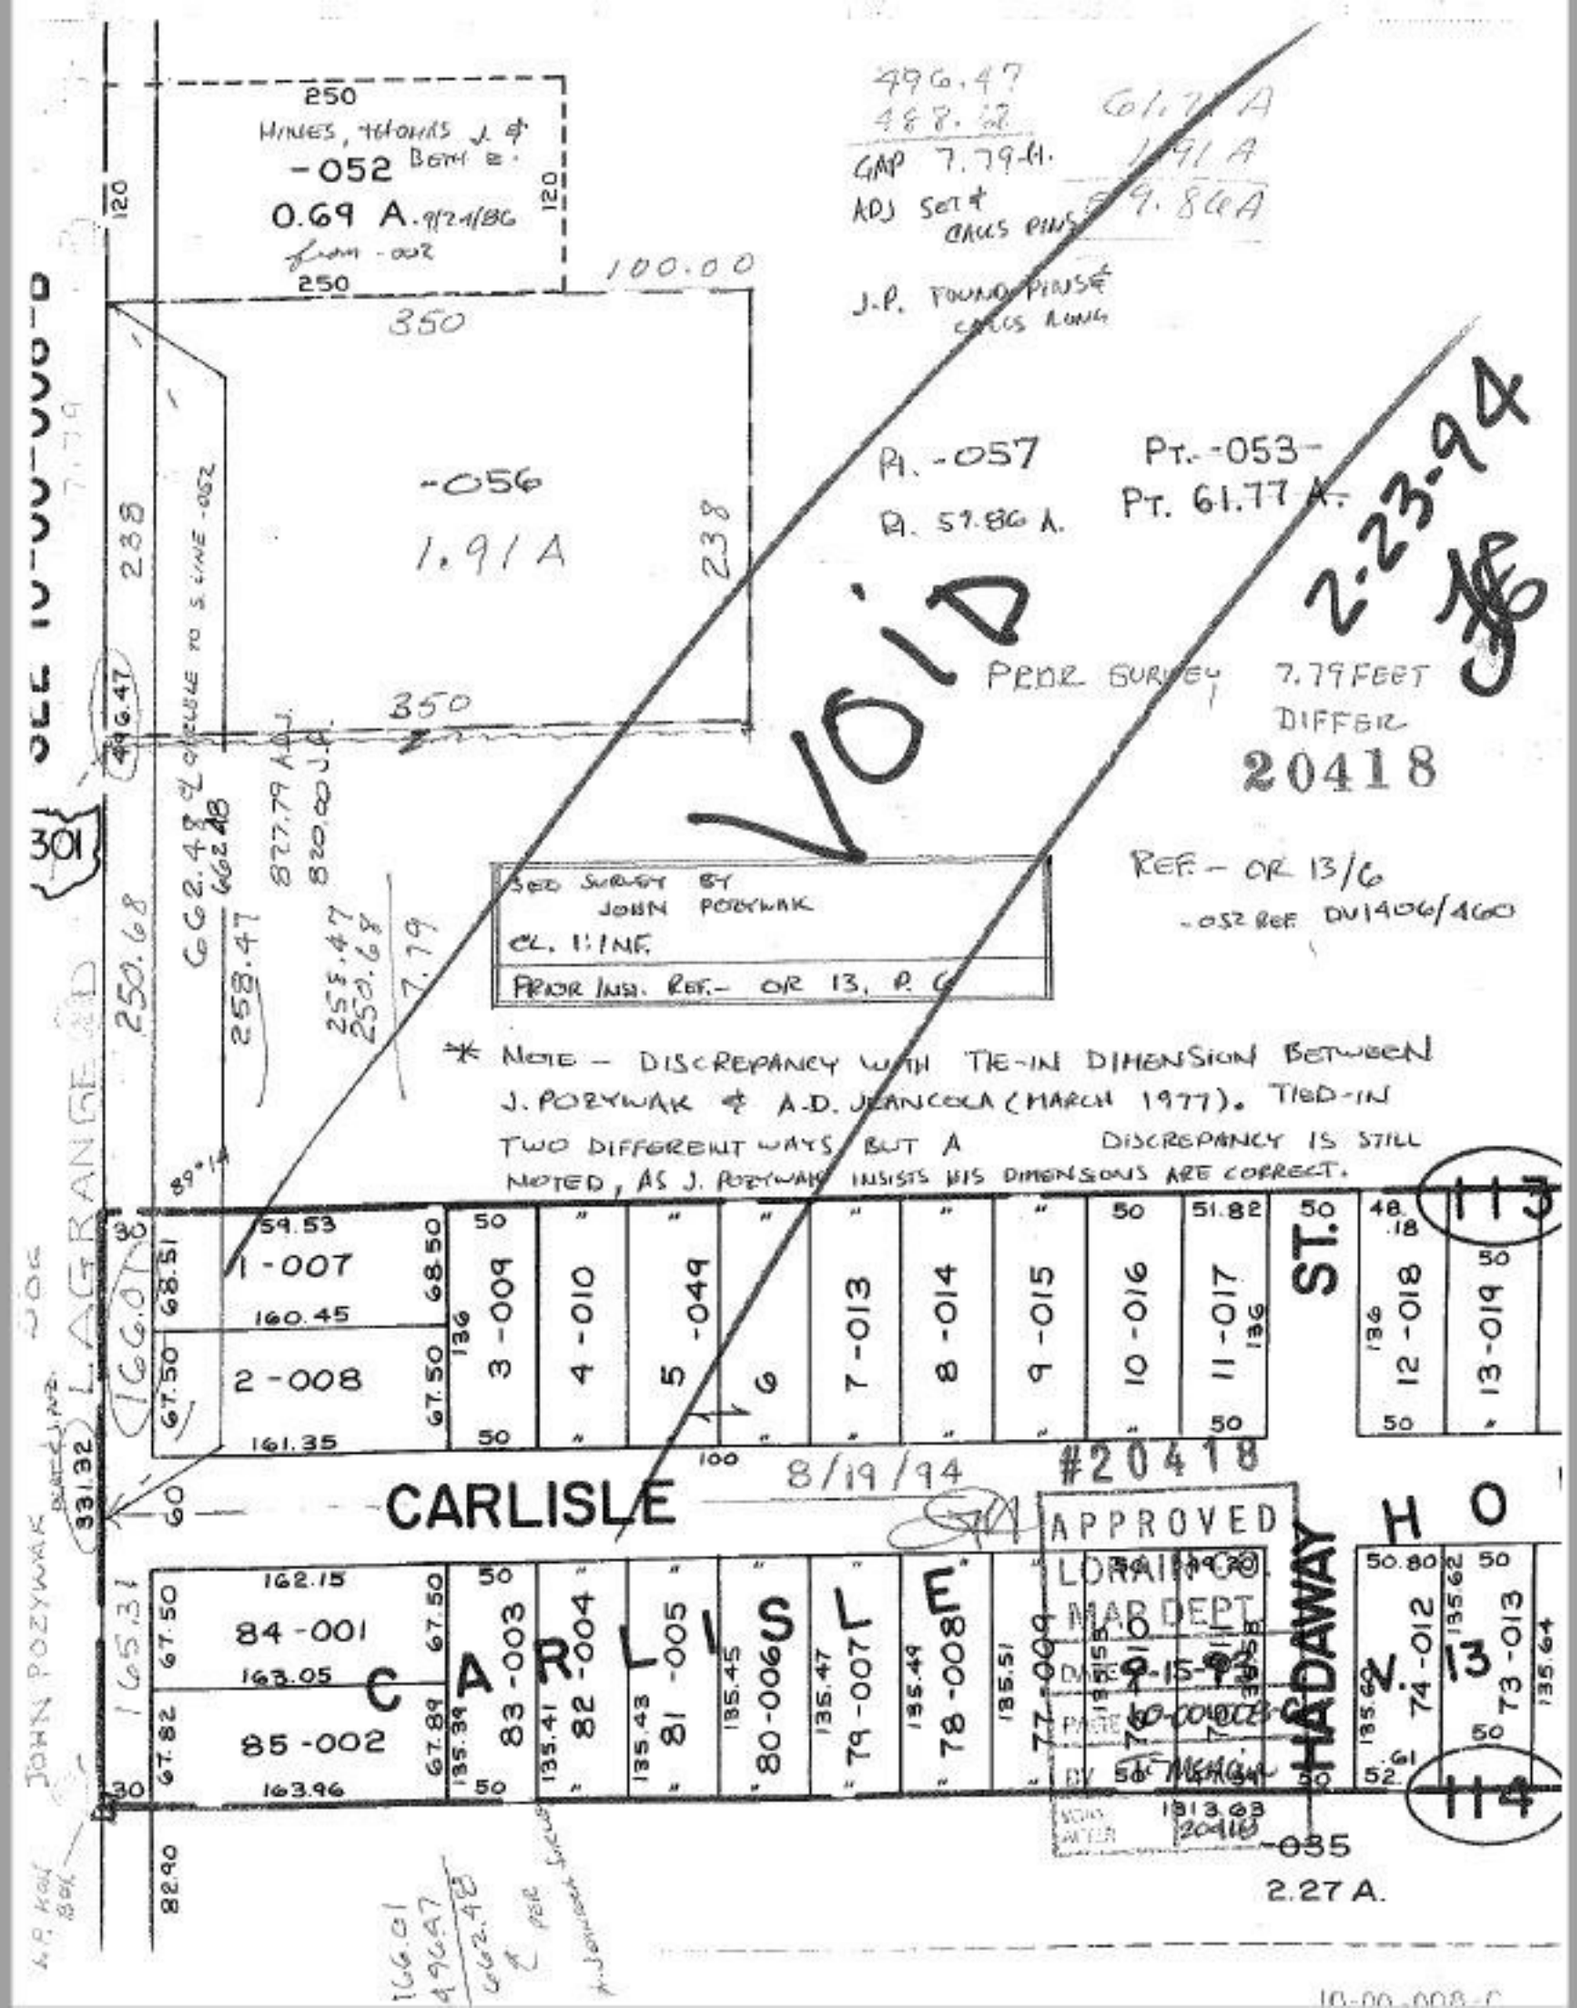

HINES, THOMAS J. & BETH E.
-052
0.69 A. 9/24/86
from -002
-056
1.91 A
100.00
350
238
496.47
662.48
877.79 A.D.J.
820.00 J.P.
250.68
258.47
7.79
SEE SURVEY BY JOHN POZYWAK
CL. 1:1NF.
PRIOR INST. REF.- OR 13, P. 6
* NOTE - DISCREPANCY WITH TIE-IN DIMENSION BETWEEN J. POZYWAK & A.D. JEANCOLA (MARCH 1977). TIED-IN TWO DIFFERENT WAYS, BUT A DISCREPANCY IS STILL NOTED, AS J. POZYWAK INSISTS HIS DIMENSIONS ARE CORRECT.
496.47
488.62
GAP 7.79 ft.
ADJ SET & CALCS PINS
J.P. FOUND PINS & CALCS ALONG
61.77 A
1.91 A
59.86 A
Pt. -057
Pt. 59.86 A.
Pt. -053-
Pt. 61.77 A.
VOID
2-23-94
PRIOR SURVEY 7.79 FEET DIFFER
20418
REF. - OR 13/6
-052 REF. DV1406/460
LAGRANGE RD
JOHN POZYWAK
CARLISLE
HADAWAY ST.
HO
CARLISLE
V. 13
1-007
2-008
3-009
4-010
5-049
6
7-013
8-014
9-015
10-016
11-017
12-018
13-019
84-001
85-002
83-003
82-004
81-005
80-006
79-007
78-008
77-009
76-010
74-012
73-013
8/19/94
#20418
APPROVED
LORAIN CO.
MAP DEPT.
DATE 9-15-93
PAGE 10-00-008-C
BY
VOID AFTER 20418
-035
2.27 A.
113
114