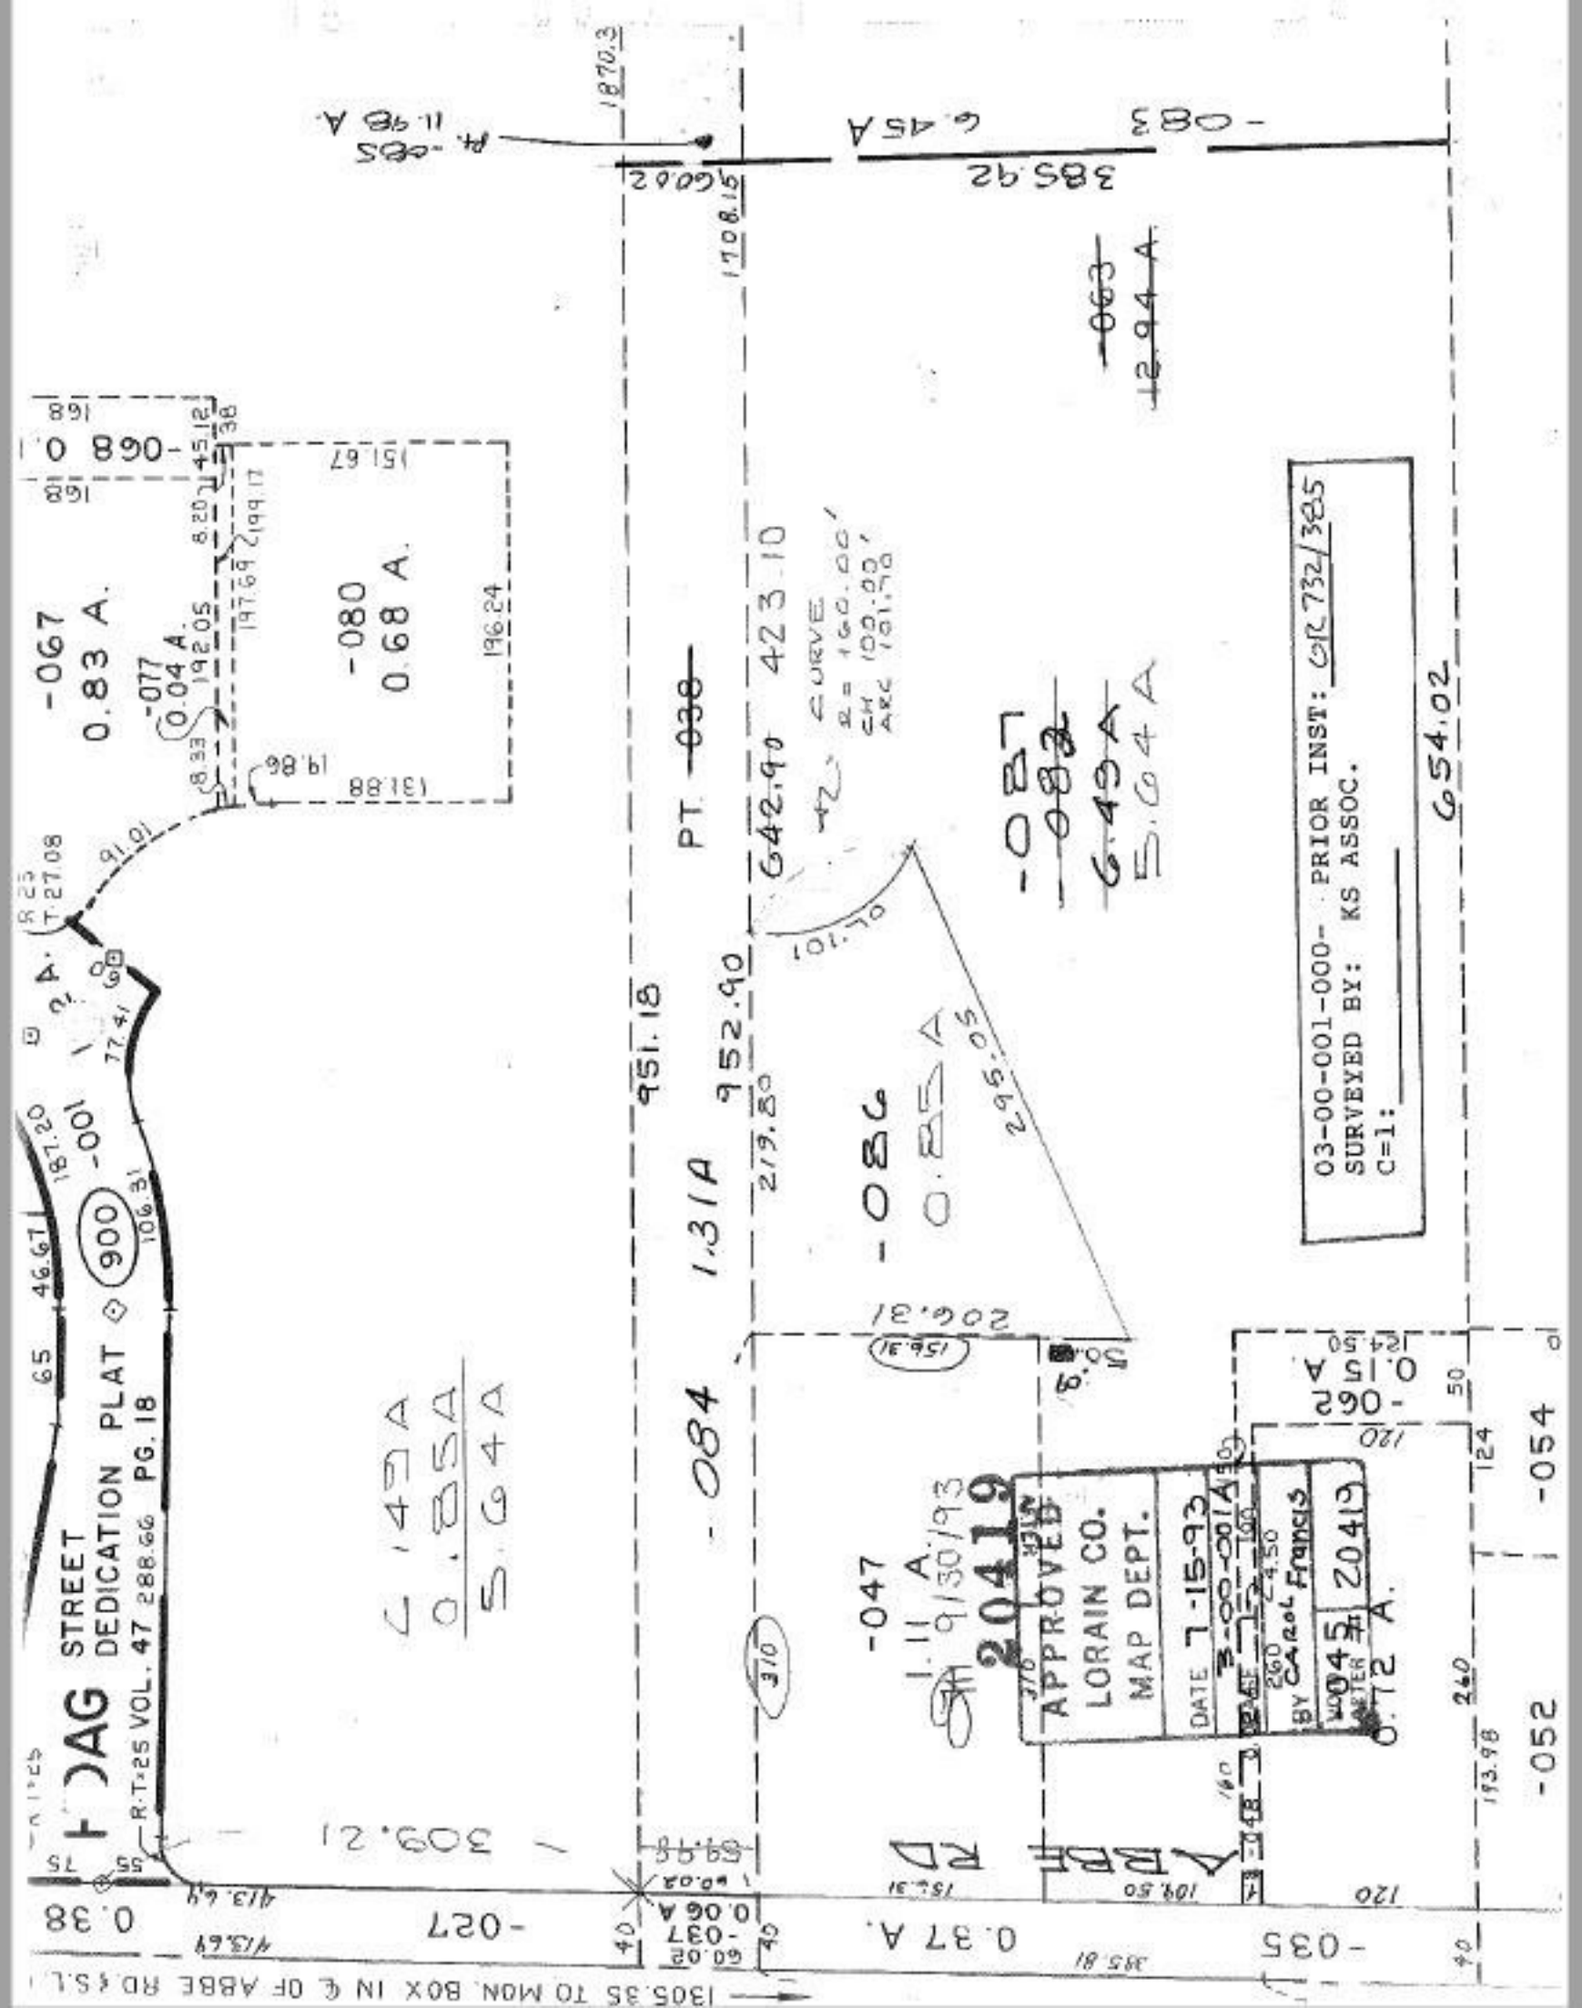
-067
0.83 A.
-077
0.04 A.
-080
0.68 A.
-087
-083
6.43A
5.64A
PT. -038
642.90
423.10
CURVE
R = 160.00'
CH 100.00'
ARC 101.70
951.18
952.90
1.31A
-084
-086
0.85A
-047
1.11A
9/30/93
20419
APPROVED
LORAIN CO.
MAP DEPT.
DATE 7-15-93
3-00-001A
BY Carol Francis
20413
0.72 A.
7.43A
0.84A
5.64A
-027
0.38
0.37 A.
-035
-052
-054
-037
0.06 A
309.21
1305.35 TO MON. BOX IN ℄ OF ABBE RD ℄S.L.
PRIOR INST: OR 732/385
KS ASSOC.
654.02
SURVEYED BY:
C=1:
STREET DEDICATION PLAT
R.T.25 VOL. 47 288.66 PG. 18