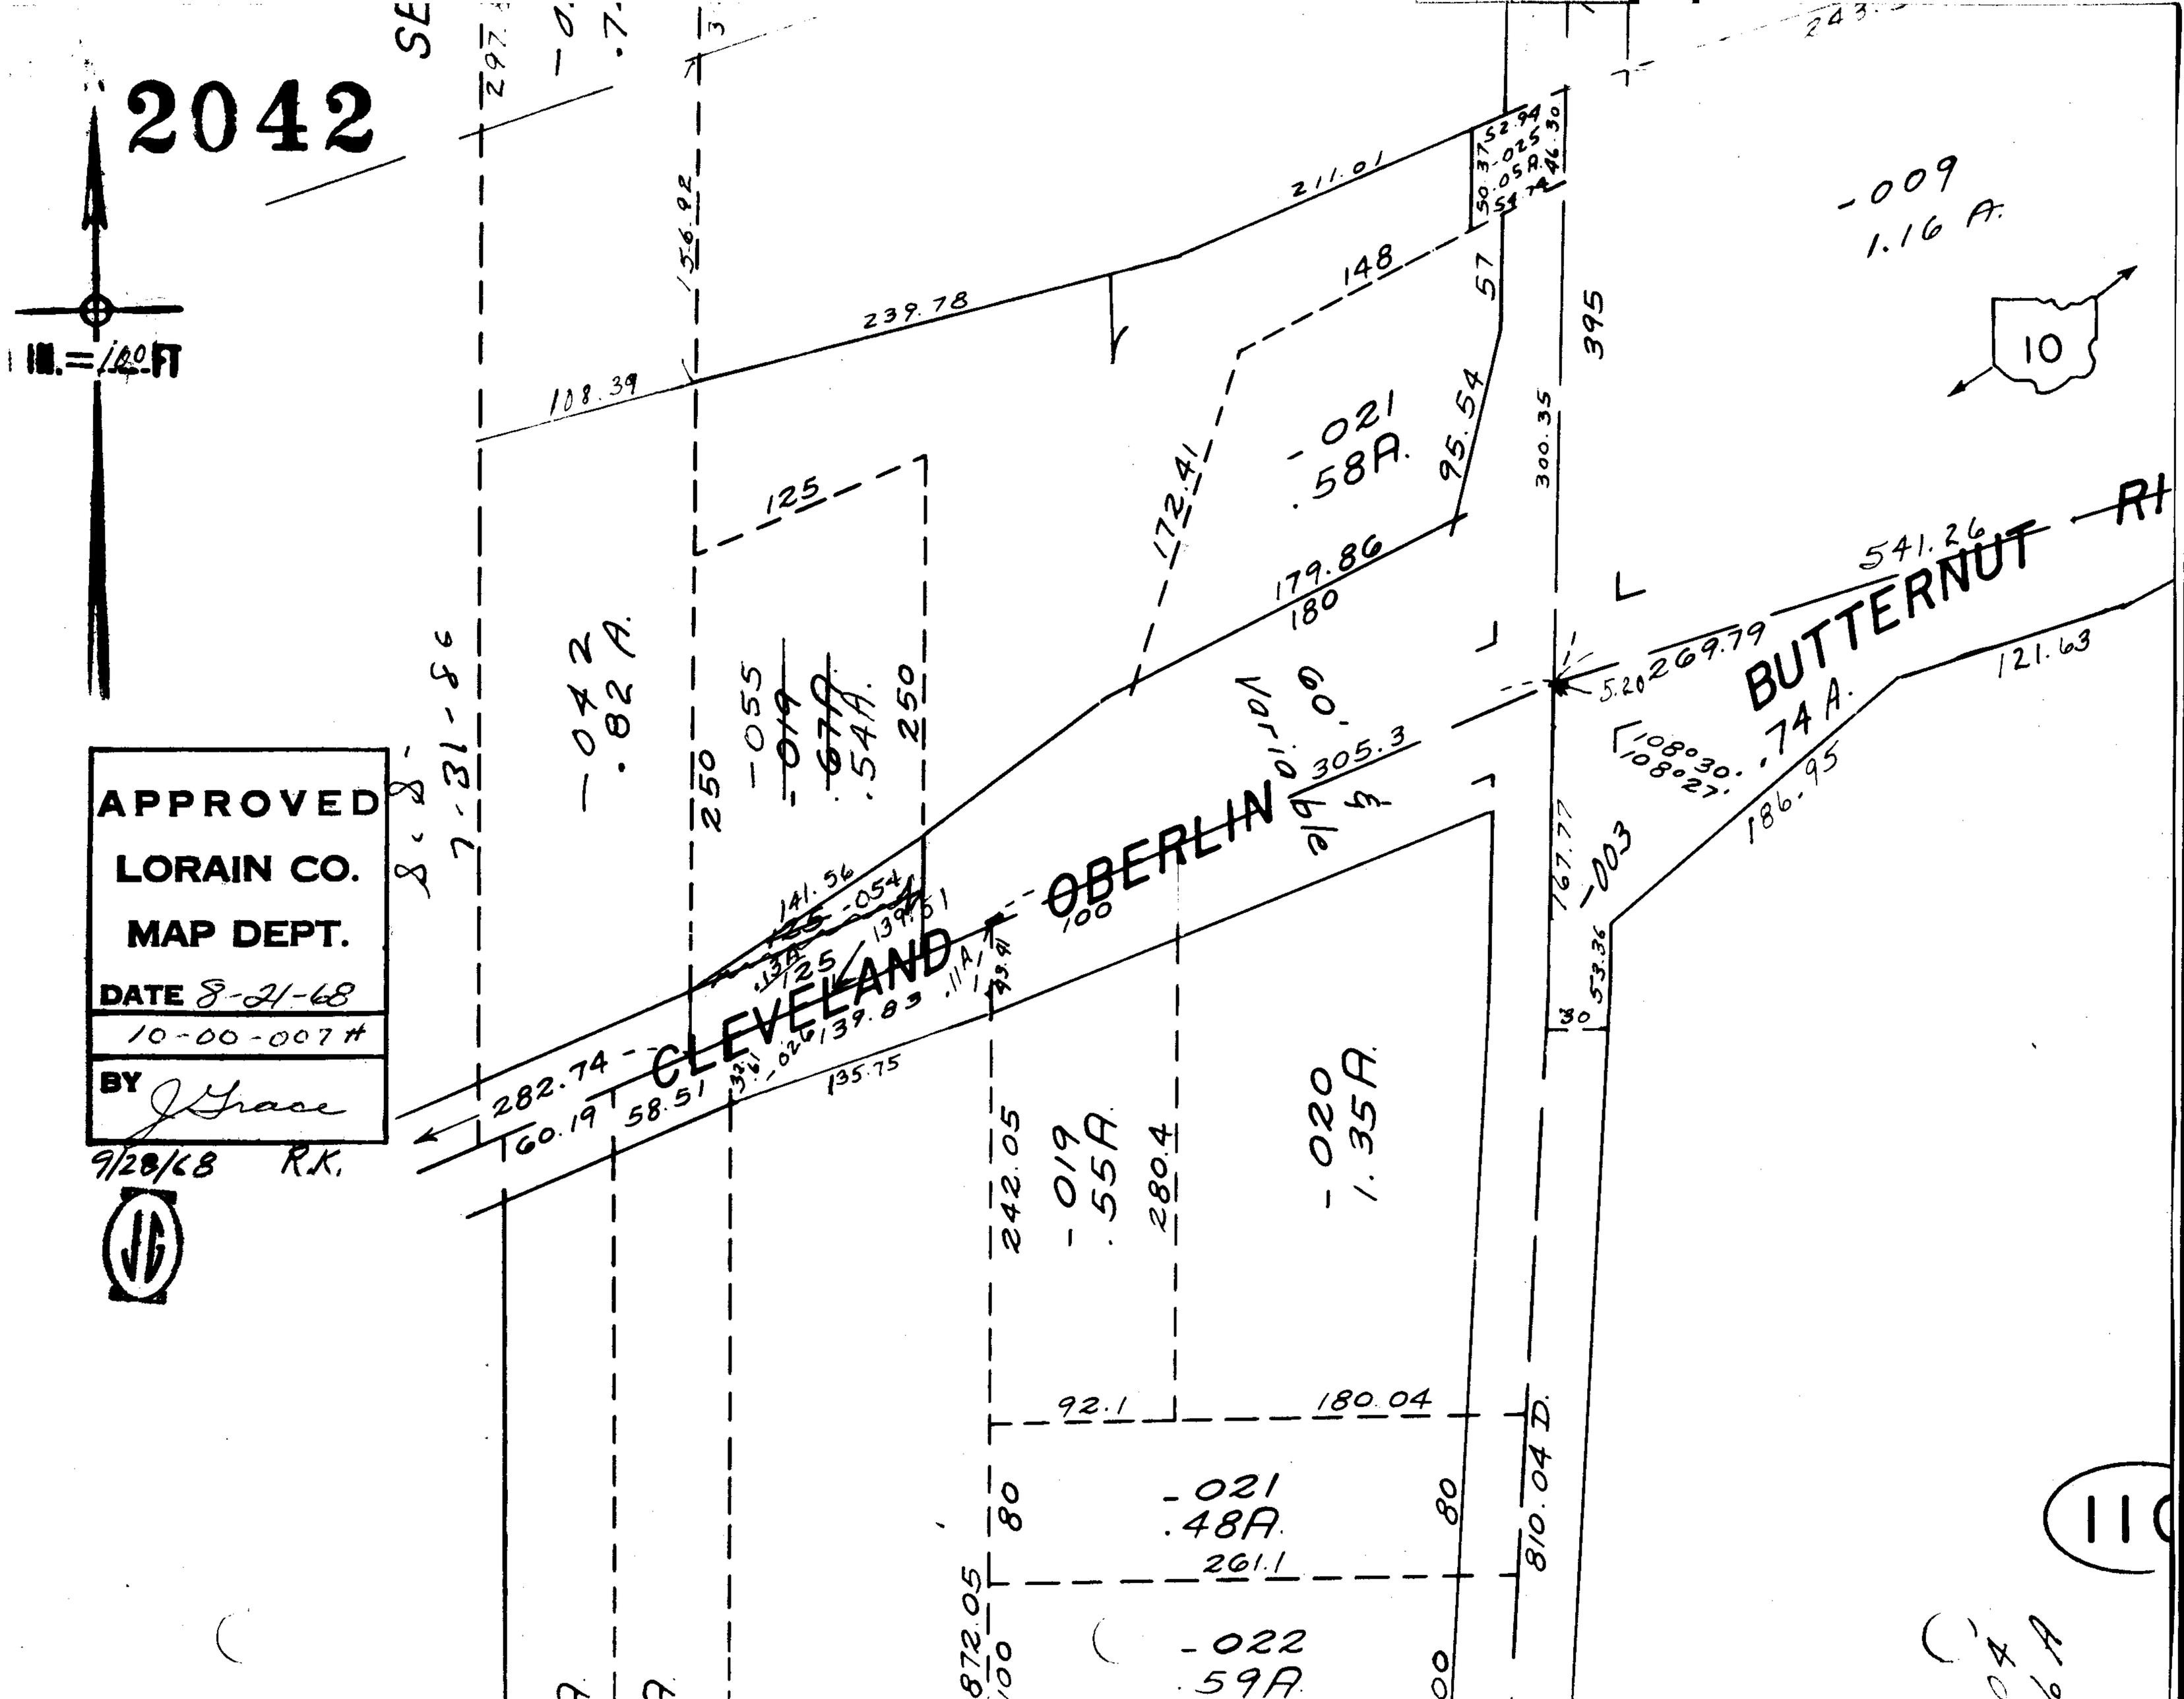
2042
IN.=100 FT
APPROVED
LORAIN CO.
MAP DEPT.
DATE 8-21-68
10-00-007 #
BY J Grace
9/28/68 R.K.
CLEVELAND - OBERLIN
BUTTERNUT RI
-009
1.16 A.
-021
.58A.
-042
.82 A.
-055
-019
.54A.
-020
1.35A.
-019
.55A.
-021
.48A.
-022
.59A.
-003
.74 A.
10
11