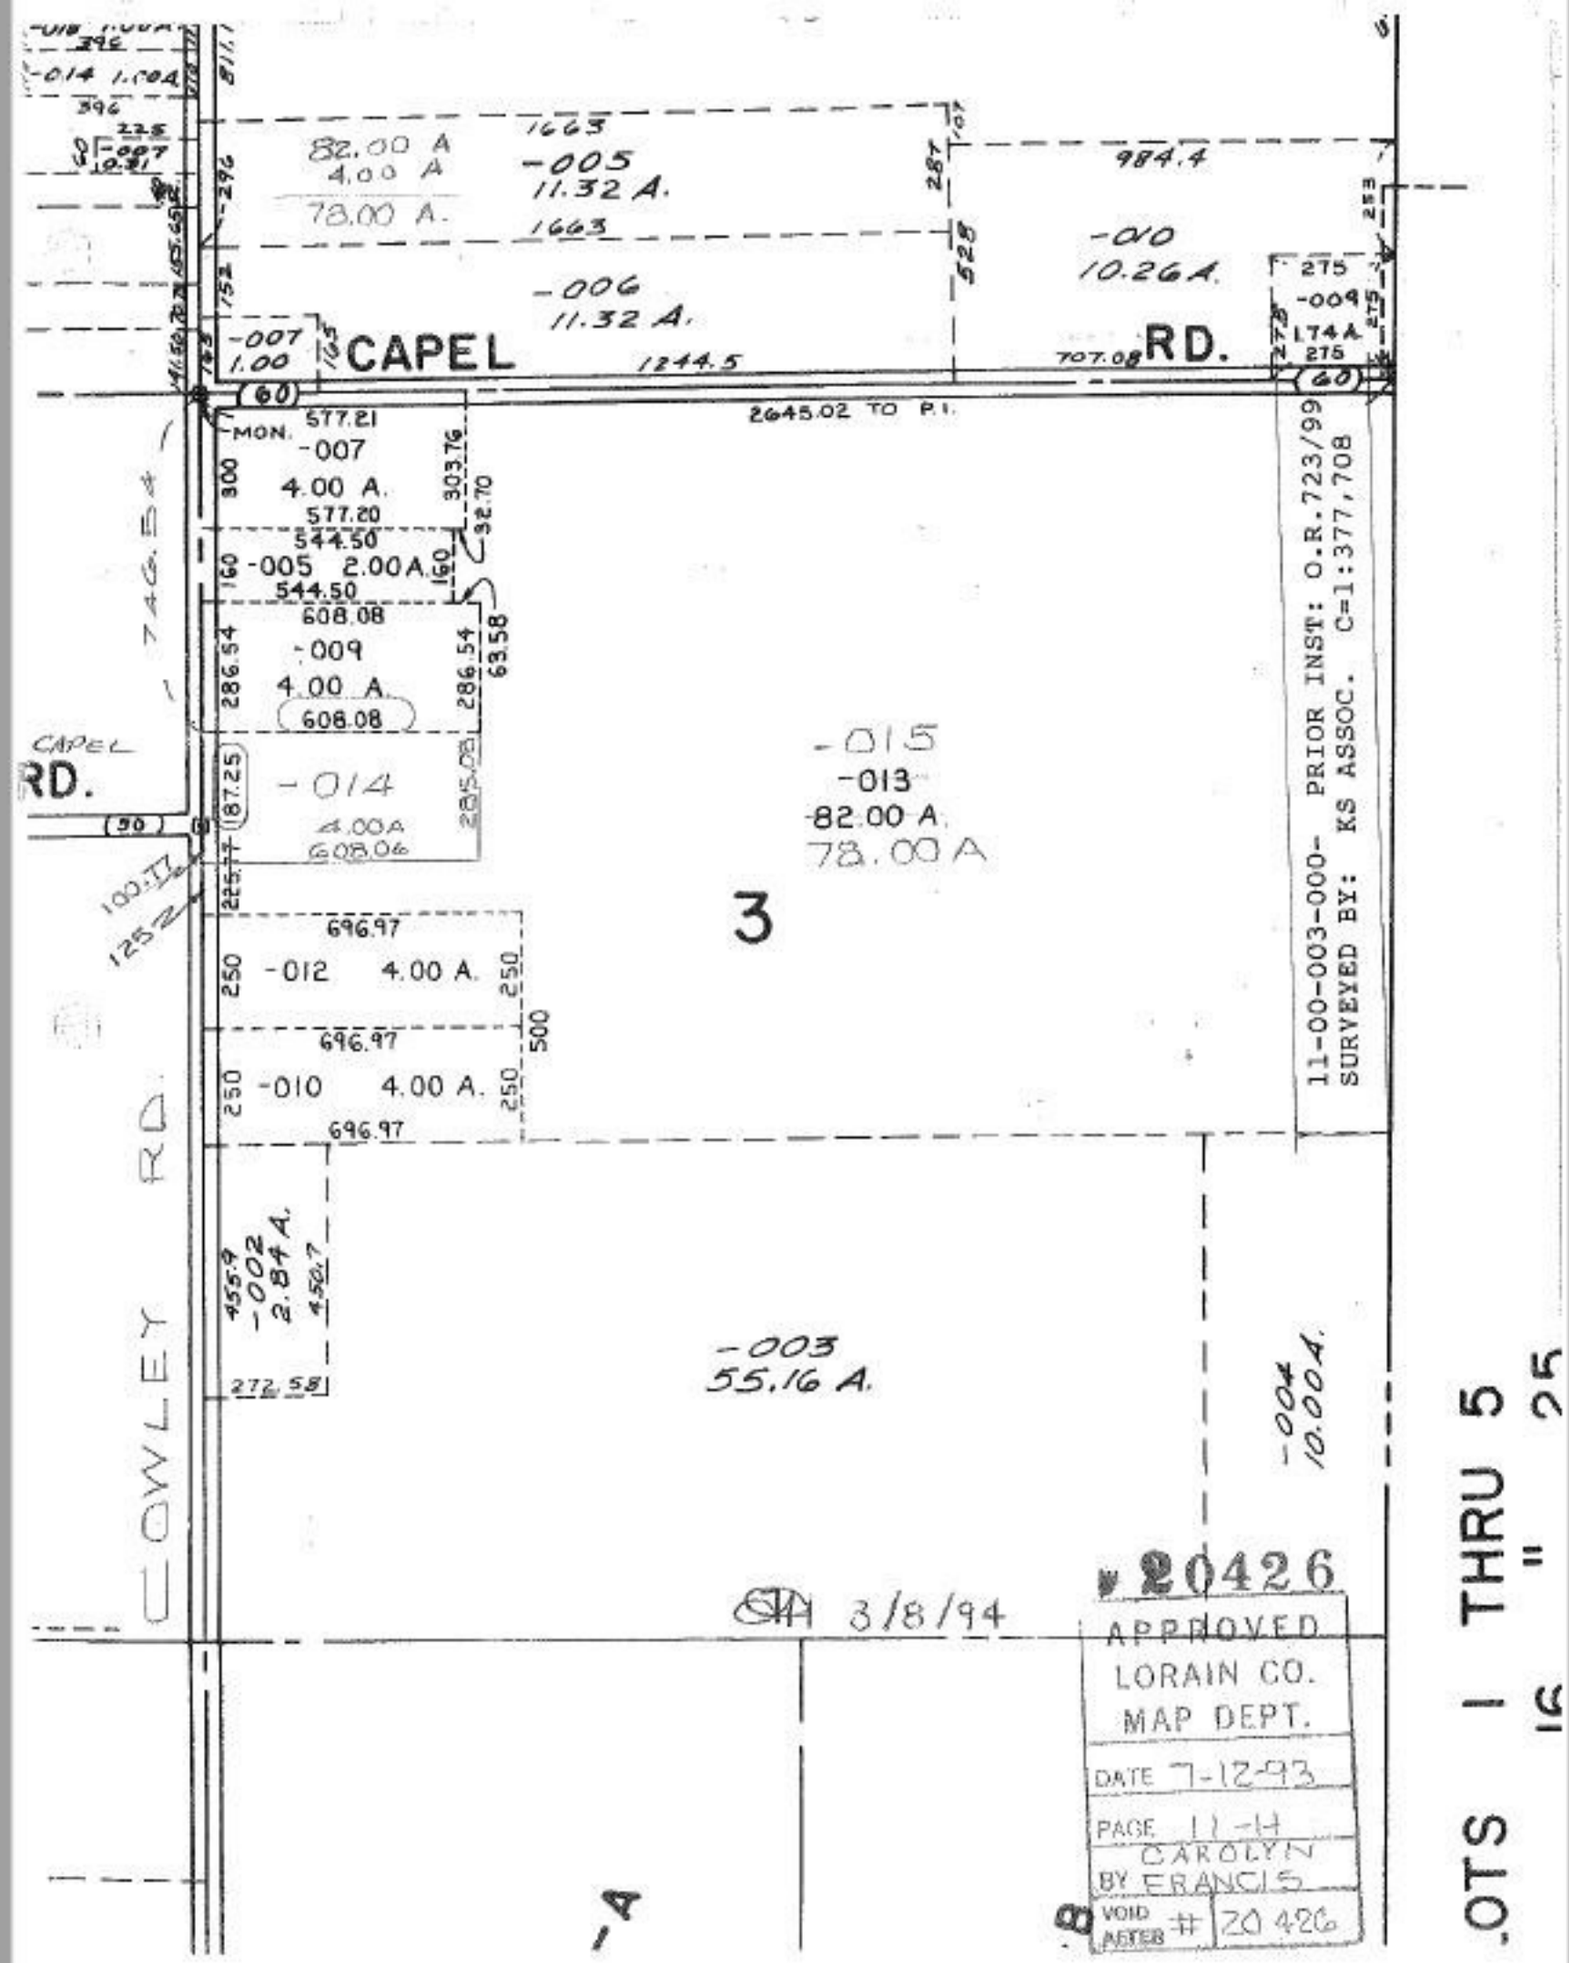
CAPEL RD.
COWLEY RD.
82.00 A
4.00 A
78.00 A.
1663
-005
11.32 A.
1663
-006
11.32 A.
984.4
-010
10.26 A.
275
-009
1.74 A.
275
-007
1.00
1244.5
707.08
60
2645.02 TO P.I.
577.21
-007
4.00 A.
577.20
544.50
-005 2.00 A.
544.50
608.08
-009
4.00 A.
608.08
-014
4.00 A
608.06
-015
-013
82.00 A.
78.00 A
3
696.97
-012 4.00 A.
696.97
-010 4.00 A.
696.97
455.9
-002
2.84 A.
450.7
272.58
-003
55.16 A.
-004
10.00 A.
11-00-003-000- PRIOR INST: O.R.723/99
SURVEYED BY: KS ASSOC. C=1:377,708
STA 3/8/94
20426
APPROVED
LORAIN CO.
MAP DEPT.
DATE 7-12-93
PAGE 11-14
BY CAROLYN FRANCIS
VOID AFTER # 20426
LOTS 1 THRU 5
16 " 25