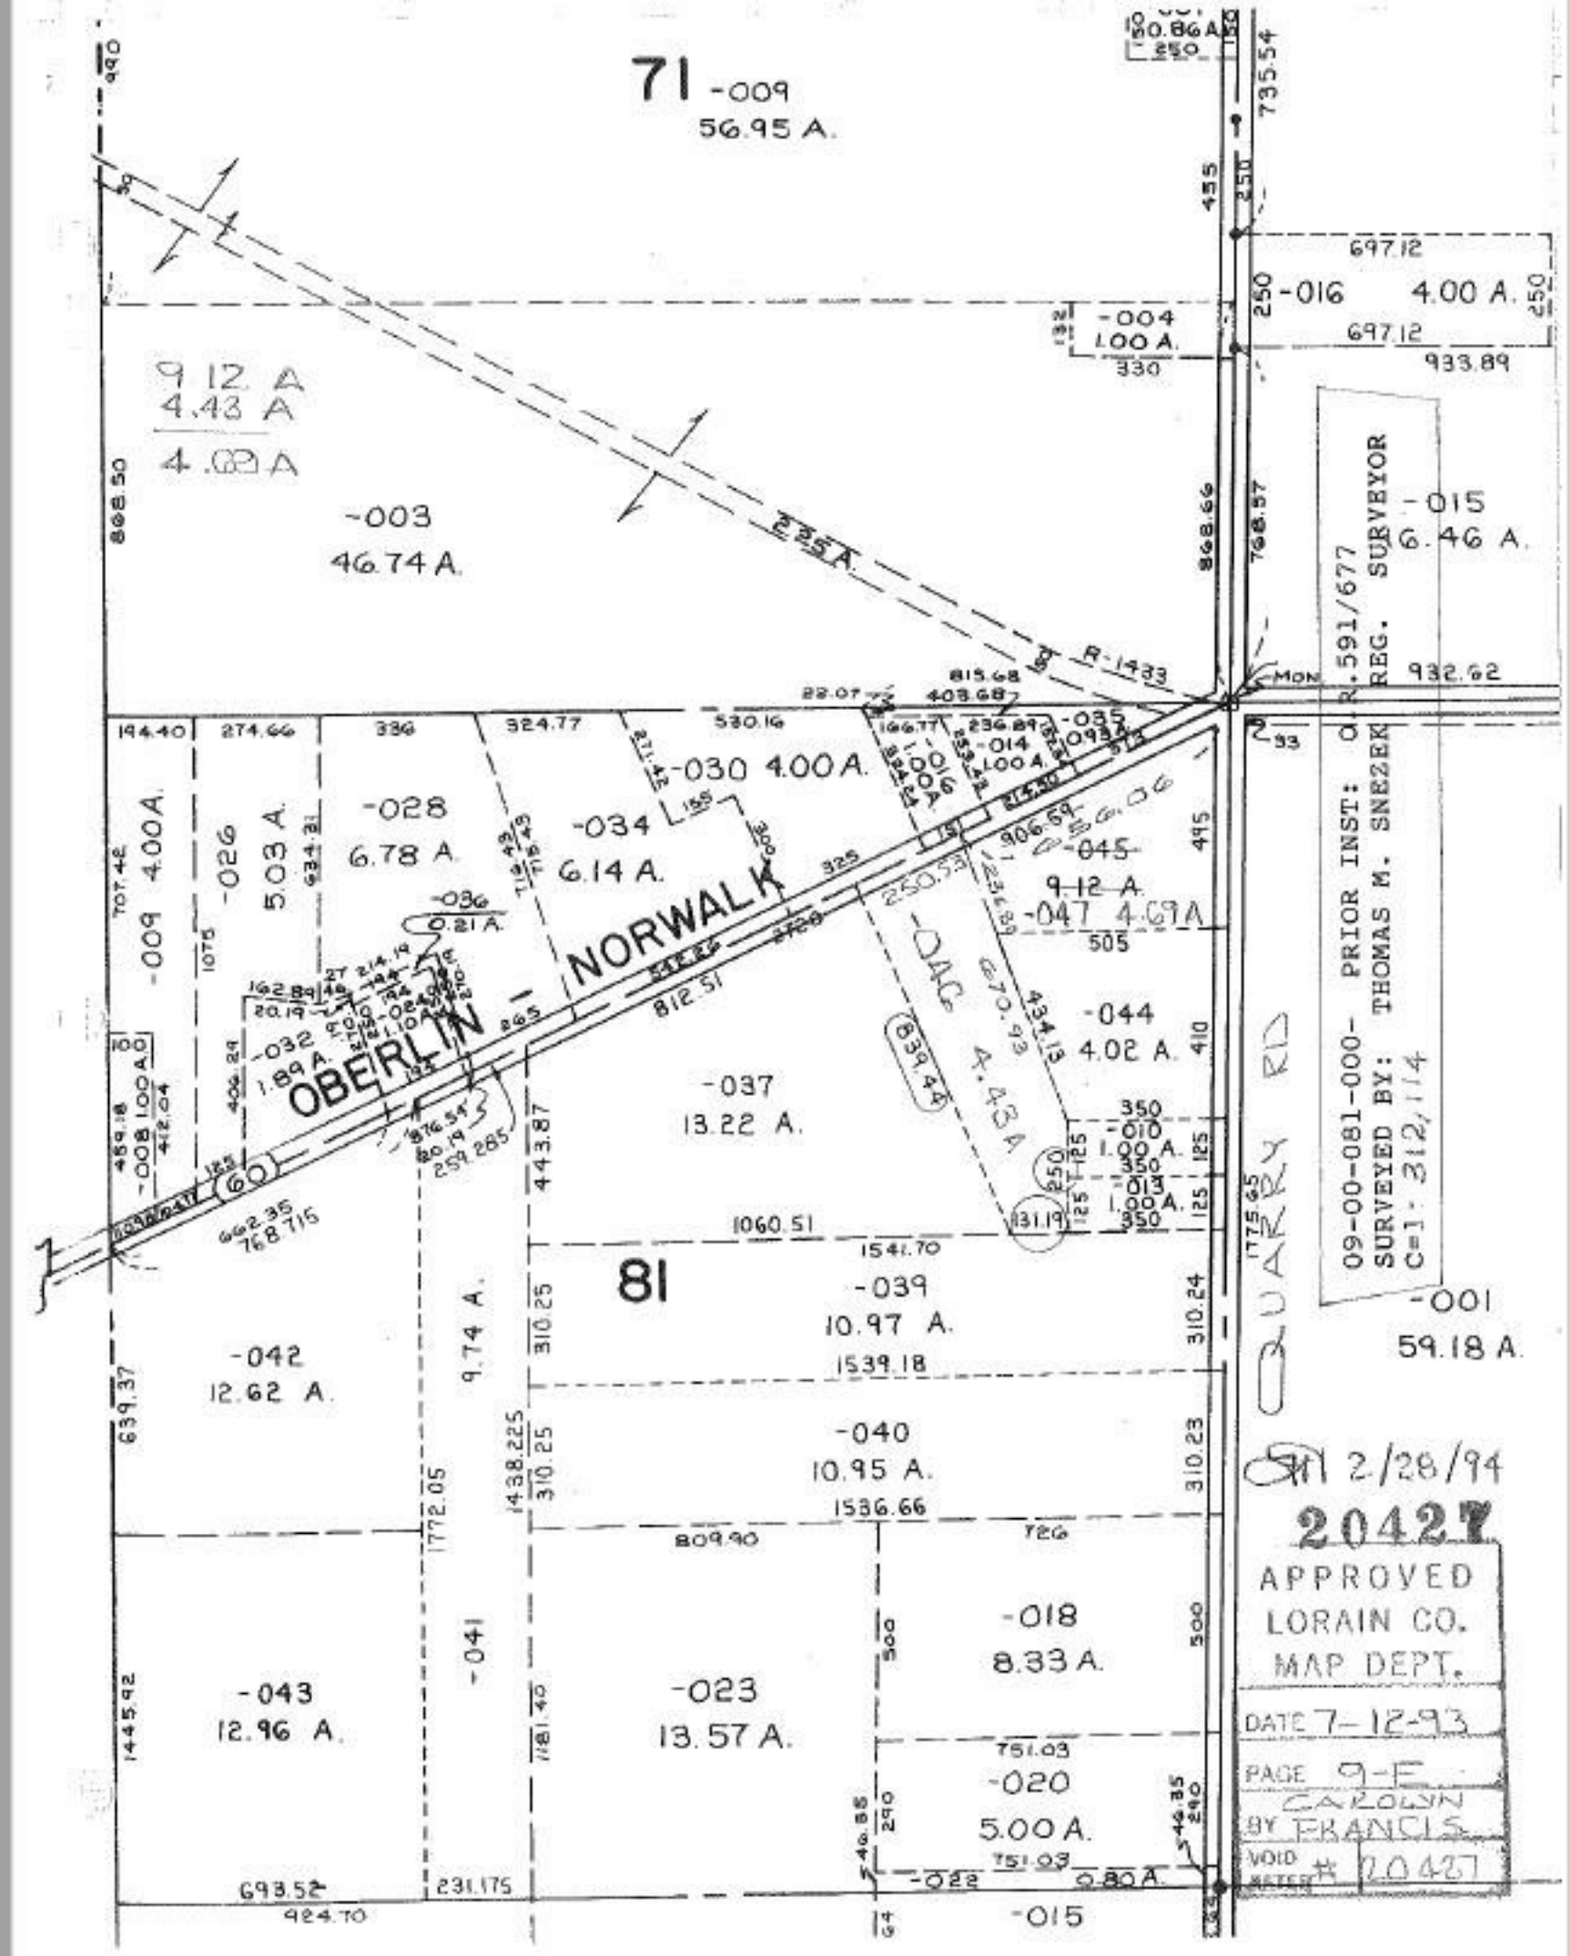
71 -009
56.95 A.
9.12 A
4.43 A
4.69 A
-003
46.74 A.
-016 4.00 A.
-004
1.00 A.
-015
6.46 A.
09-00-081-000- PRIOR INST: O.R. 591/677
SURVEYED BY: THOMAS M. SNEZEK REG. SURVEYOR
C=1: 312,114
-030 4.00 A.
-028
6.78 A.
-034
6.14 A.
-009 4.00 A.
-026
5.03 A.
-036
0.21 A.
OBERLIN - NORWALK
-045
9.12 A.
-047 4.69 A
-044
4.02 A.
-037
13.22 A.
-010
1.00 A.
-013
1.00 A.
81
-039
10.97 A.
-001
59.18 A.
-042
12.62 A.
9.74 A.
-040
10.95 A.
-041
-043
12.96 A.
-023
13.57 A.
-018
8.33 A.
-020
5.00 A.
-015
QUARRY RD
2/28/94
20427
APPROVED
LORAIN CO.
MAP DEPT.
DATE 7-12-93
PAGE 9-E
BY CAROLYN FRANCIS
VOID AFTER # 20427