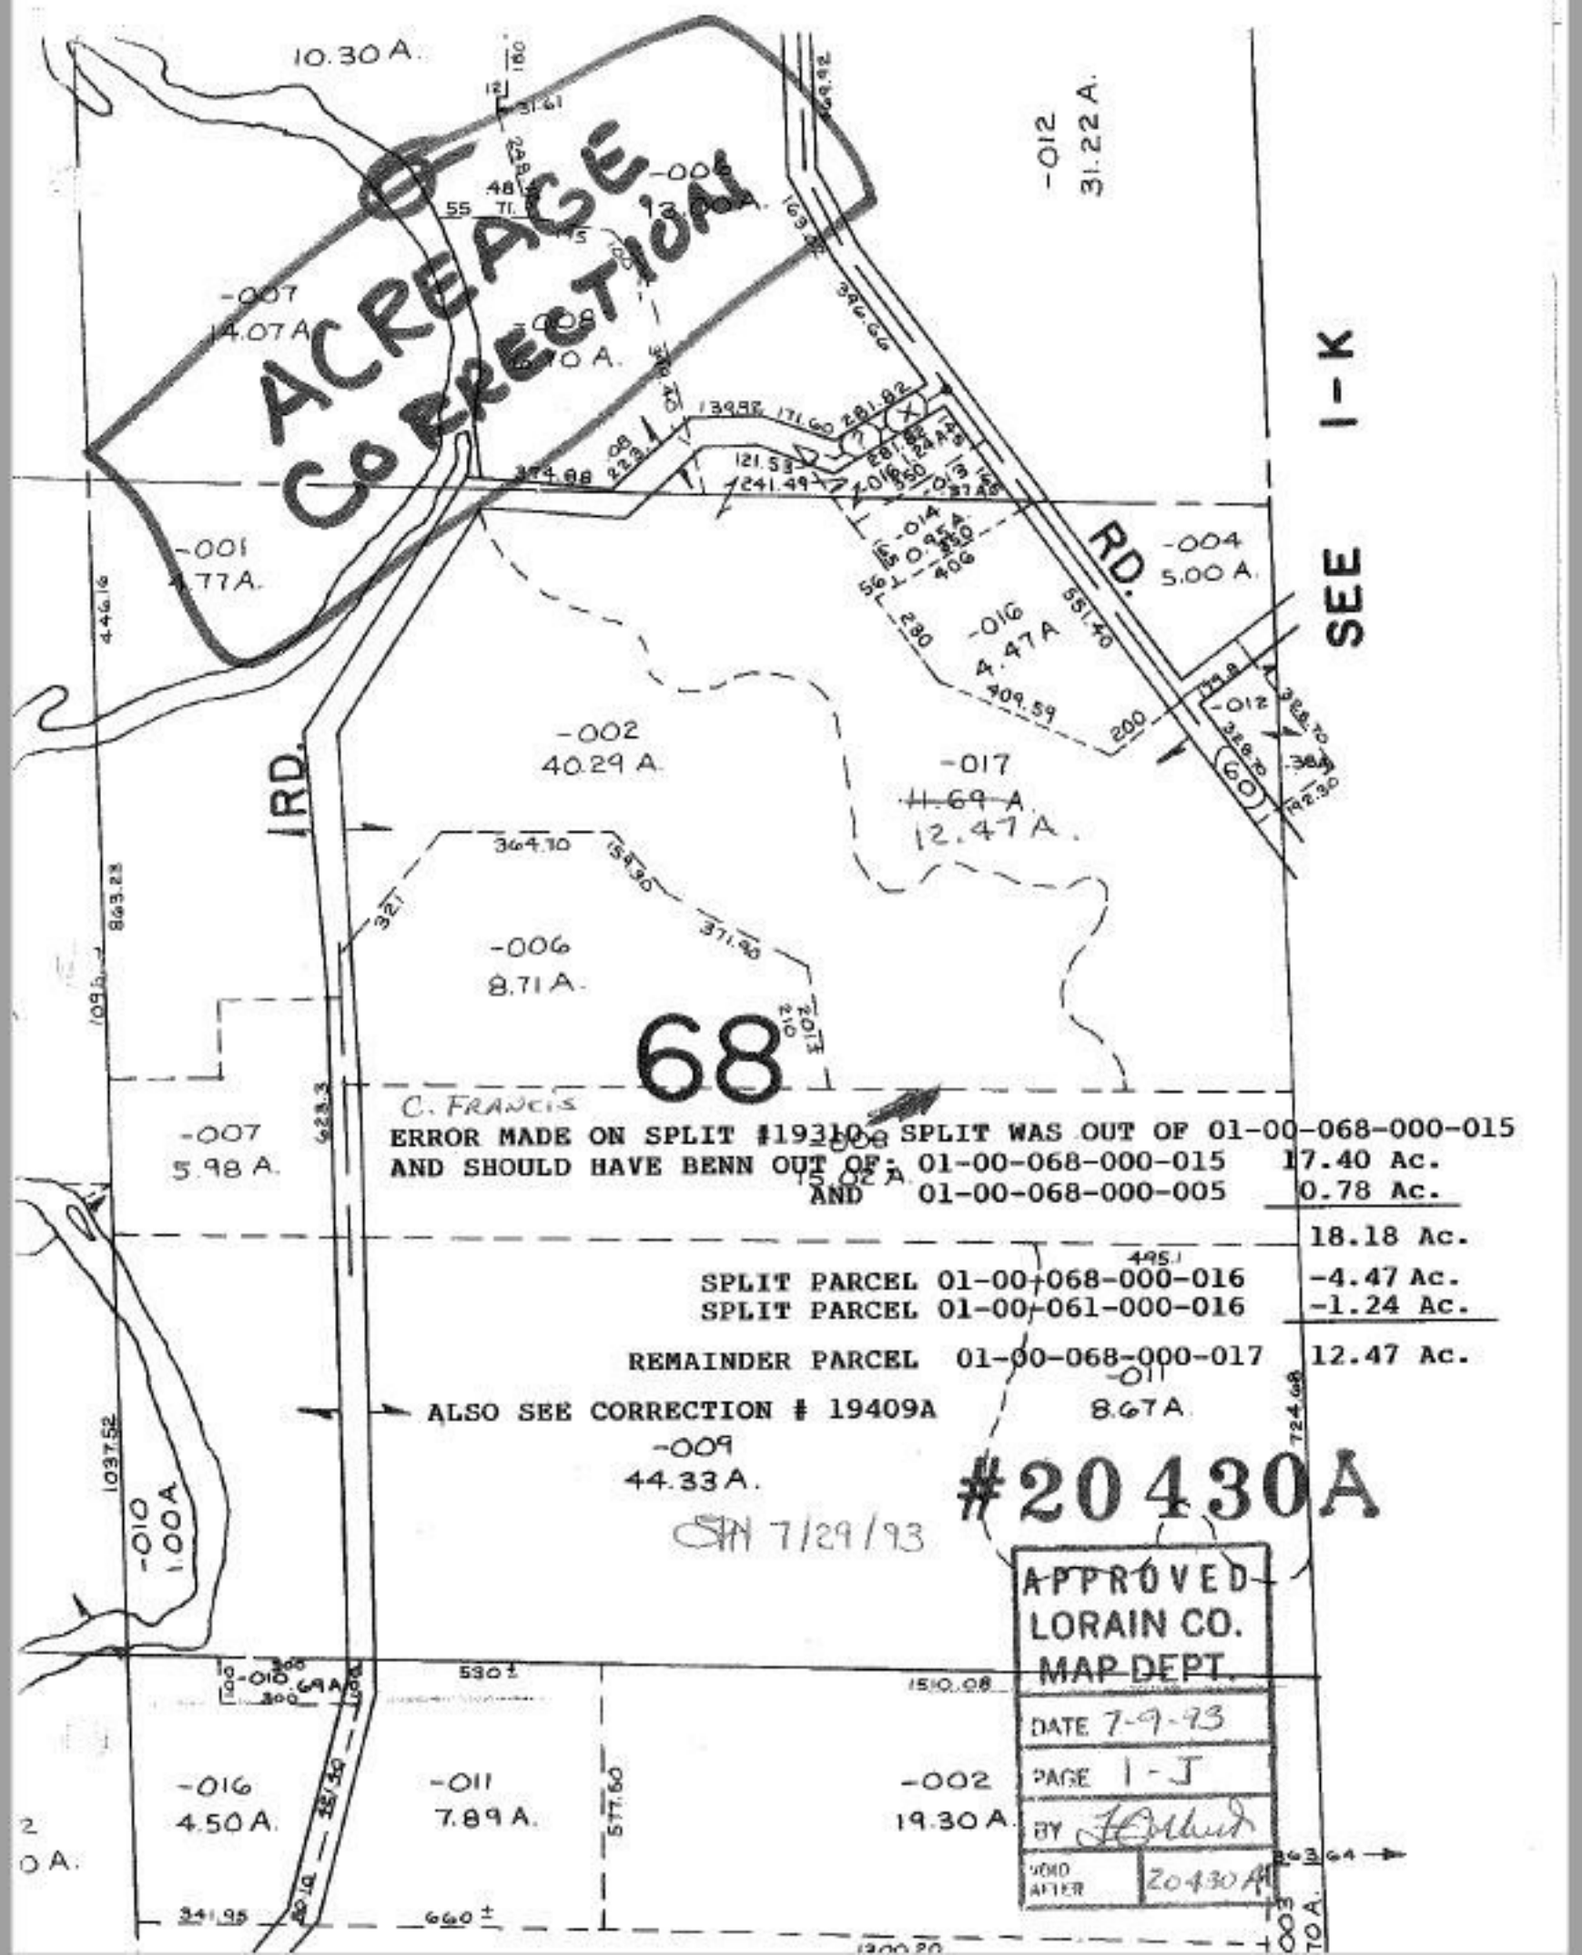
ACREAGE CORRECTION
10.30 A.
-007
14.07 A.
-008
-006
13.40 A.
-012
31.22 A.
-001
4.77 A.
-014
0.95 A.
-004
5.00 A.
-016
4.47 A.
-002
40.29 A.
-017
~~11.69 A~~
12.47 A.
-006
8.71 A.
68
-007
5.98 A.
-010
1.00 A.
-016
4.50 A.
-011
7.89 A.
-002
19.30 A.
-011
8.67 A.
-009
44.33 A.
IRD.
RD.
SEE I-K
C. FRANCIS
ERROR MADE ON SPLIT #19310 SPLIT WAS OUT OF 01-00-068-000-015
AND SHOULD HAVE BENN OUT OF: 01-00-068-000-015 17.40 Ac.
AND 01-00-068-000-005 0.78 Ac.
18.18 Ac.
SPLIT PARCEL 01-00-068-000-016 -4.47 Ac.
SPLIT PARCEL 01-00-061-000-016 -1.24 Ac.
REMAINDER PARCEL 01-00-068-000-017 12.47 Ac.
ALSO SEE CORRECTION # 19409A
SM 7/29/93
#20430A
APPROVED
LORAIN CO.
MAP DEPT.
DATE 7-9-93
PAGE 1-J
BY
VOID AFTER 20430A