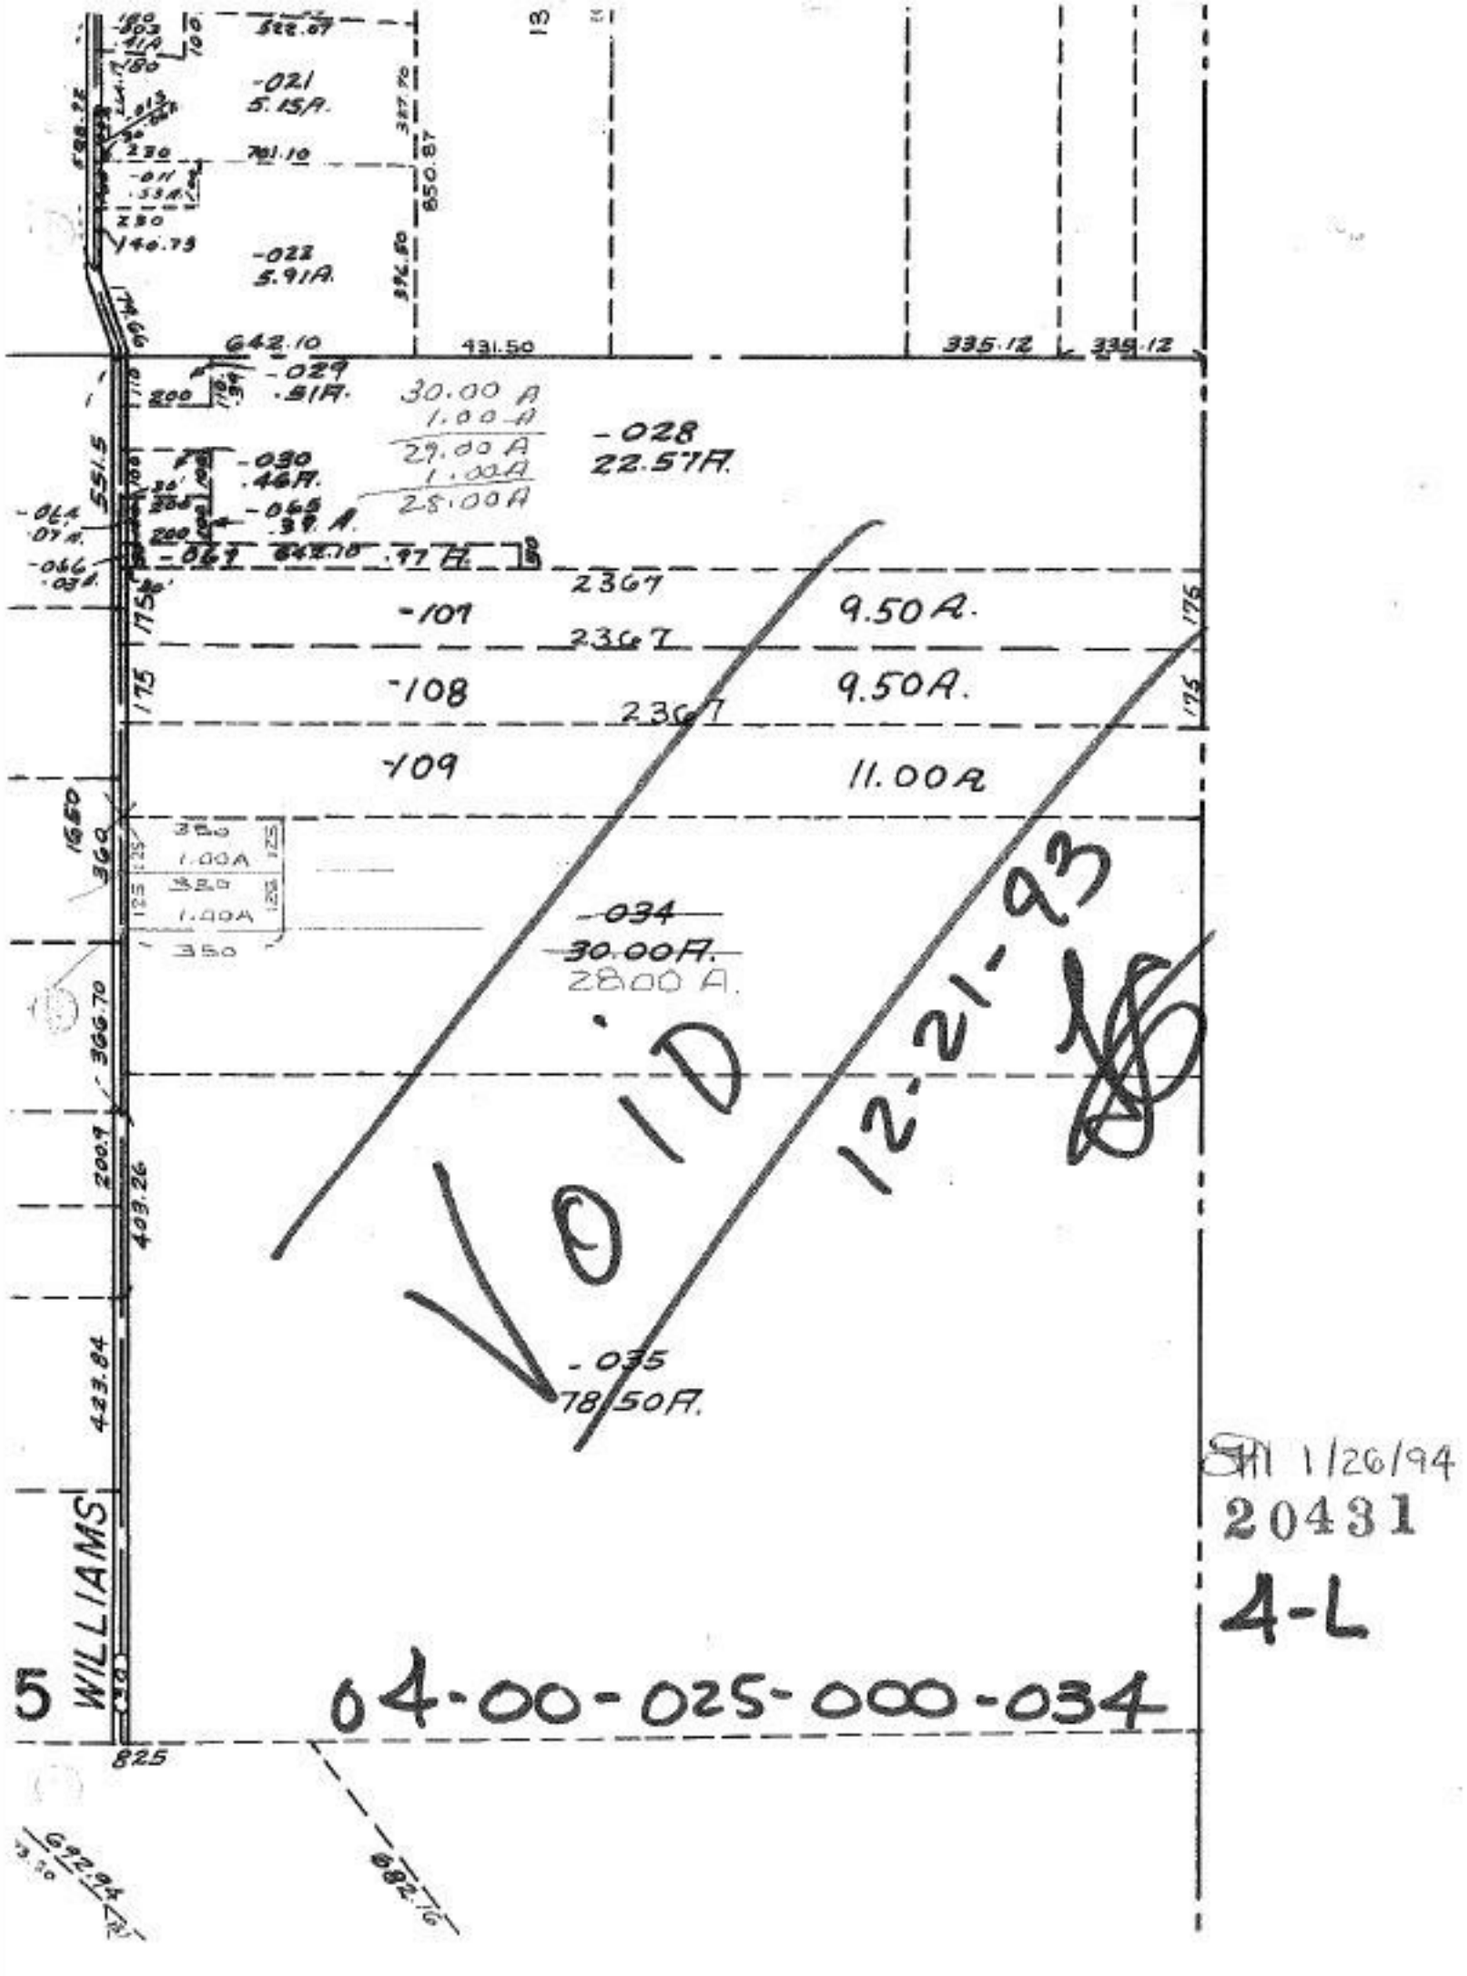
-021
5.15A.
-022
5.91A.
-029
.91A.
-030
.46A.
-028
22.57A.
30.00 A
1.00 A
29.00 A
1.00 A
28.00 A
-107
-108
-109
9.50A.
9.50A.
11.00A.
-034
30.00A.
28.00 A.
-035
78.50A.
VOID
12-21-93
WILLIAMS
04-00-025-000-034
SH 1/26/94
20431
4-L