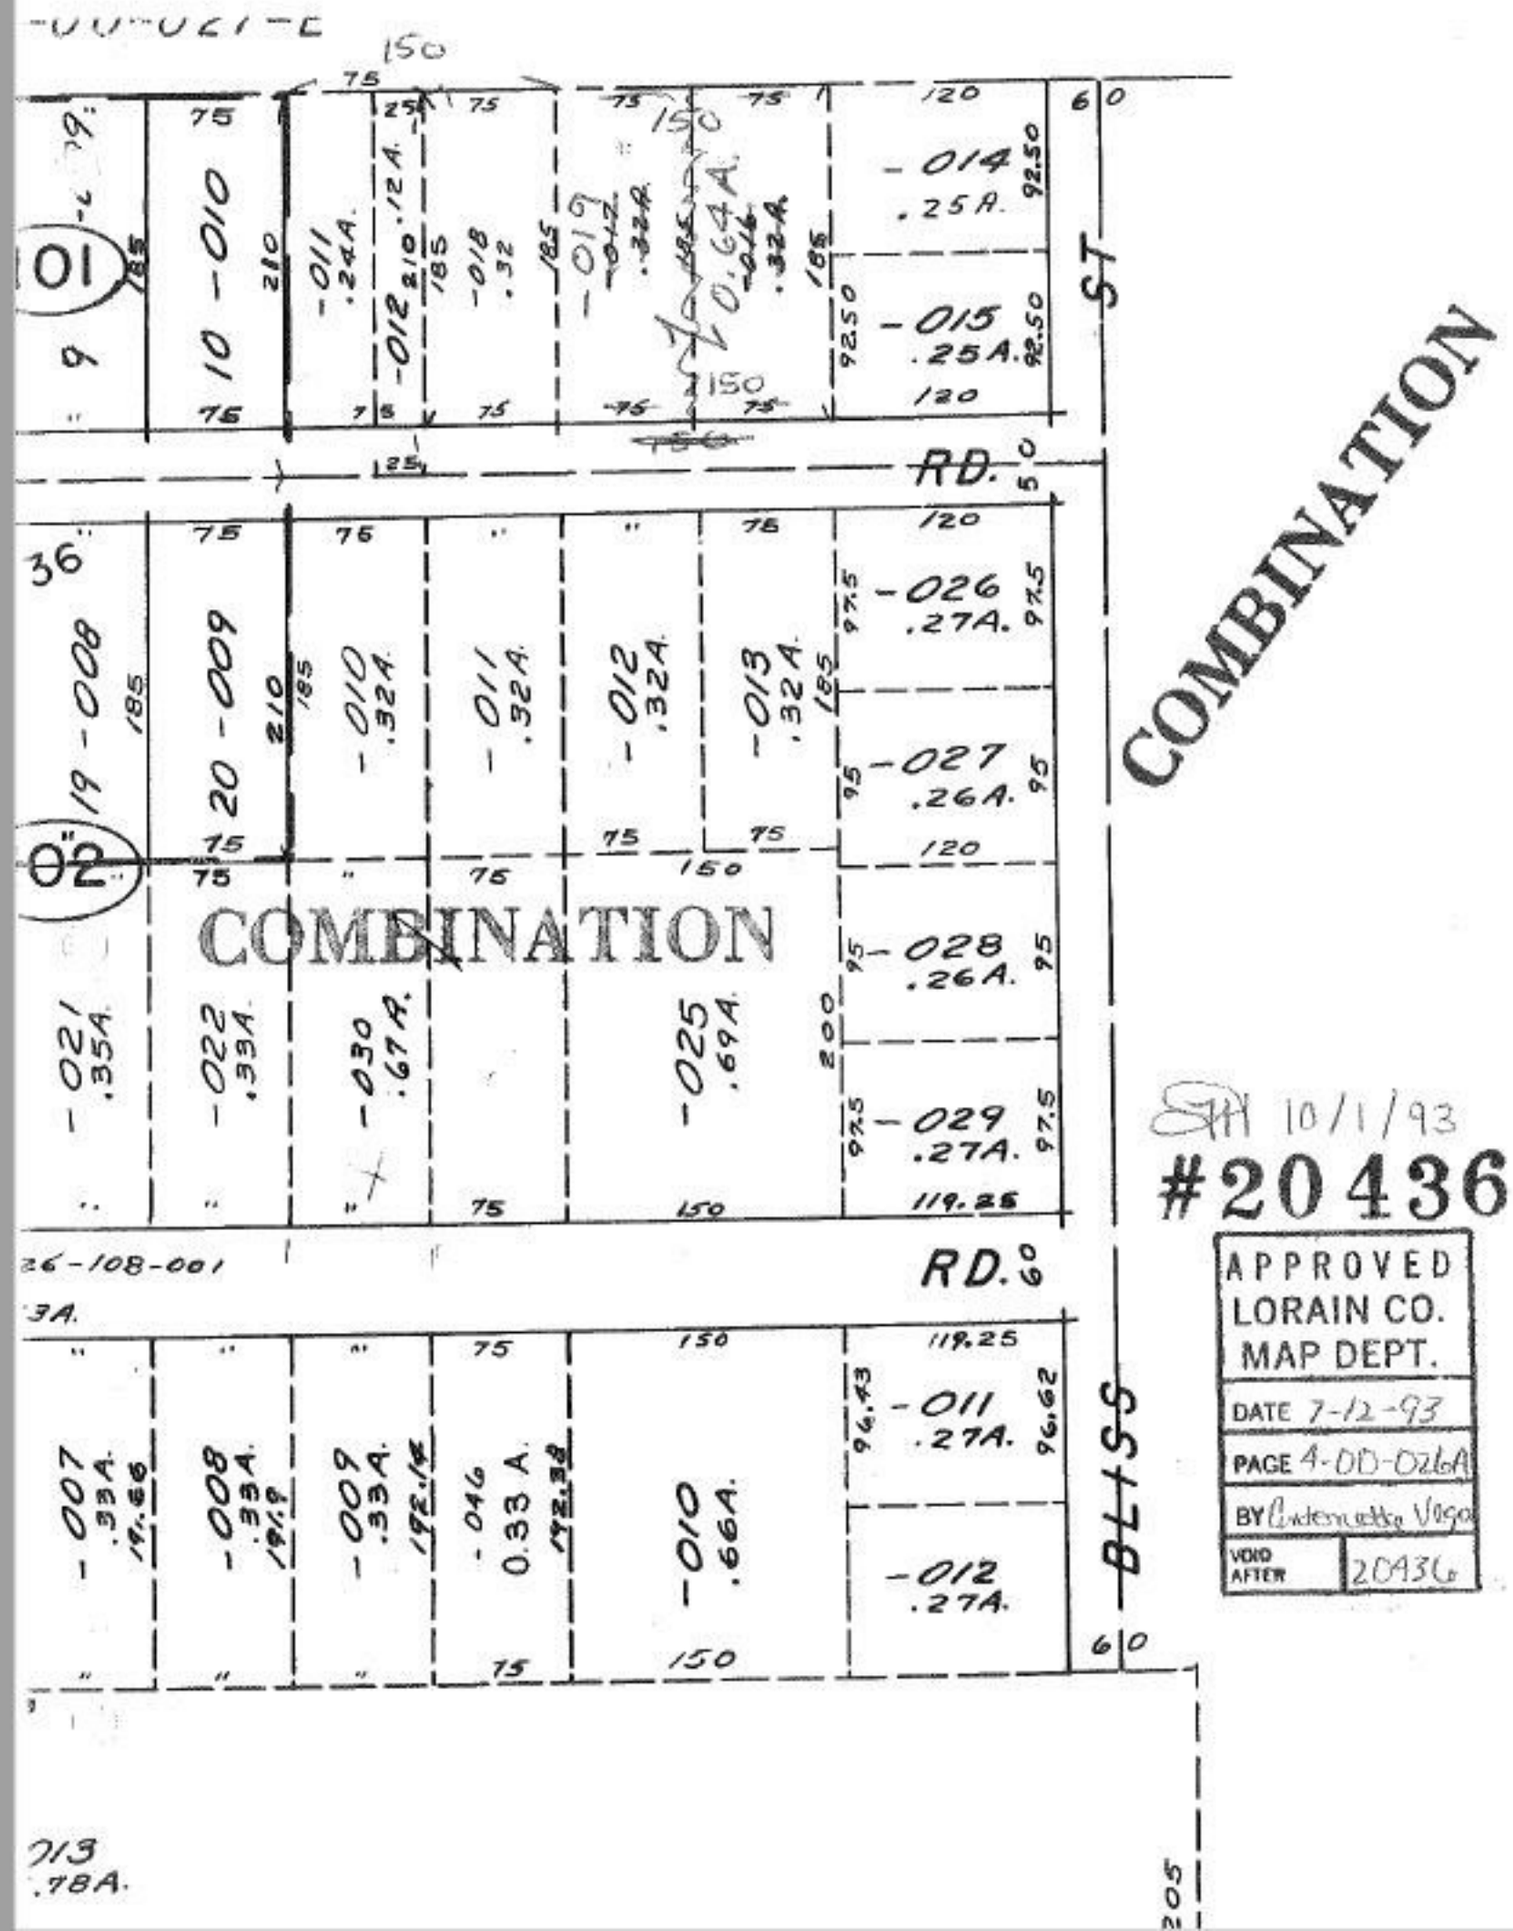

COMBINATION

SH 10/1/93

#20436

APPROVED
LORAIN CO.
MAP DEPT.

DATE 7-12-93

PAGE 4-00-026A

BY Carlemaddie Vega

VOID AFTER 20436