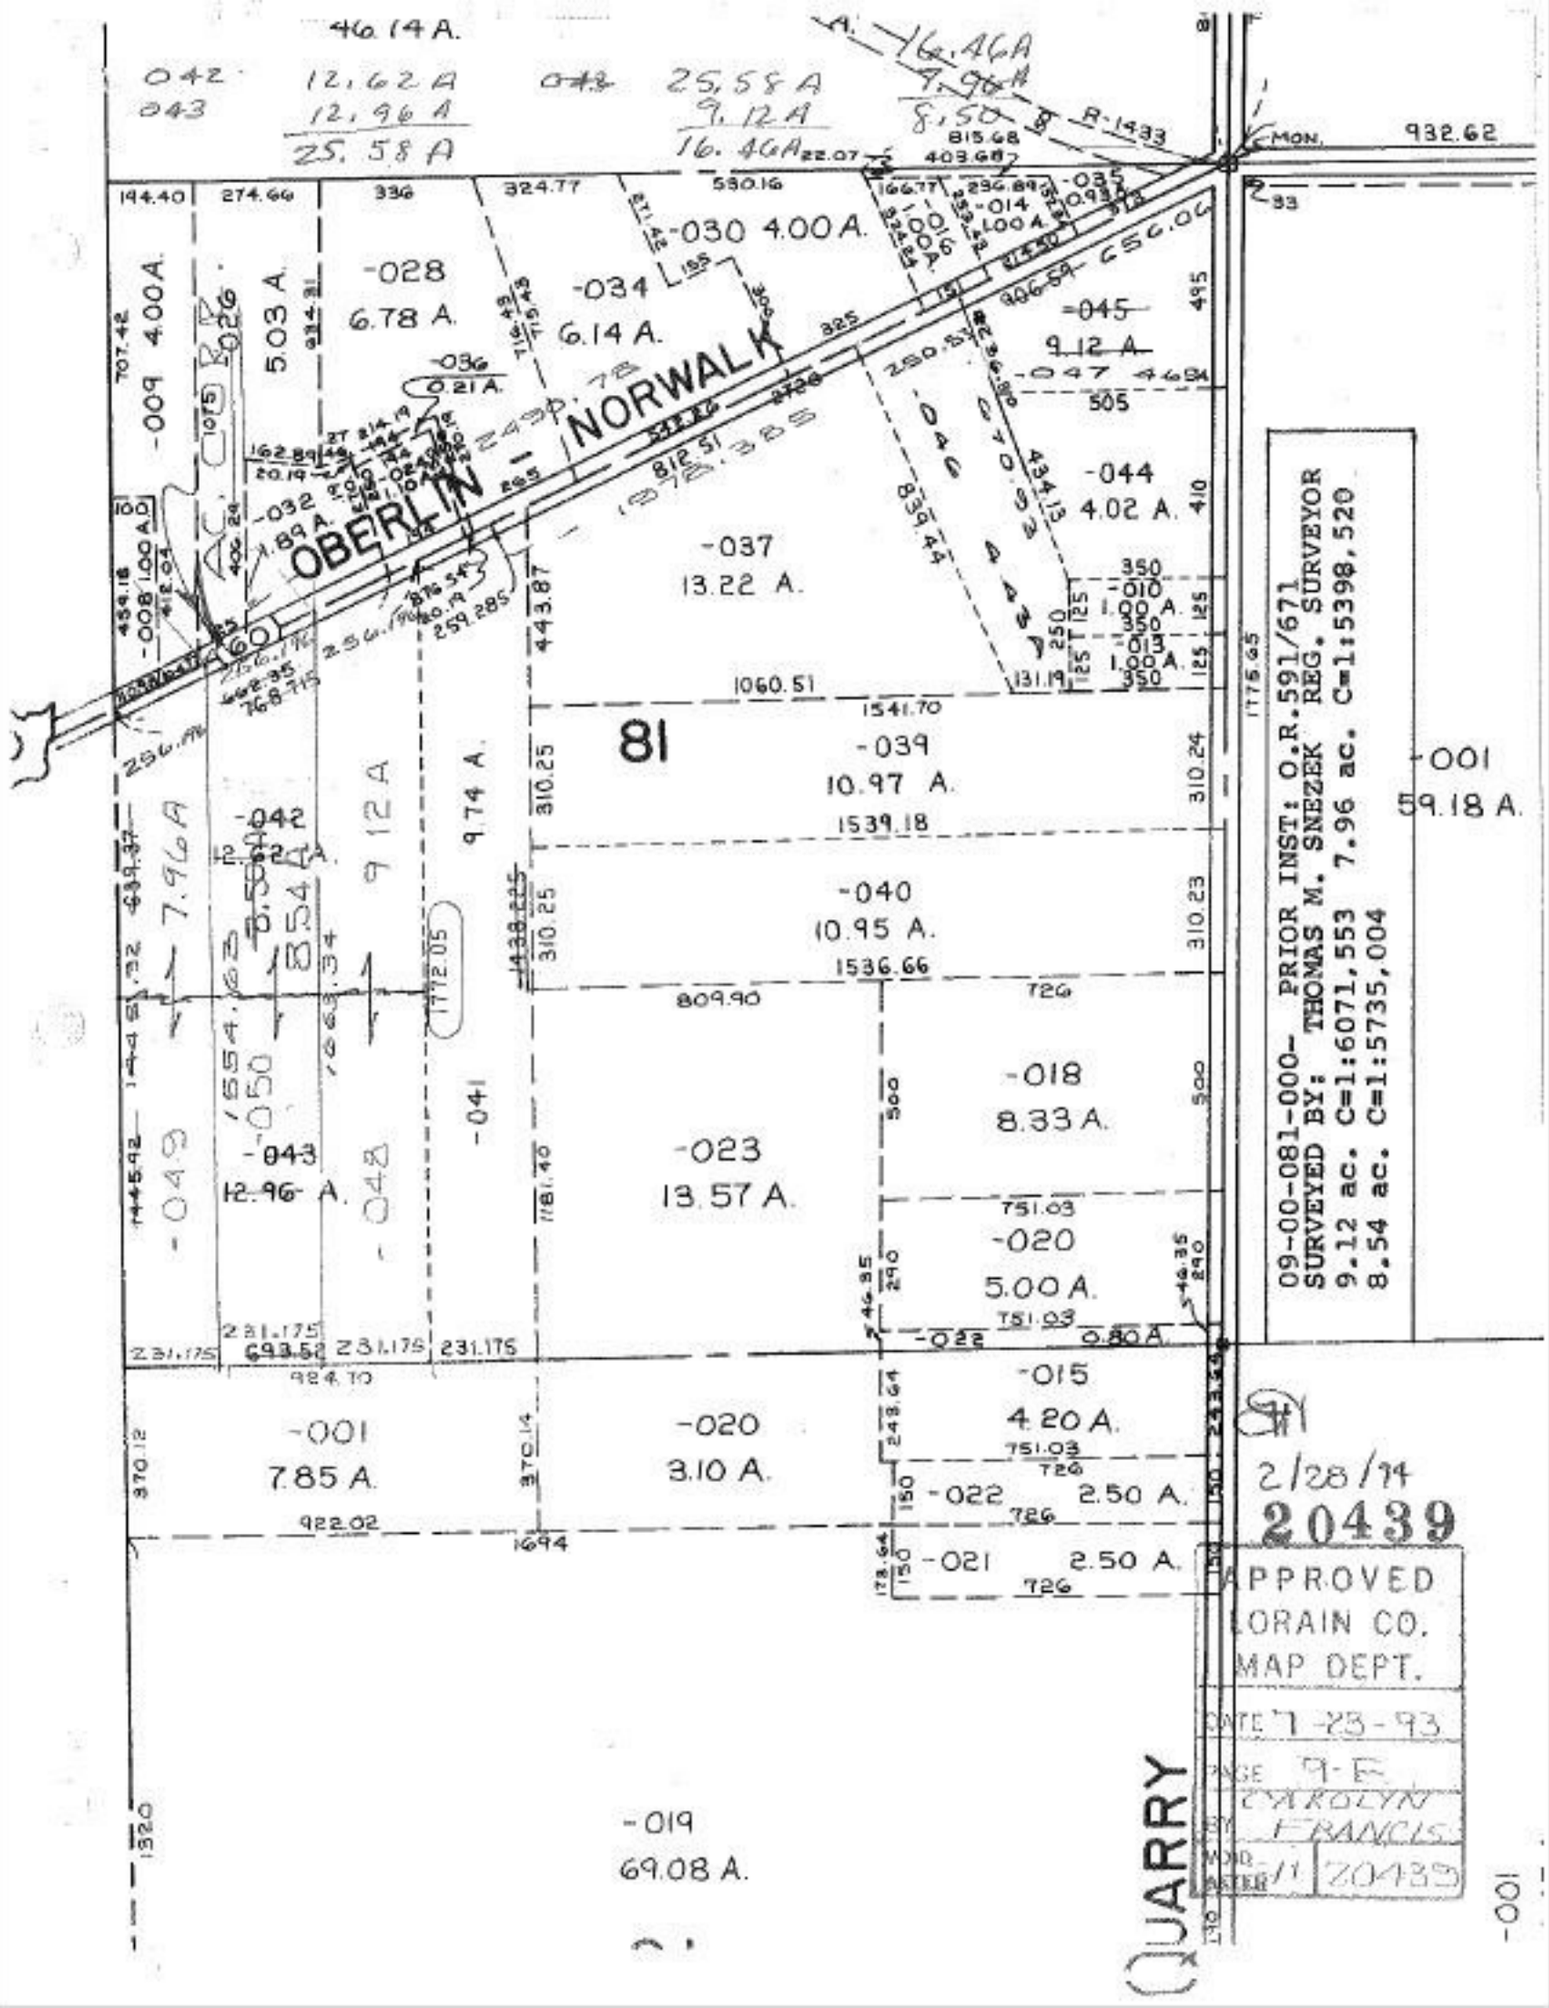

OBERLIN - NORWALK
81
-030 4.00 A.
-028 6.78 A.
-034 6.14 A.
-045 9.12 A.
-044 4.02 A.
-037 13.22 A.
-039 10.97 A.
-040 10.95 A.
-001 59.18 A.
-018 8.33 A.
-023 13.57 A.
-020 5.00 A.
-015 4.20 A.
-022 2.50 A.
-021 2.50 A.
-020 3.10 A.
-001 7.85 A.
-019 69.08 A.
-042 12.62 A.
-043 12.96 A.
-009 4.00 A.
-008 1.00 A.
-010 1.00 A.
-013 1.00 A.
-014 1.00 A.
-036 0.21 A.
-032 1.89 A.
-041 9.74 A.
-049 7.96 A.
-050 8.54 A.
-048 9.12 A.
-046 4.43 A.
-047 4.69 A.
-035 0.93 A.
-016 1.00 A.
-022 0.80 A.
R-1433
MON.
932.62
QUARRY
09-00-081-000- PRIOR INST: O.R.591/671
SURVEYED BY: THOMAS M. SNEZEK REG. SURVEYOR
9.12 ac. C=1:6071,553 7.96 ac. C=1:5398,520
8.54 ac. C=1:5735,004
2/28/94
20439
APPROVED
LORAIN CO.
MAP DEPT.
DATE 7-23-93
PAGE 9-E
BY CAROLYN FRANCIS
WORD NUMBER 11 20439