1.95A
1.73A
3.68A
2.21A
1.47A

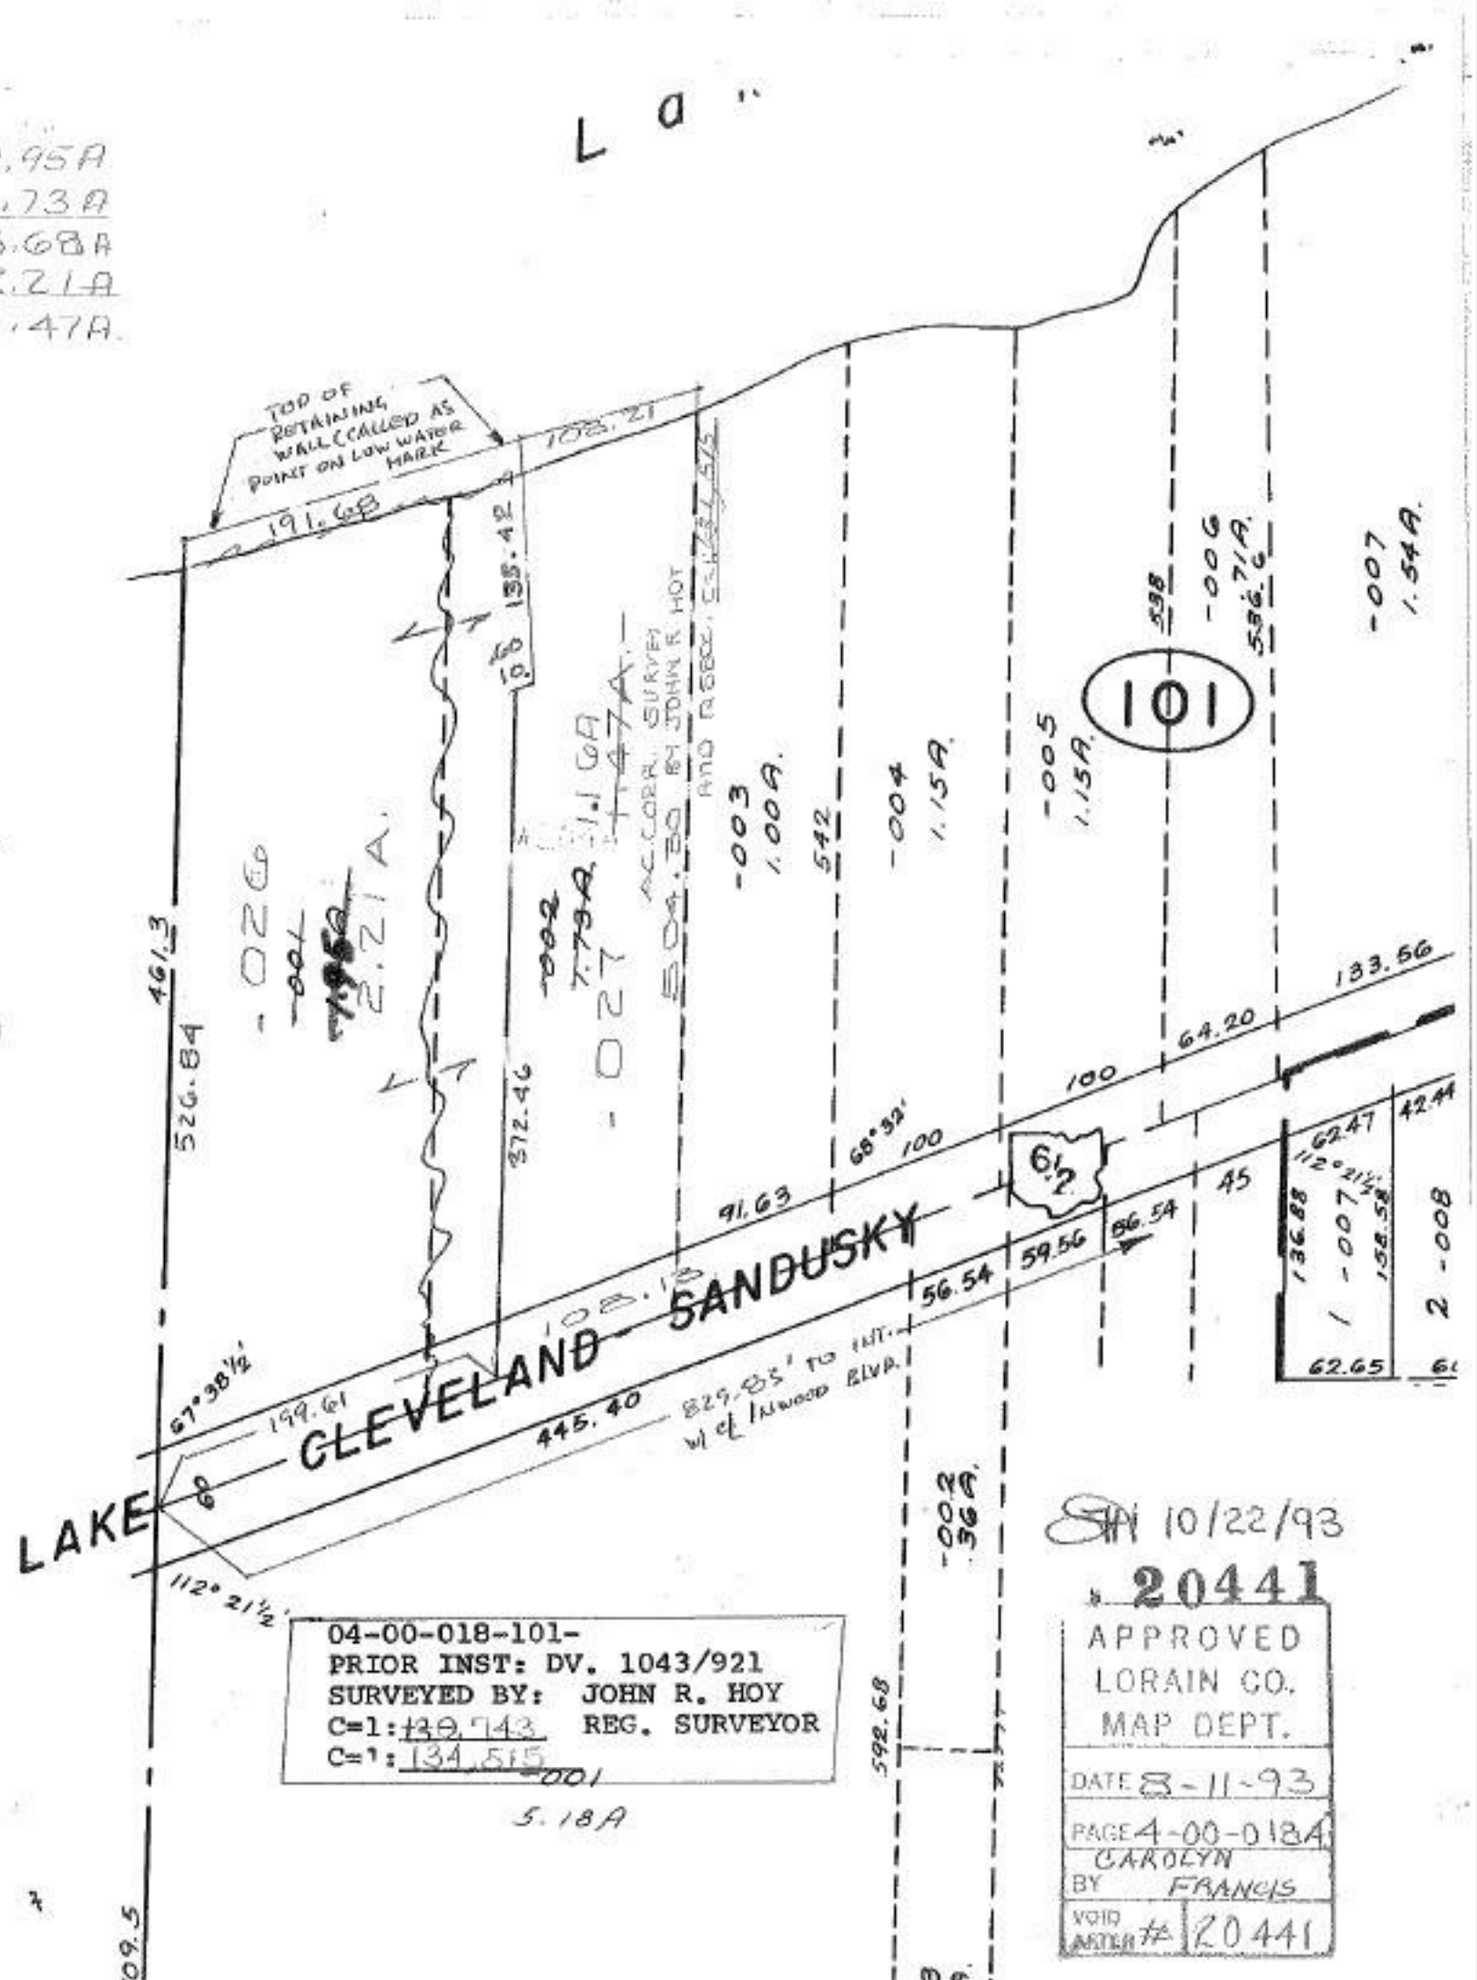

04-00-018-101-
PRIOR INST: DV. 1043/921
SURVEYED BY: JOHN R. HOY
C=1: ~~139.743~~ REG. SURVEYOR
C=1: 134.515 -001

5.18A

SH 10/22/93

20441

APPROVED
LORAIN CO.
MAP DEPT.
DATE 8-11-93
PAGE 4-00-018A
BY CAROLYN FRANCIS
VOID AFTER # 20441