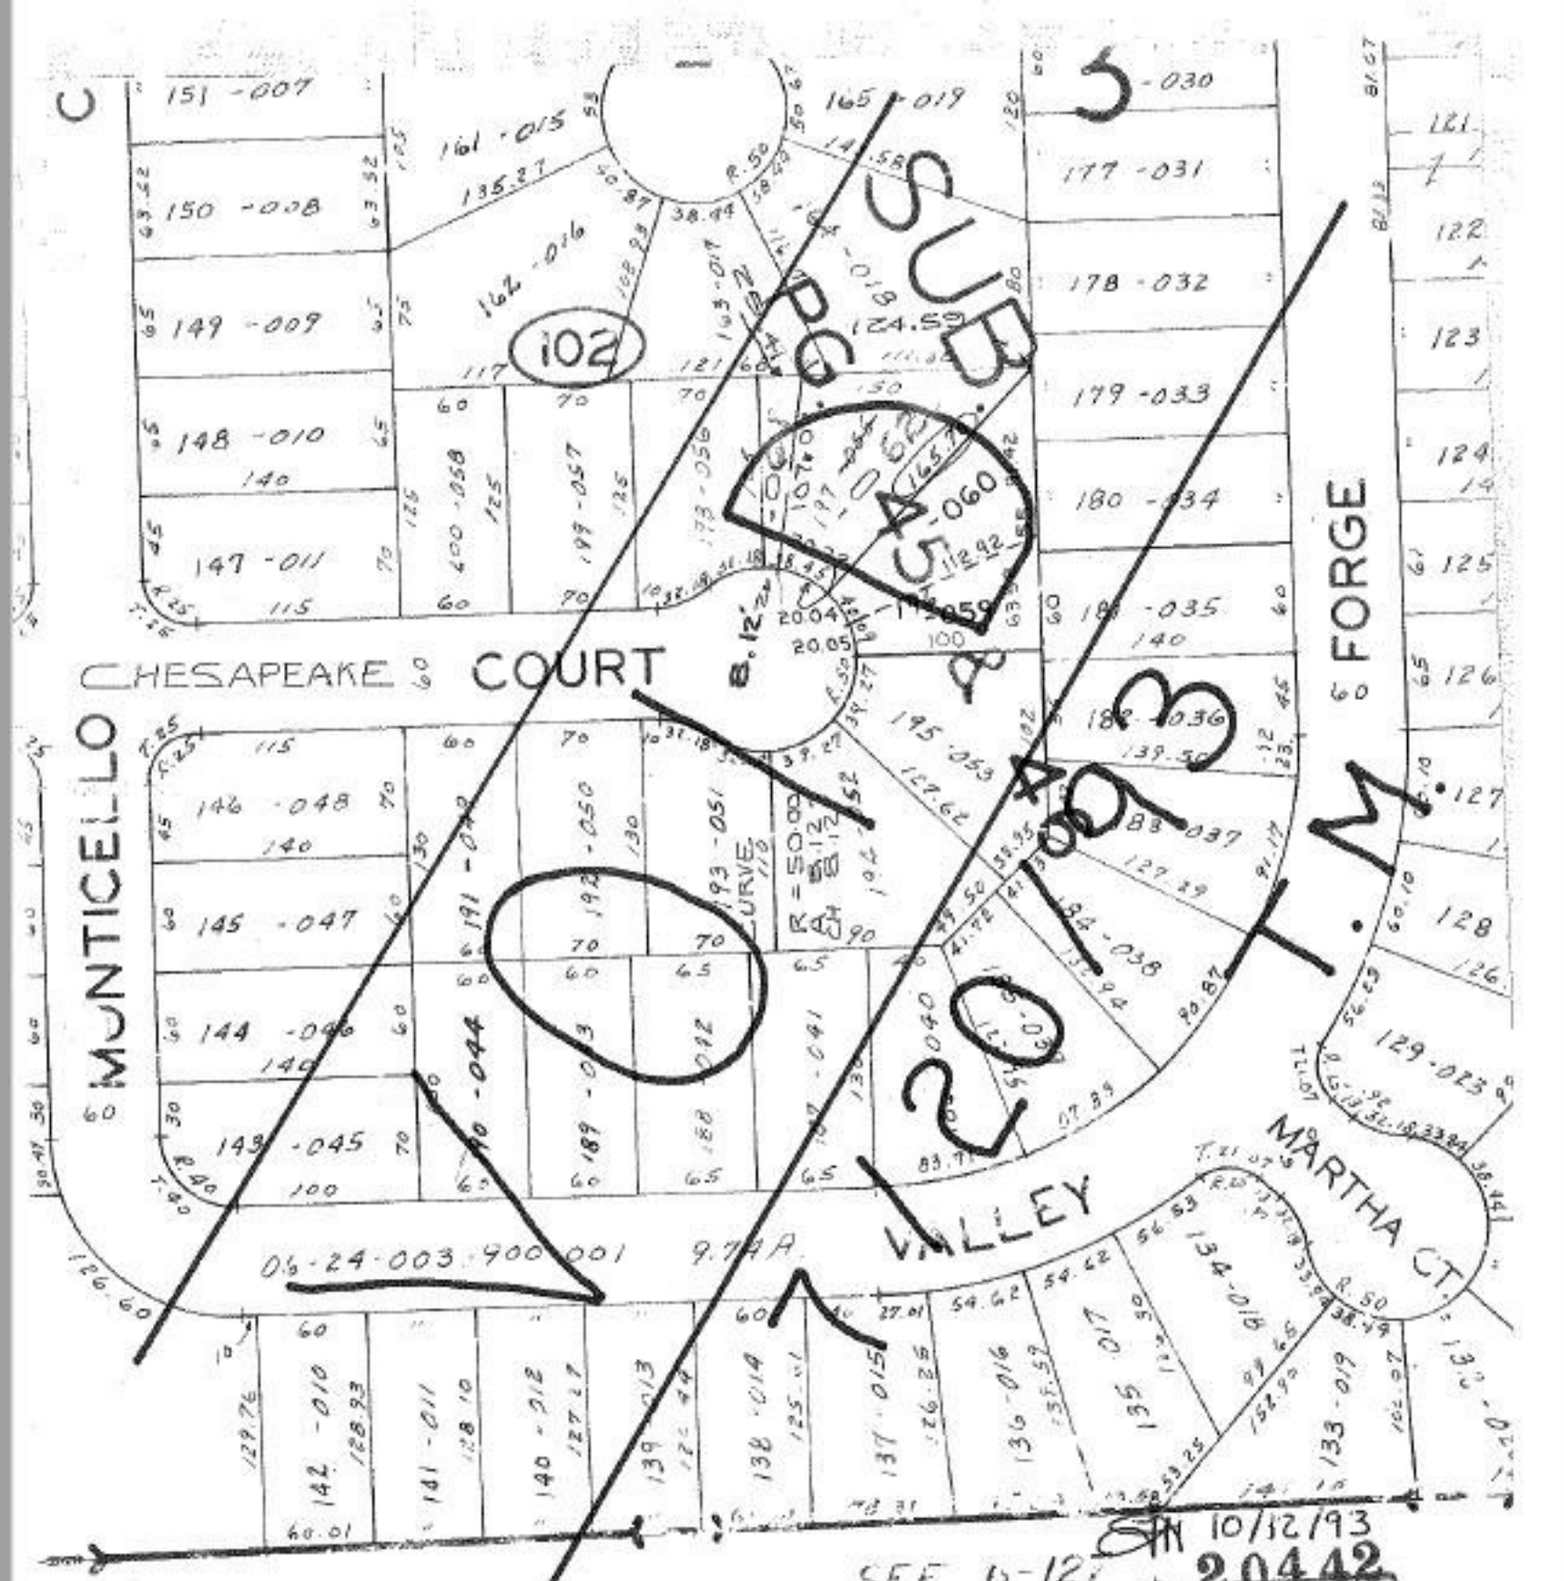
CHESAPEAKE COURT
MONTICELLO
FORGE
MARTHA CT.
VALLEY
06-24-003-900-001 9.74A.
SEE 6-121
SUB
PG. 45
20
43
102
10/12/93
20442
APPROVED
LORAIN CO.
MAP DEPT.
DATE 7-14-93
PAGE 6-109
BY CAROLYN FRANCIS
VOID AFTER # 20442
06-24-003-102- PRIOR INST: 1179/590
SURVEYED BY: KS ASSOC.
C=1:43,734
RIVER W·LY PT. LOT 3
LOT 16 S·LY PT. LOT 17