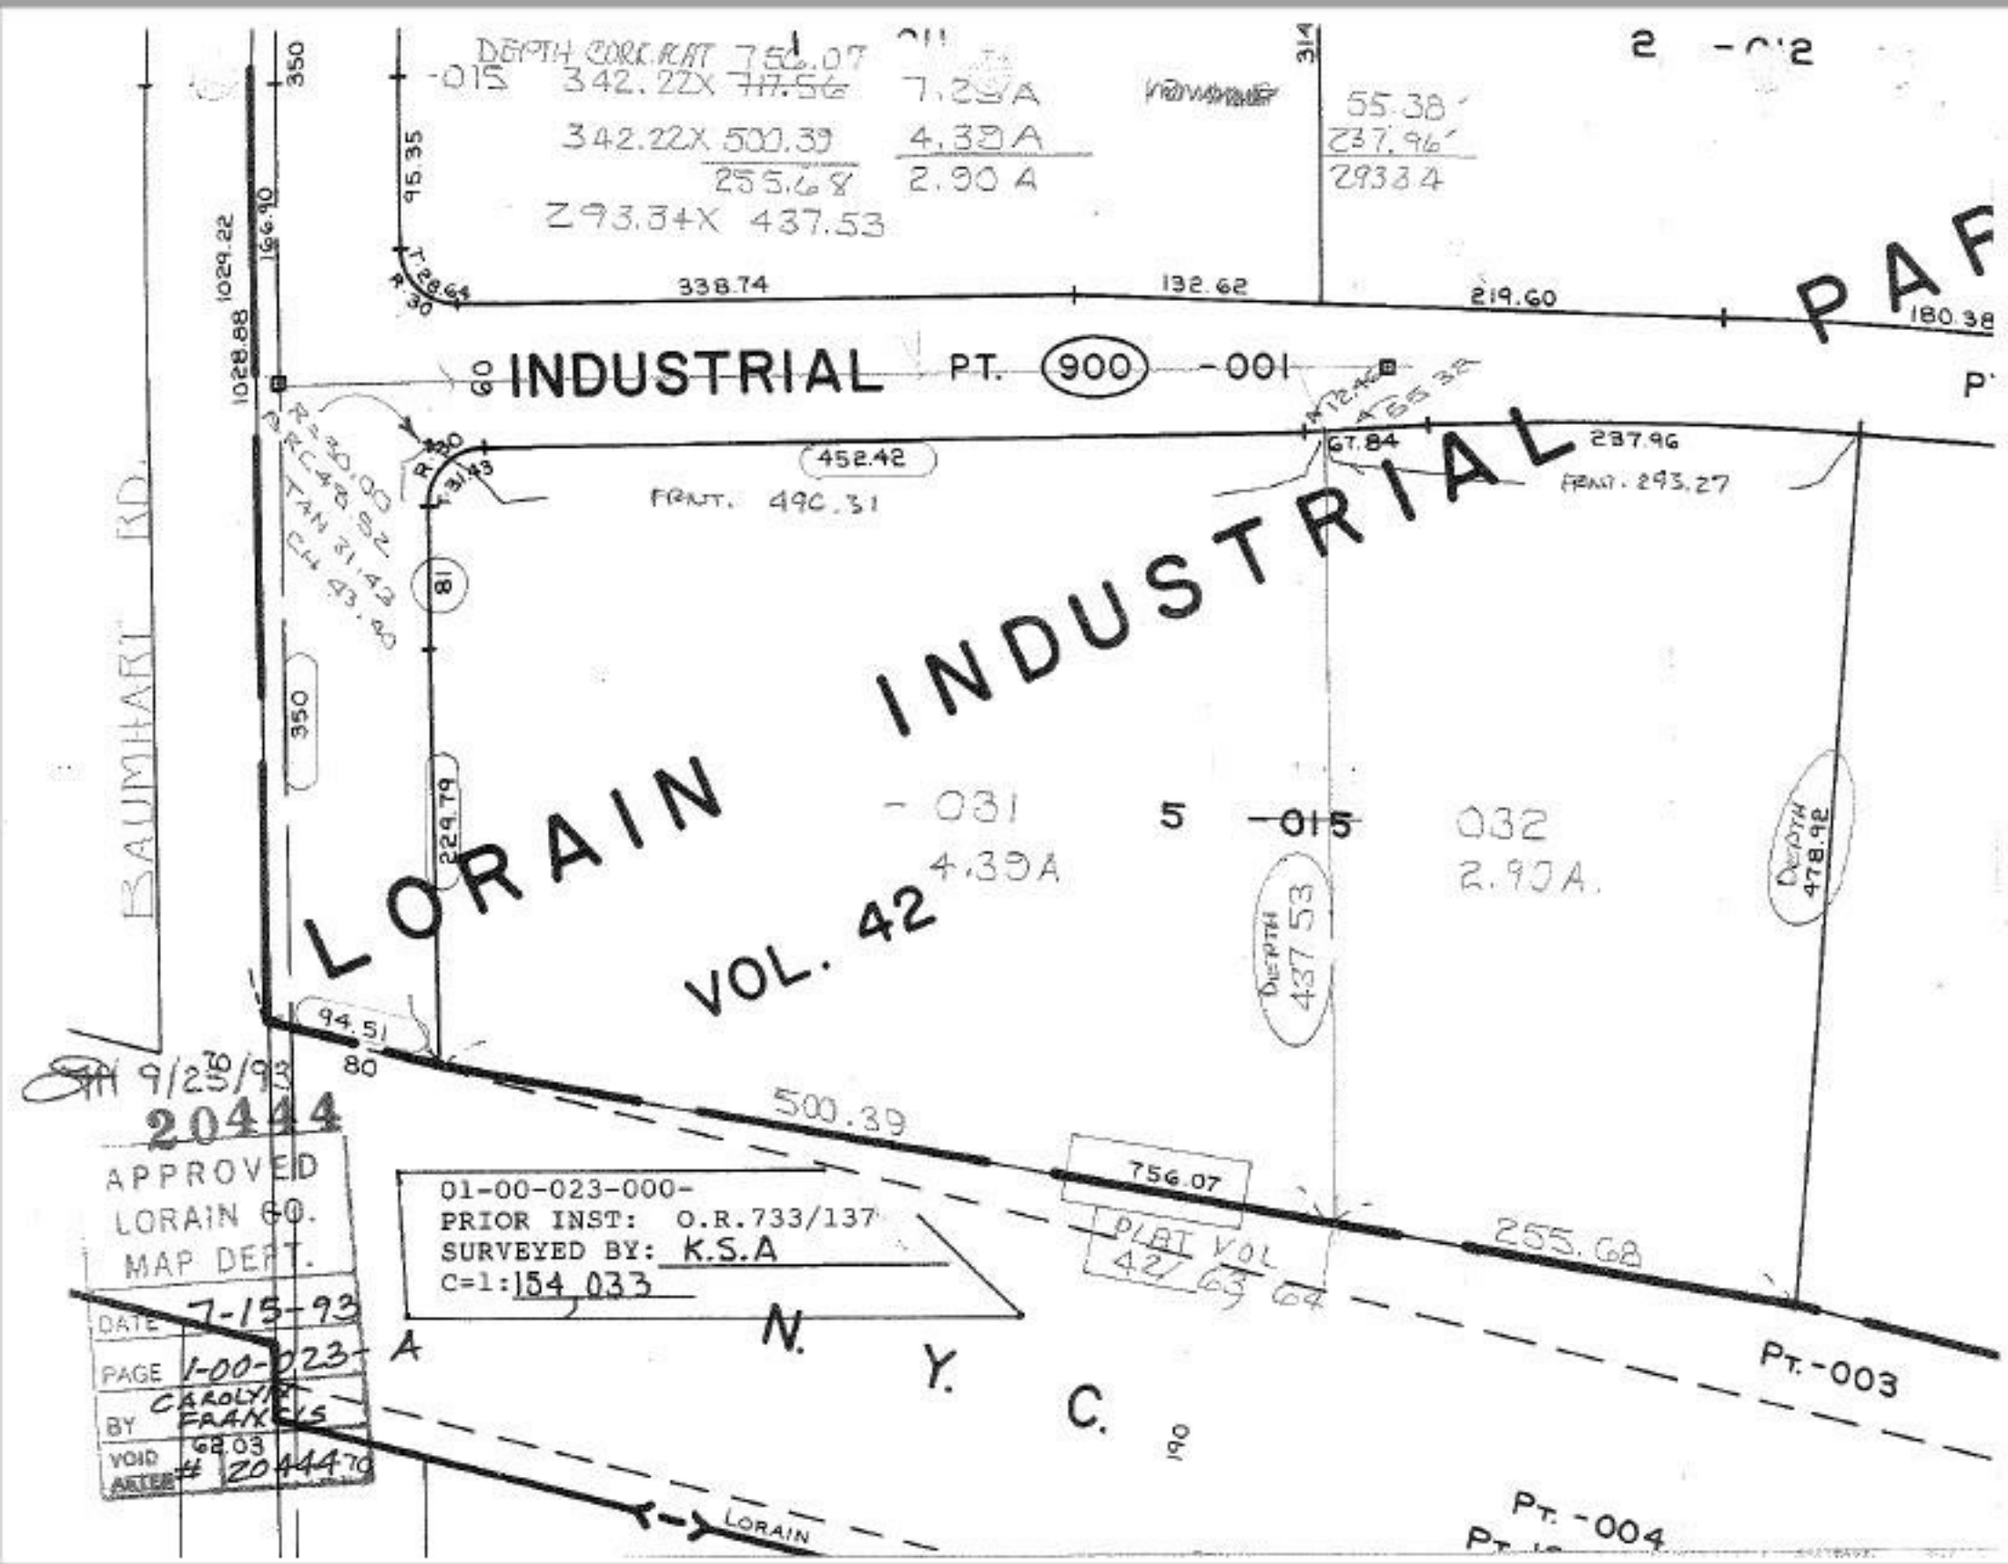

DEPTH CORR. PLAT 756.07
-015 342.22X 717.56 7.29A
342.22X 500.39 4.39A
255.68 2.90 A
293.34X 437.53
55.38
237.96
293.34
338.74
132.62
219.60
180.38
INDUSTRIAL PT. 900 -001
452.42
FRNT. 490.31
67.84
237.96
FRNT. 293.27
LORAIN INDUSTRIAL PAR
VOL. 42
BAUMHART RD.
-031
4.39A
5 -015
032
2.90A.
DEPTH 437.53
DEPTH 478.92
94.51
500.39
756.07
PLAT VOL 42/63 64
255.68
PT.-003
PT.-004
N. Y. C.
LORAIN
9/25/93
20444
APPROVED
LORAIN CO.
MAP DEPT.
DATE 7-15-93
PAGE 1-00-023-
BY CAROLYN FRANCIS
VOID 62.03
ARTER # 20444 70
01-00-023-000-
PRIOR INST: O.R.733/137
SURVEYED BY: K.S.A
C=1:154,033