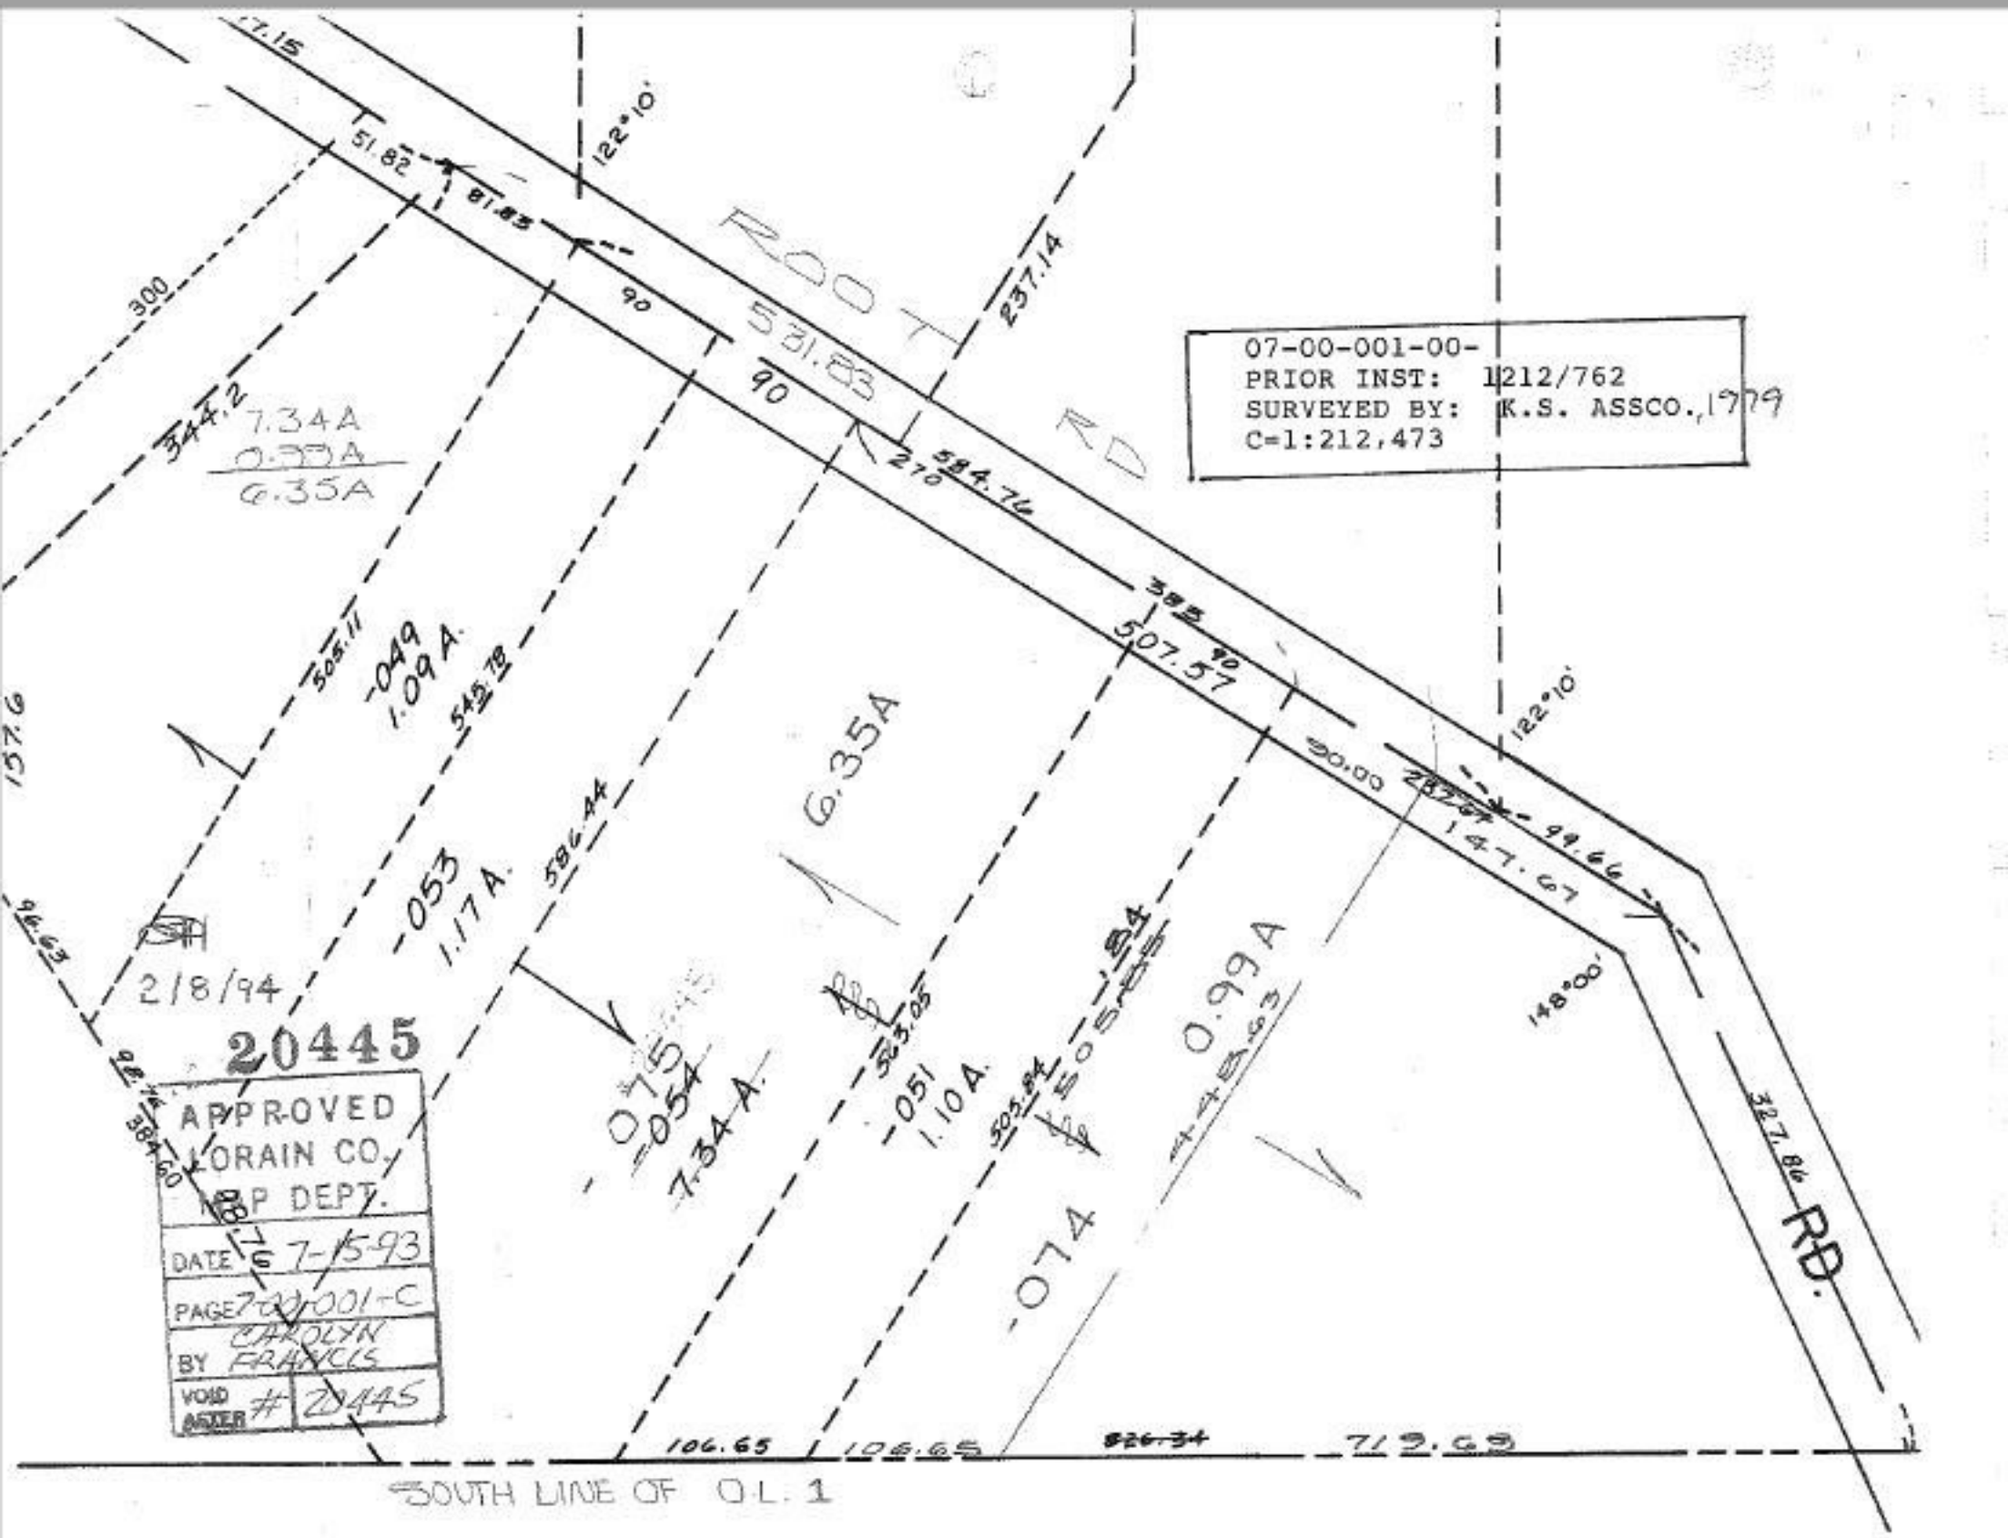
07-00-001-00-
PRIOR INST: 1212/762
SURVEYED BY: K.S. ASSCO., 1979
C=1:212,473
ROOT RD
RD.
531.83
584.76
507.57
6.35A
7.34A
0.99A
1.09A
1.17A
1.10A
2/8/94
20445
APPROVED
LORAIN CO.
MAP DEPT.
DATE 7-15-93
PAGE 7-00-001-C
BY CAROLYN FRANCIS
VOID AFTER # 20445
SOUTH LINE OF O.L. 1
106.65
106.65
719.69
122°10'
148°00'
327.86
300
344.2
505.11
545.78
586.44
563.05
505.84
90.00
99.66
147.67
237.14
51.82
81.83
90
270
385
96.63
98.76
384.60
157.6