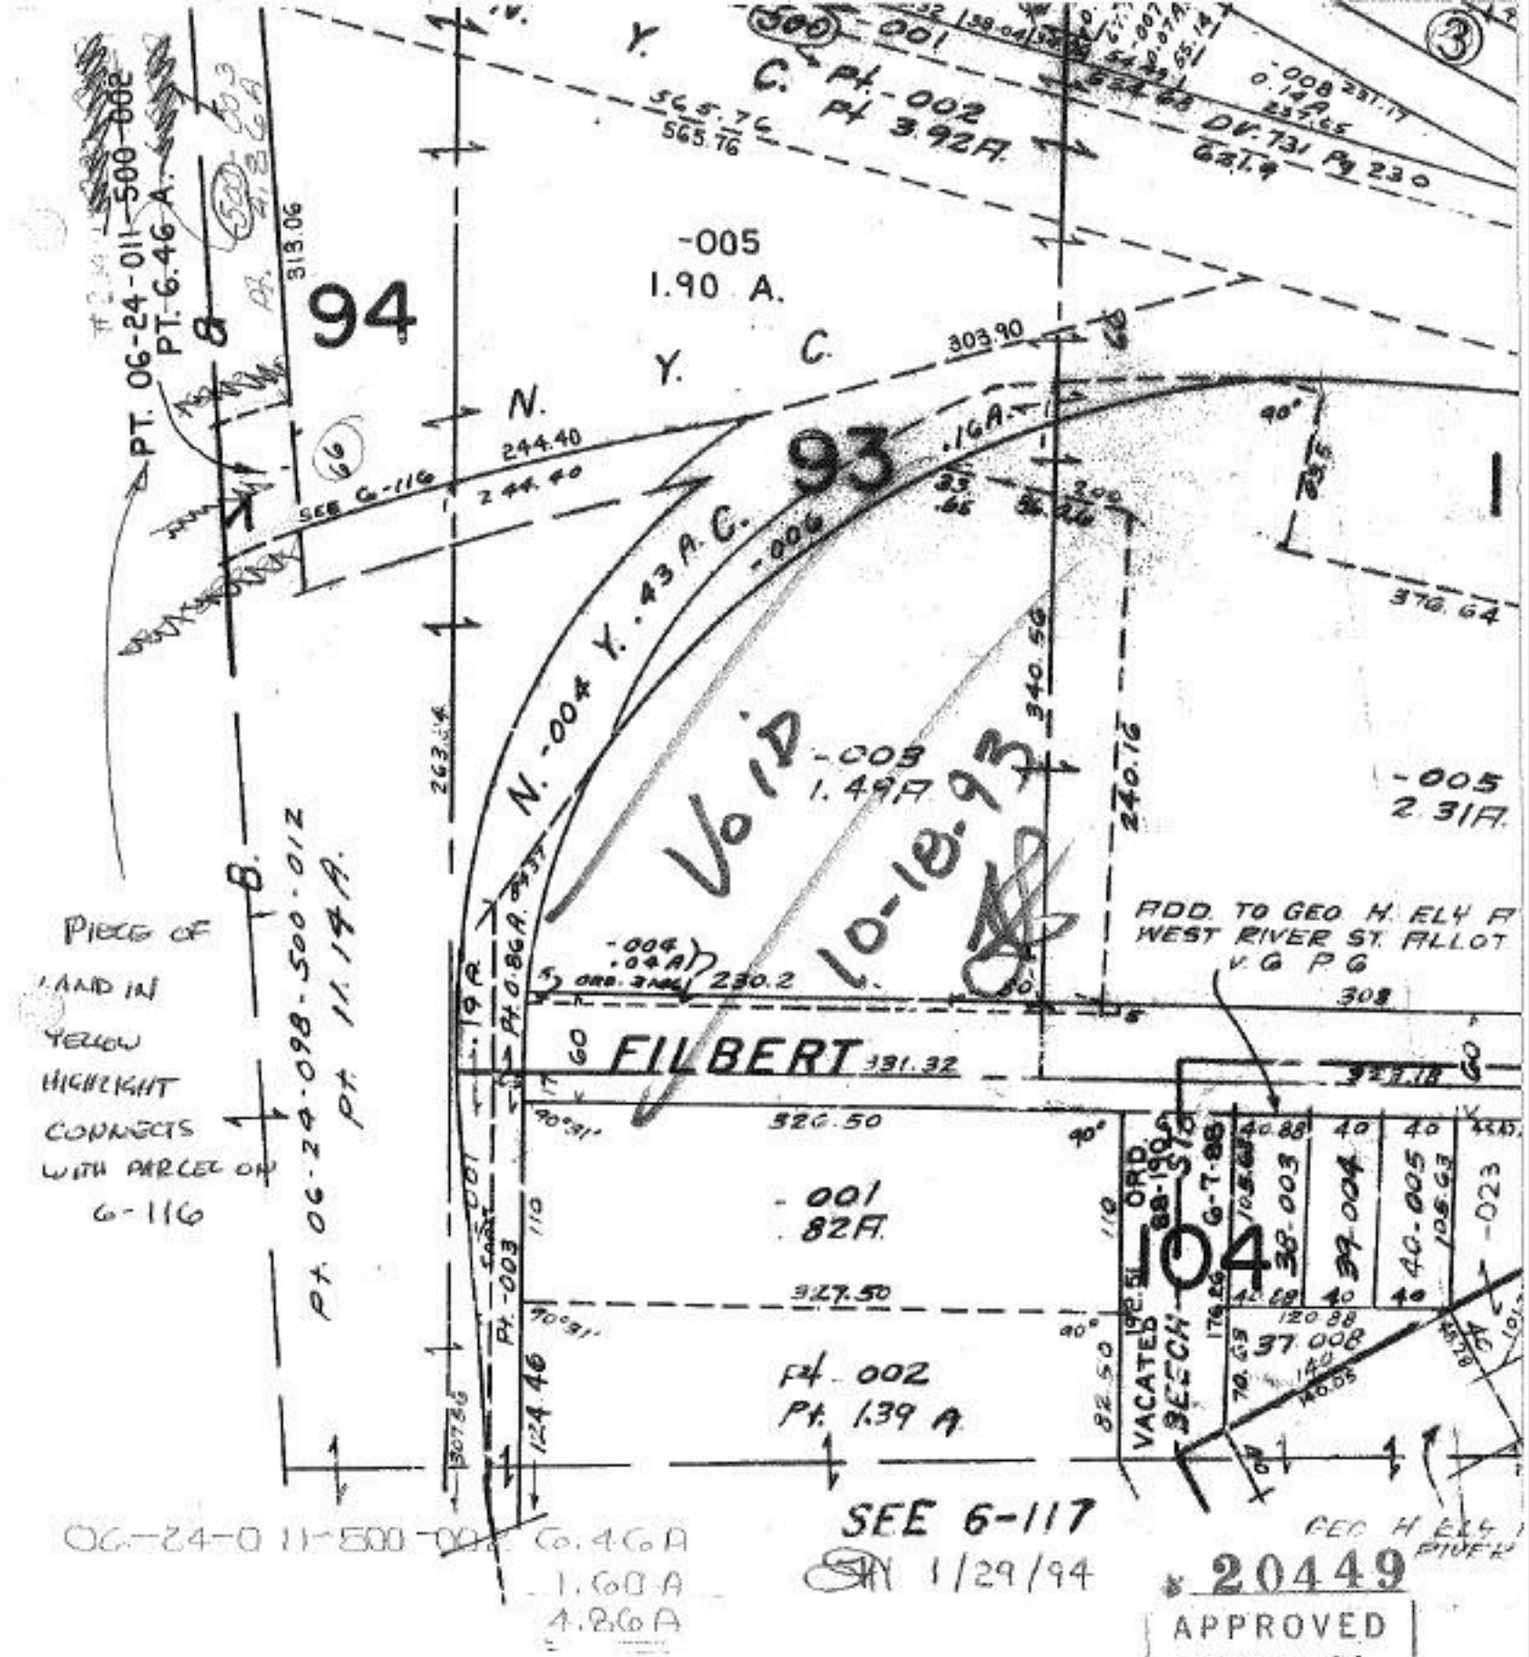

06-24-011-000- 06-24-011-500-
PRIOR INST: 1233/891

20449

APPROVED
LORAIN CO.
MAP DEPT.

DATE	7-19-93
PAGE	6-99
BY	CAROLYN FRANCK
VOID AFTER #	20449

6-99