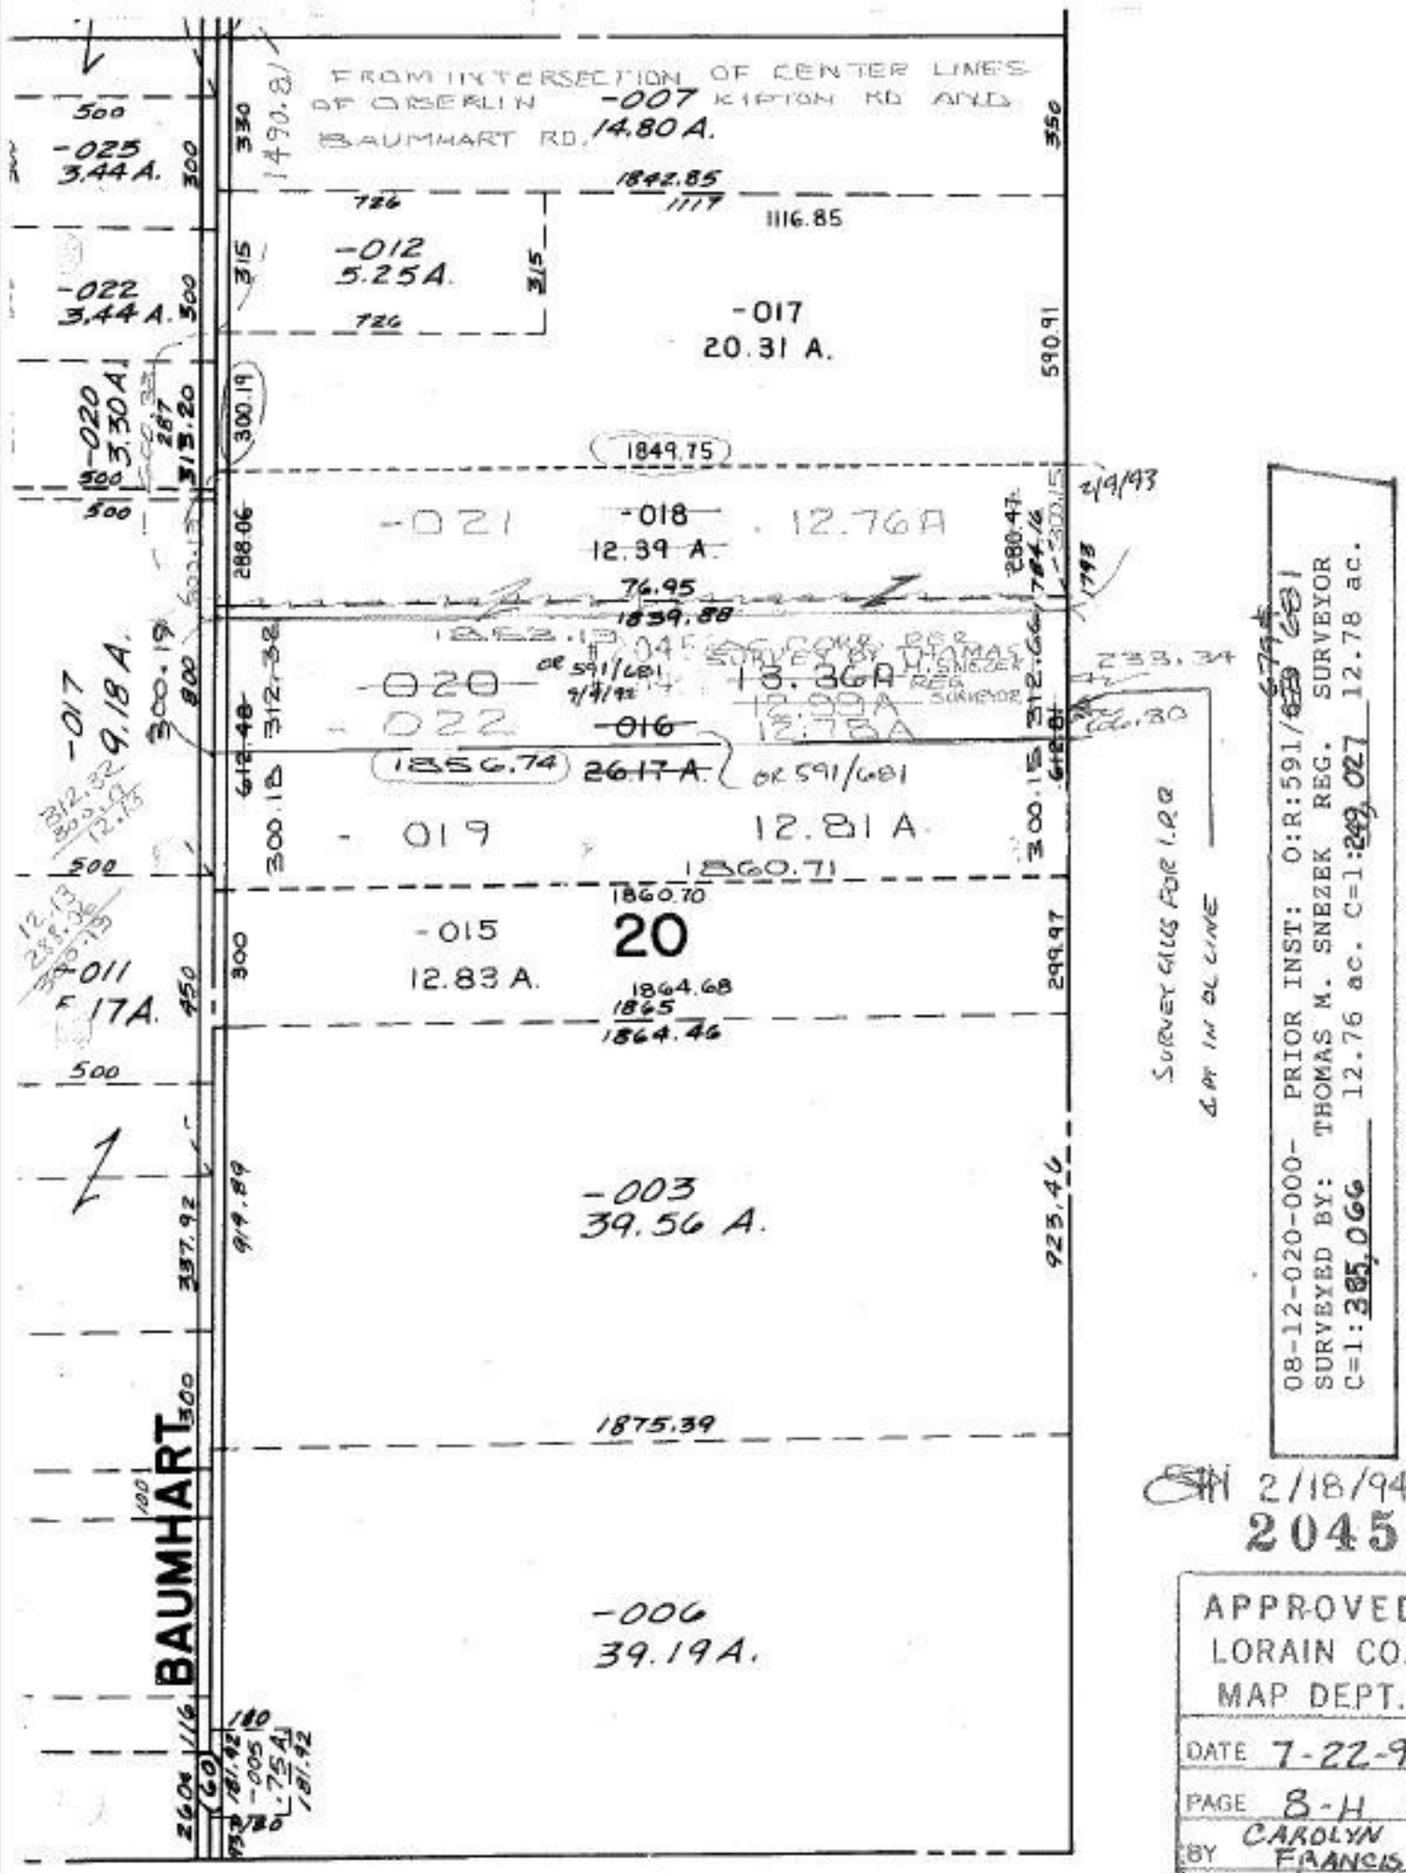
FROM INTERSECTION OF CENTER LINES OF OBERLIN KIPTON RD AND BAUMMART RD.
-007 14.80 A.
-025 3.44 A.
-012 5.25 A.
-022 3.44 A.
-017 20.31 A.
-020 3.30 A.
-021 12.76 A.
-018 12.39 A.
-017 9.18 A.
-022 12.78 A.
-016
-019 12.81 A.
-015 12.83 A.
20
-011 17 A.
-003 39.56 A.
-006 39.19 A.
BAUMHART
1842.85
1116.85
1849.75
1839.88
1856.74
2617 A.
1860.71
1860.70
1864.68
1865
1864.46
1875.39
590.91
280.47
312.66
312.38
300.19
299.97
925.46
OR 591/681
SURVEYED BY THOMAS L. SNEZEK REG. SURVEYOR
Surveyed by Thomas L. Snezek Reg. Surveyor
08-12-020-000-
PRIOR INST: O:R:591/681
SURVEYED BY: THOMAS M. SNEZEK REG. SURVEYOR
C=1: 385,066 12.76 ac. C=1: 249,027 12.78 ac.
2/9/93
2/18/94
20452
APPROVED
LORAIN CO.
MAP DEPT.
DATE 7-22-93
PAGE 8-H
BY CAROLYN FRANCIS
VOID AFTER # 20452