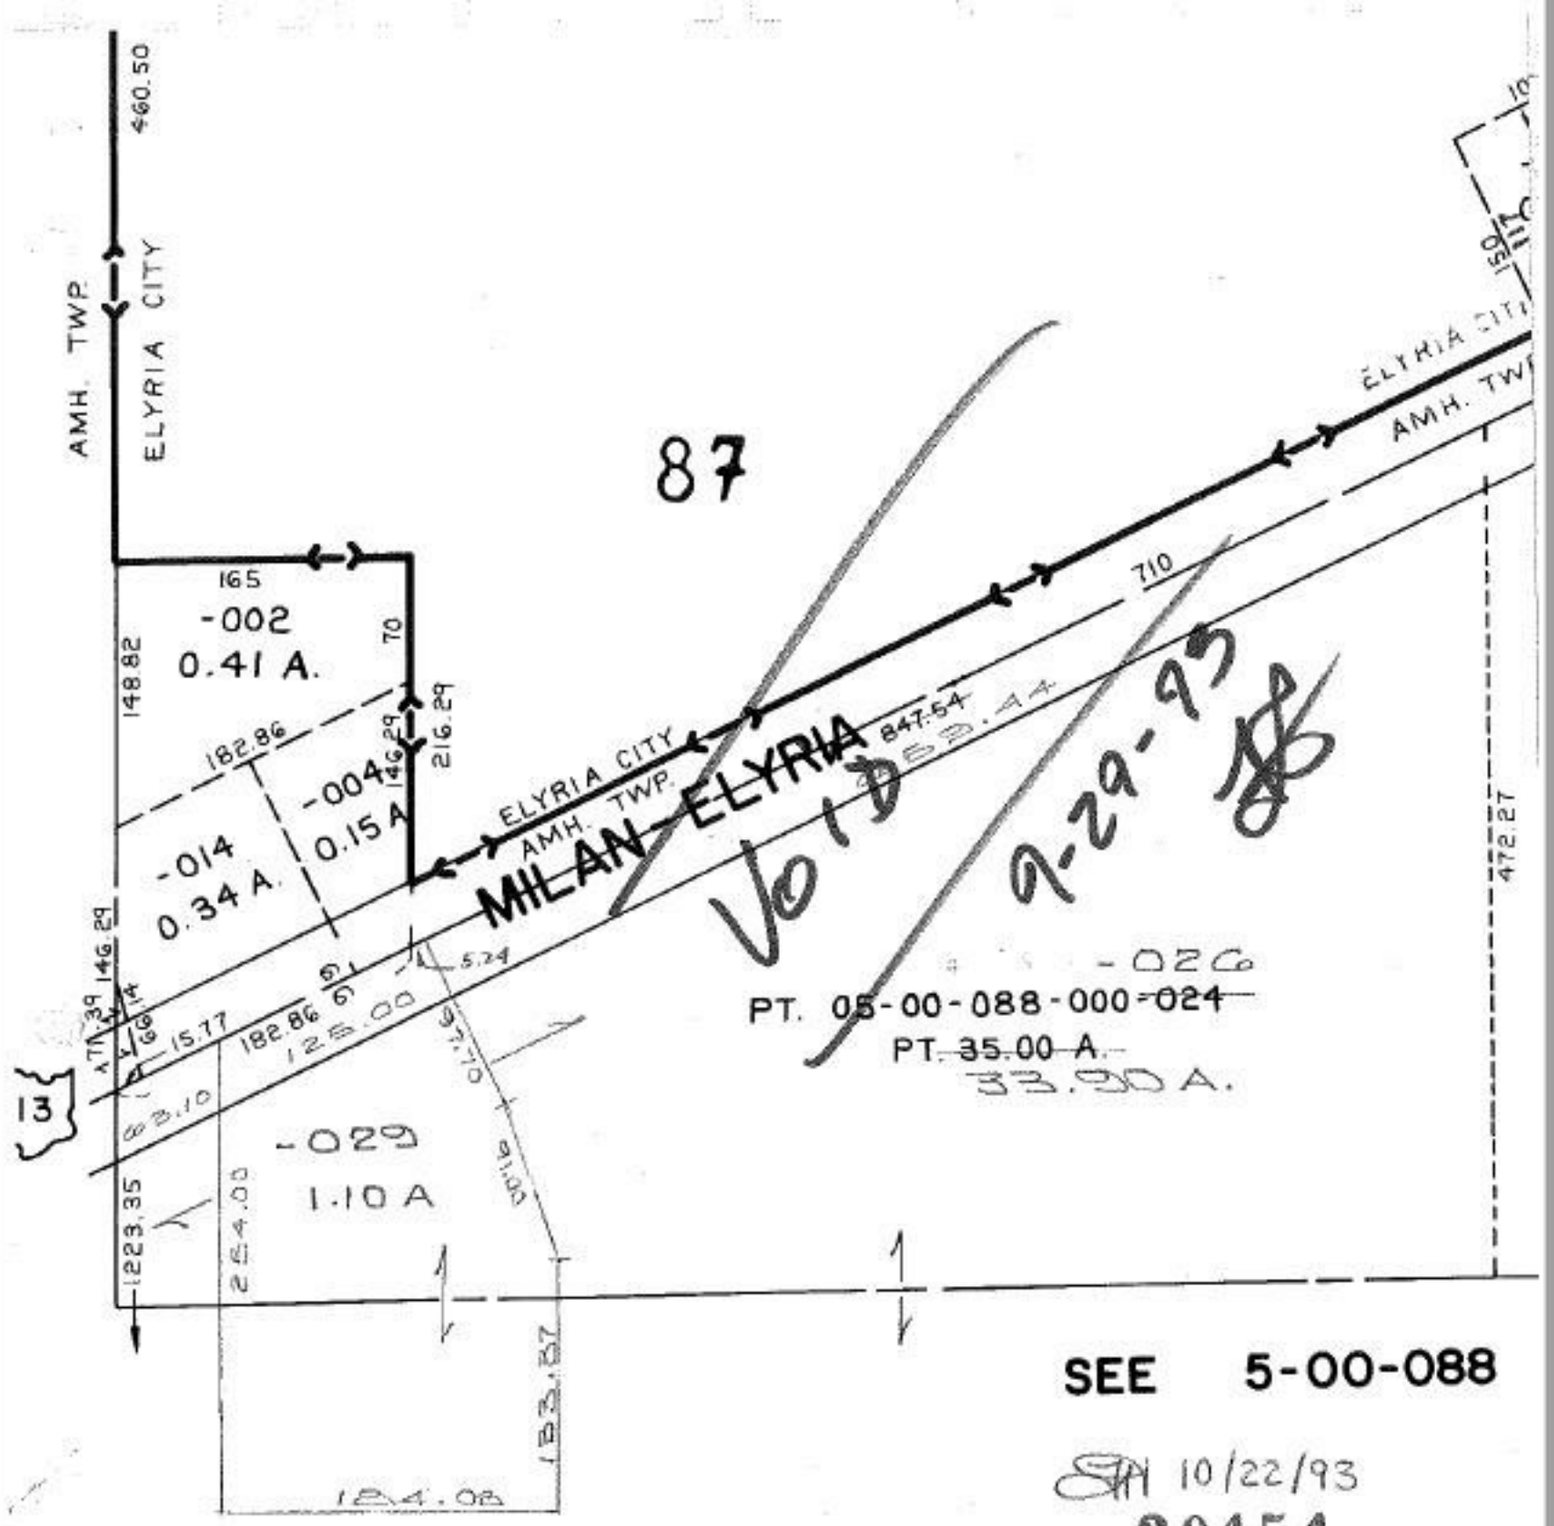

SEE 5-00-088

05-00-087-000- 05-00-088-000-
PRIOR INST: O.R.441/239
SURVEYED BY: JOHN POZWAK REG. SURVEYOR
C=1:127,416

10/22/93

20454

APPROVED
LORAIN CO.
MAP DEPT.
DATE 7-22-93
PAGE 5-00-087
BY CAROLYN FRANCIS
VOID AFTER 11 20454