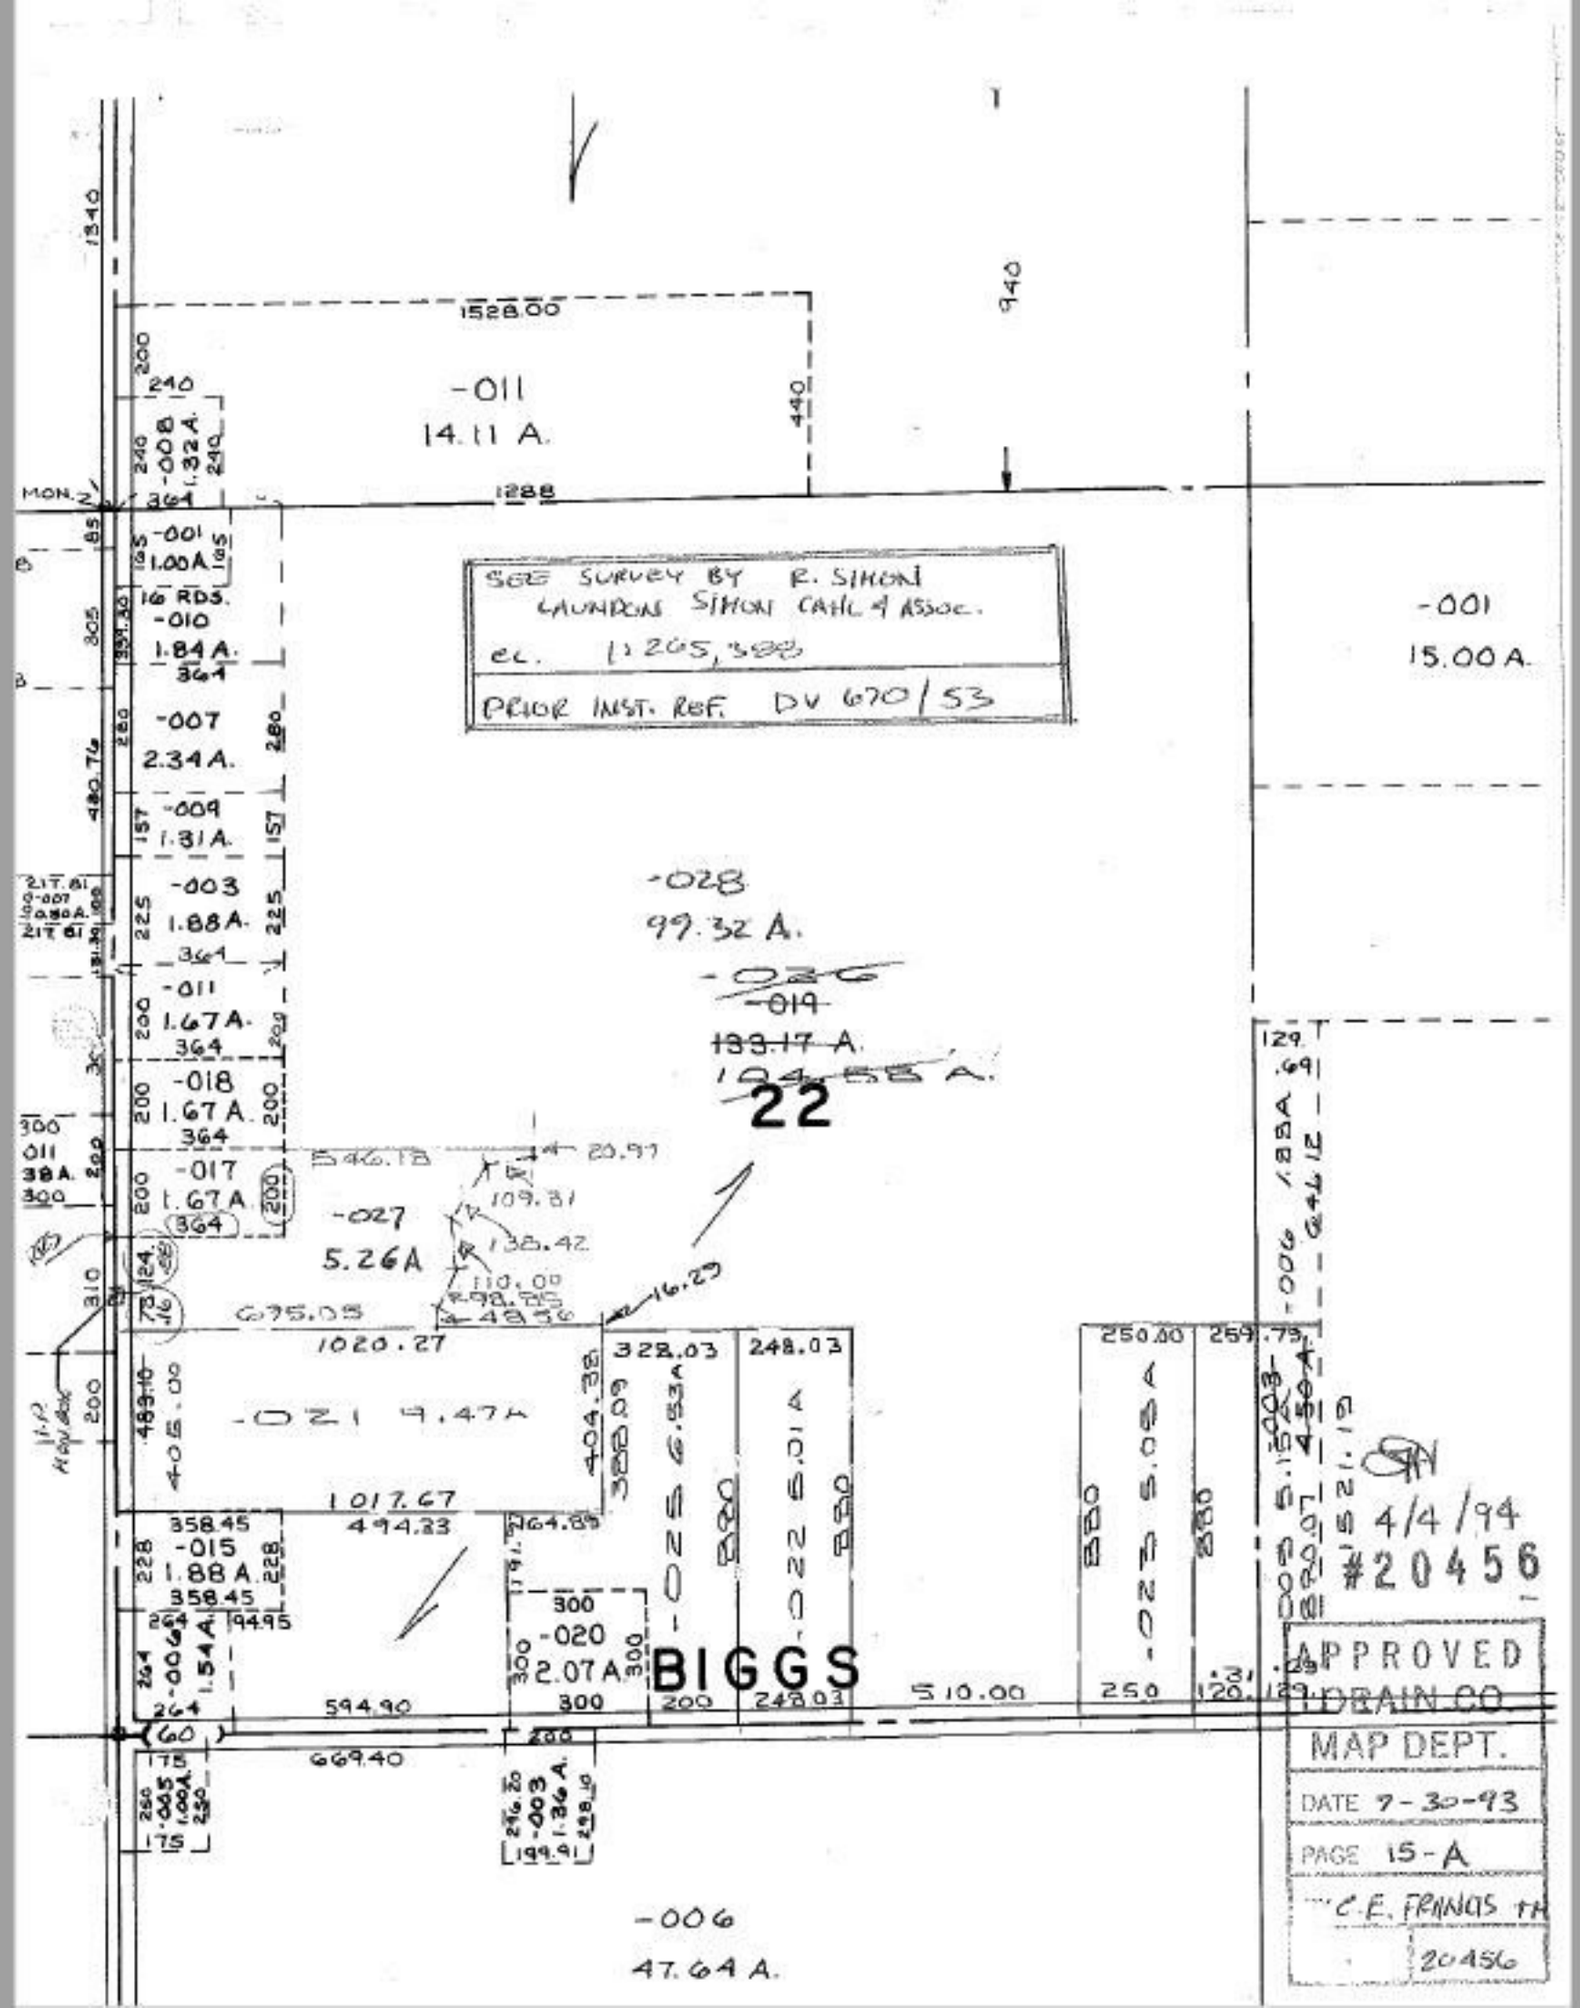

SEE SURVEY BY R. SIMON
LAUNDON SIMON CAHL & ASSOC.
EL. 1:265,388
PRIOR INST. REF. DV 670/53
-011
14.11 A.
-001
15.00 A.
-028
99.32 A.
22
-027
5.26A
-021 9.47A
-015
1.88 A.
-020
2.07 A.
BIGGS
-006
47.64 A.
1528.00
1288
940
440
1340
1020.27
1017.67
494.33
510.00
594.90
669.40
4/4/94
#20456
APPROVED
DRAIN CO.
MAP DEPT.
DATE 7-30-93
PAGE 15-A
C.E. FRANCIS TH
20456