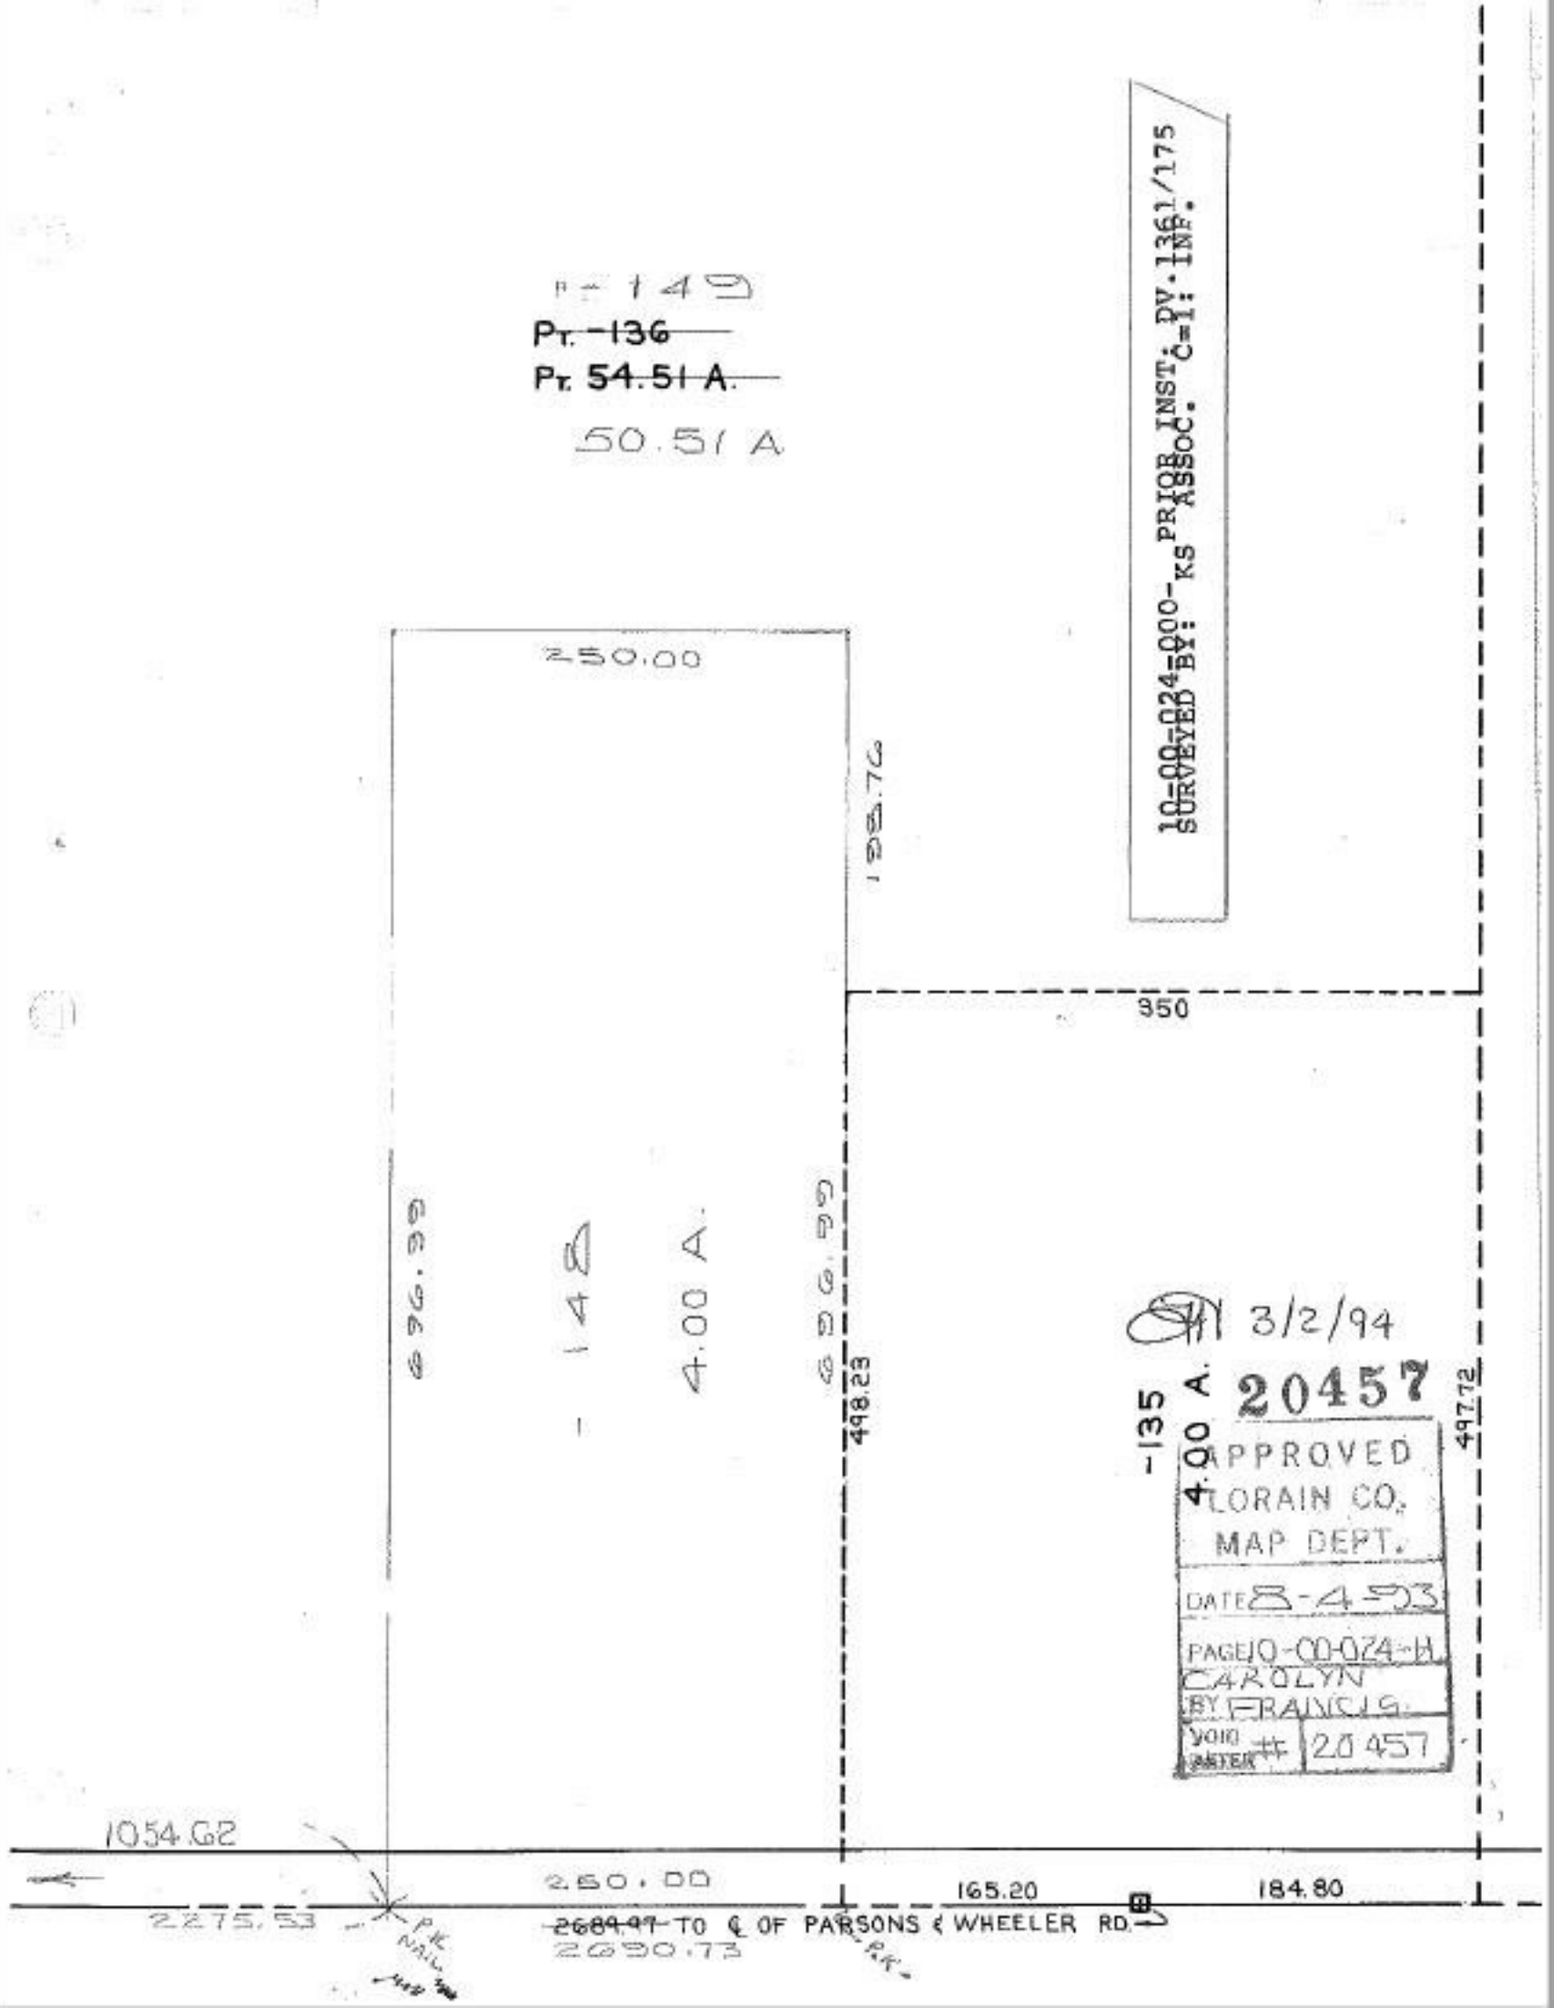
P-149
Pr. -136
Pr. 54.51 A.
50.51 A
10-00-024-000-KS PRIOR INST. PV. 1361/175
SURVEYED BY: KS ASSOC. C=1: INF.
250.00
135.70
350
996.66
-148
4.00 A.
999.99
498.23
3/2/94
20457
-135
4.00 A.
APPROVED
LORAIN CO.
MAP DEPT.
DATE 8-4-93
PAGE 10-00-024-H
CAROLYN
BY FRANCIS
VOID AFTER
20457
497.72
1054.62
250.00
165.20
184.80
2275.53
PK NAIL
2689.97 TO ℄ OF PARSONS & WHEELER RD.
2690.73
P.K.