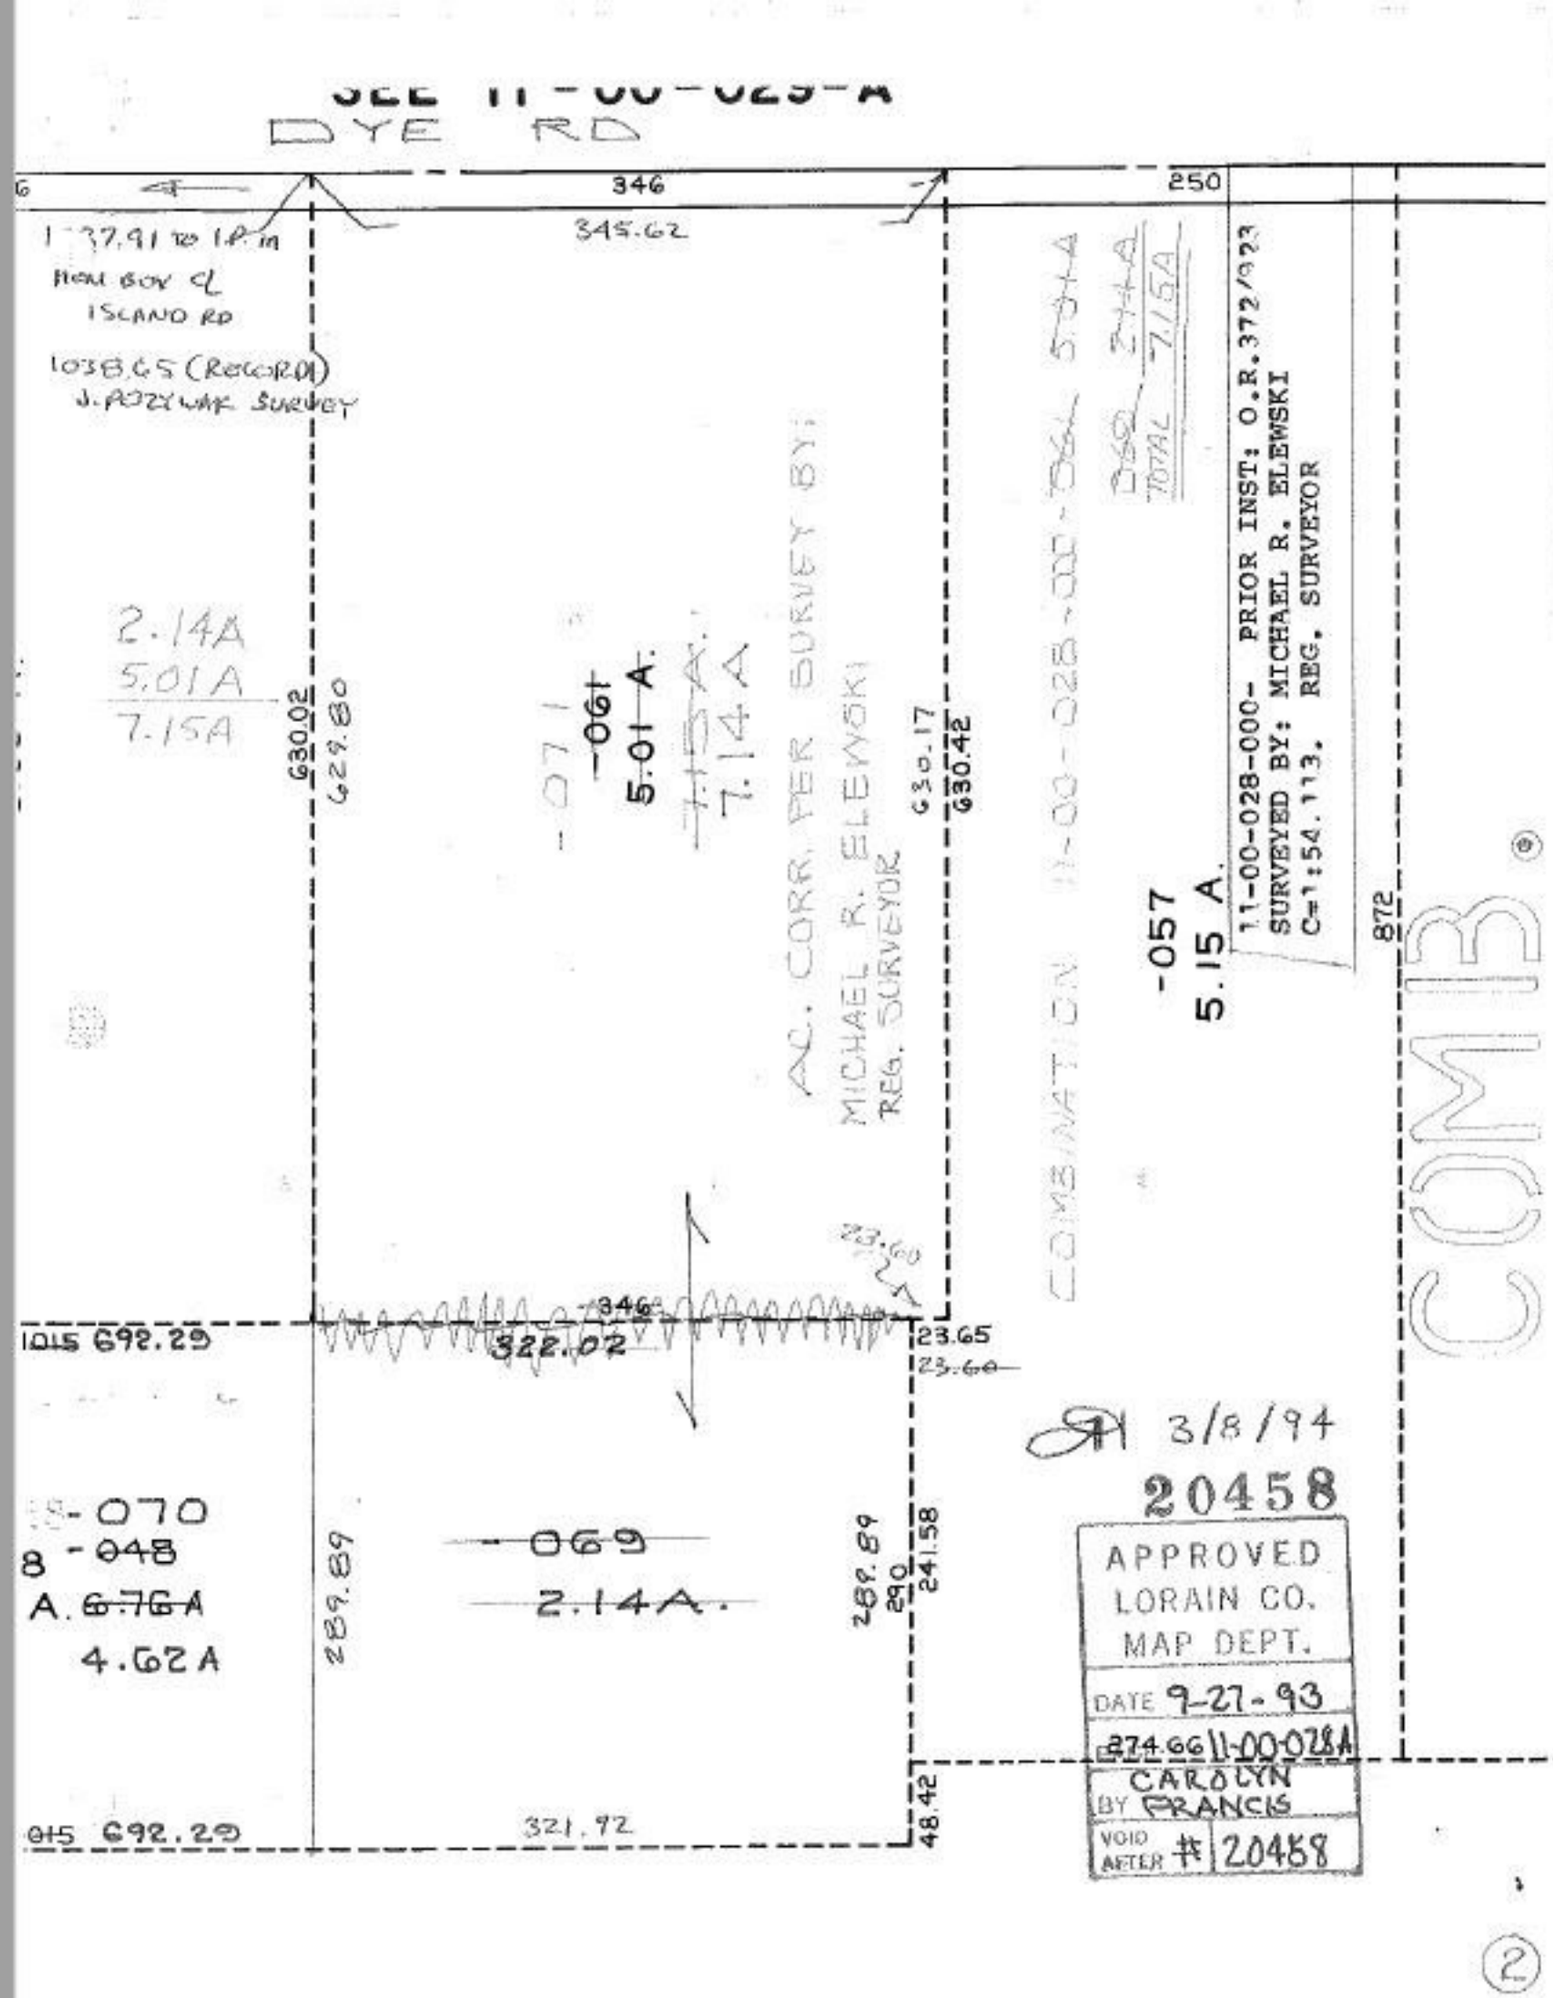

SEE 11-00-029-A
DYE RD
346
250
345.62
1-37.91 TO I.P. in
HOM BOX ℄
ISLAND RD
1038.65 (RECORD)
J. POZYWAK SURVEY
2.14A
5.01A
7.15A
630.02
629.80
-071
-061
5.01 A.
7.15A
7.14A
AC. CORR. PER SURVEY BY:
MICHAEL R. ELEWSKI
REG. SURVEYOR
630.17
630.42
COMBINATION 11-00-028-000-061 5.01A
060 2.14A
TOTAL 7.15A
-057
5.15 A.
11-00-028-000- PRIOR INST: O.R.372/923
SURVEYED BY: MICHAEL R. ELEWSKI
C=1:54.113. REG. SURVEYOR
872
COMB
23.60
346
1015 692.29
322.02
23.65
23.60
3/8/94
20458
-070
8 -048
A. 6.76A
4.62A
289.89
-069
2.14A.
289.89
290
241.58
APPROVED
LORAIN CO.
MAP DEPT.
DATE 9-27-93
274.66 11-00-028A
CAROLYN
BY FRANCIS
VOID AFTER # 20458
48.42
015 692.29
321.92