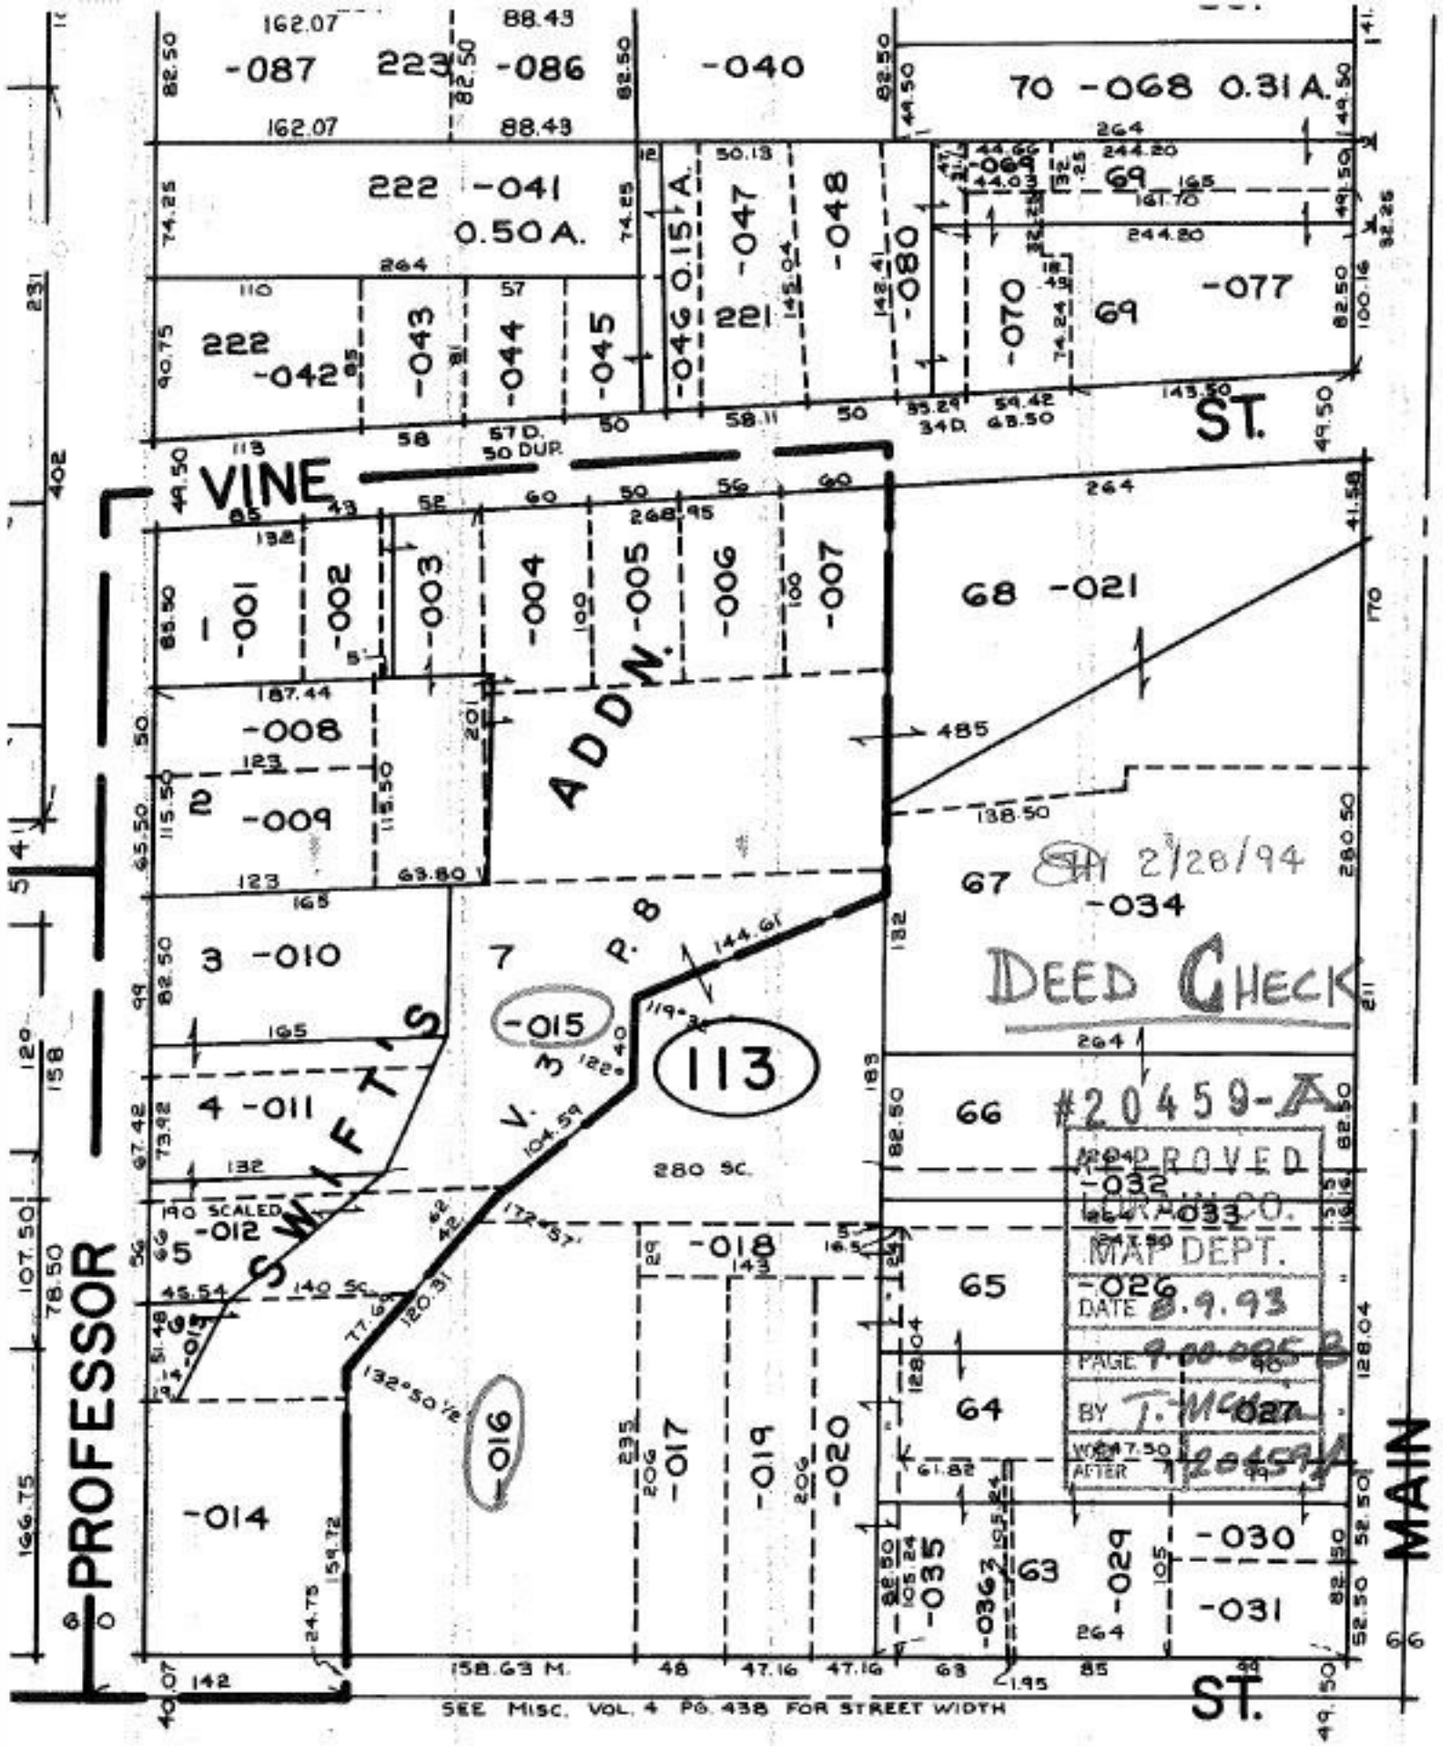

05-095-B

Ref. - DV 117/403, 404, 405
DV 125/223, 224
DV 188/146, 147

* DESCRIPTION UNFINDABLE ON MAP
NEEDS NEW LEGAL!