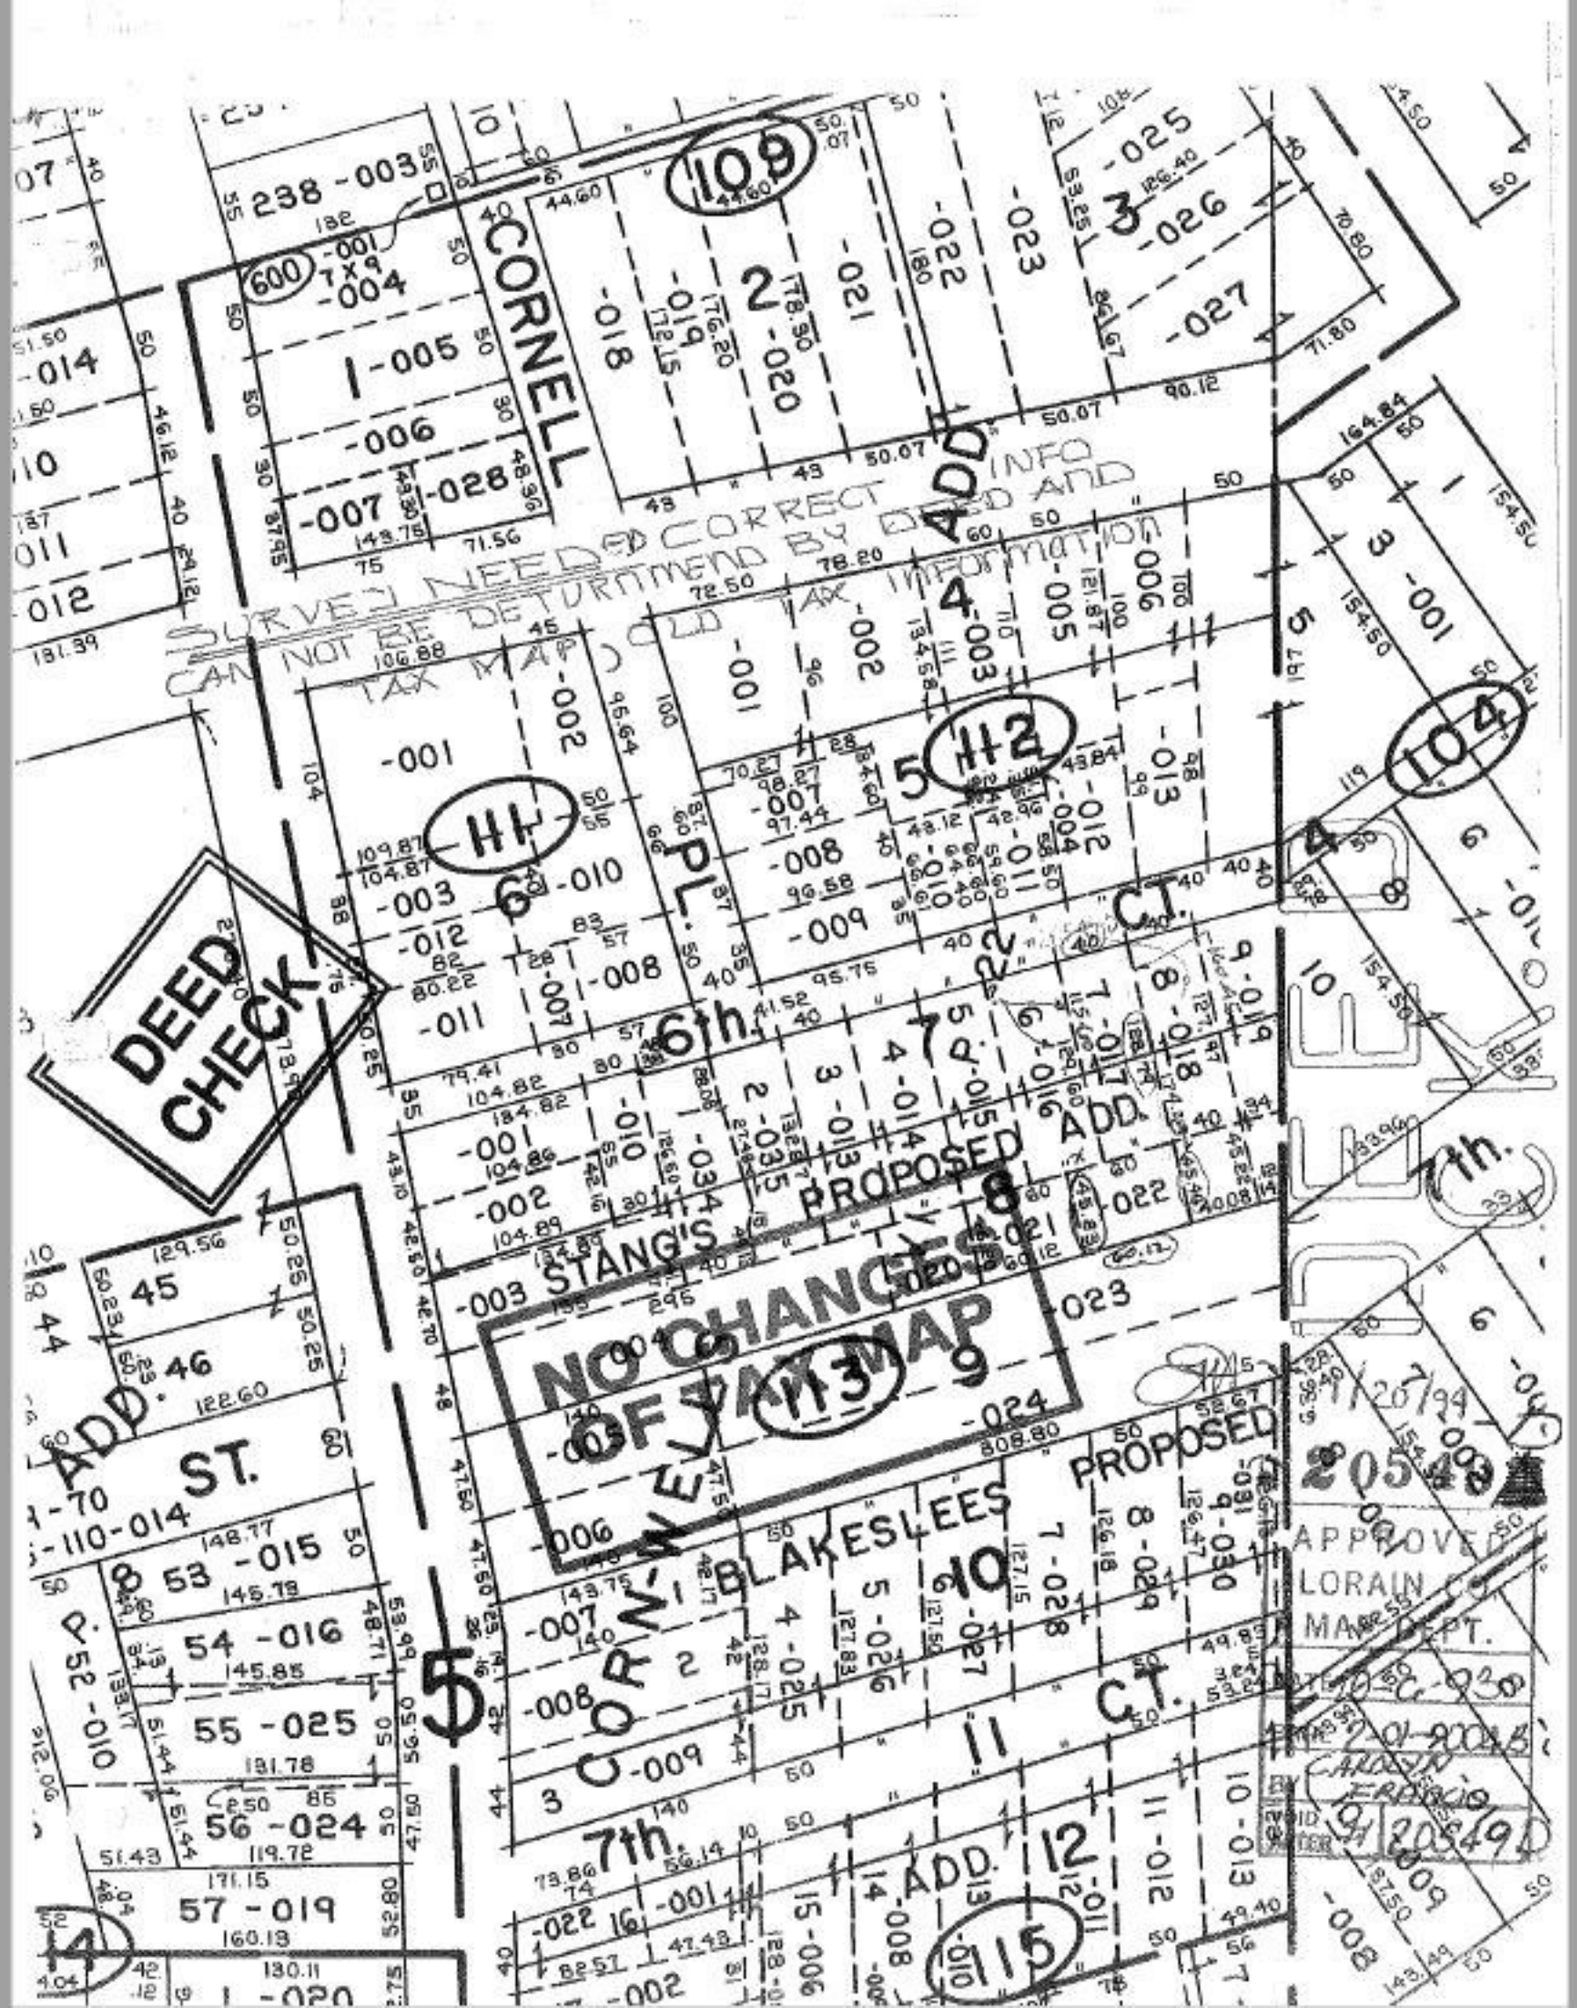
CORNELL
238 -003
600
-001
-004
1-005
-006
-007
-028
-014
-012
-018
-019
2
-020
-021
-022
-023
3
-025
-026
-027
109
ADD.
SURVEY NEEDED CORRECT INFO
CAN NOT BE DETURMIND BY DEED AND
TAX MAP OLD TAX INFORMATION
-001
-002
4
-003
-004
-005
-006
5
112
-007
-008
-009
-010
-011
-012
-013
6
111
6th.
PL.
CT.
104
DEED CHECK
45
46
ST.
53 -015
54 -016
55 -025
56 -024
57 -019
52 -010
P.
NO CHANGES OF TAX MAP
113
BLAKESLEES
PROPOSED
ADD.
7
8
9
10
11
12
115
7th.
APPROVED
LORAIN CO.
MAP DEPT.
9/20/94
20549
20649