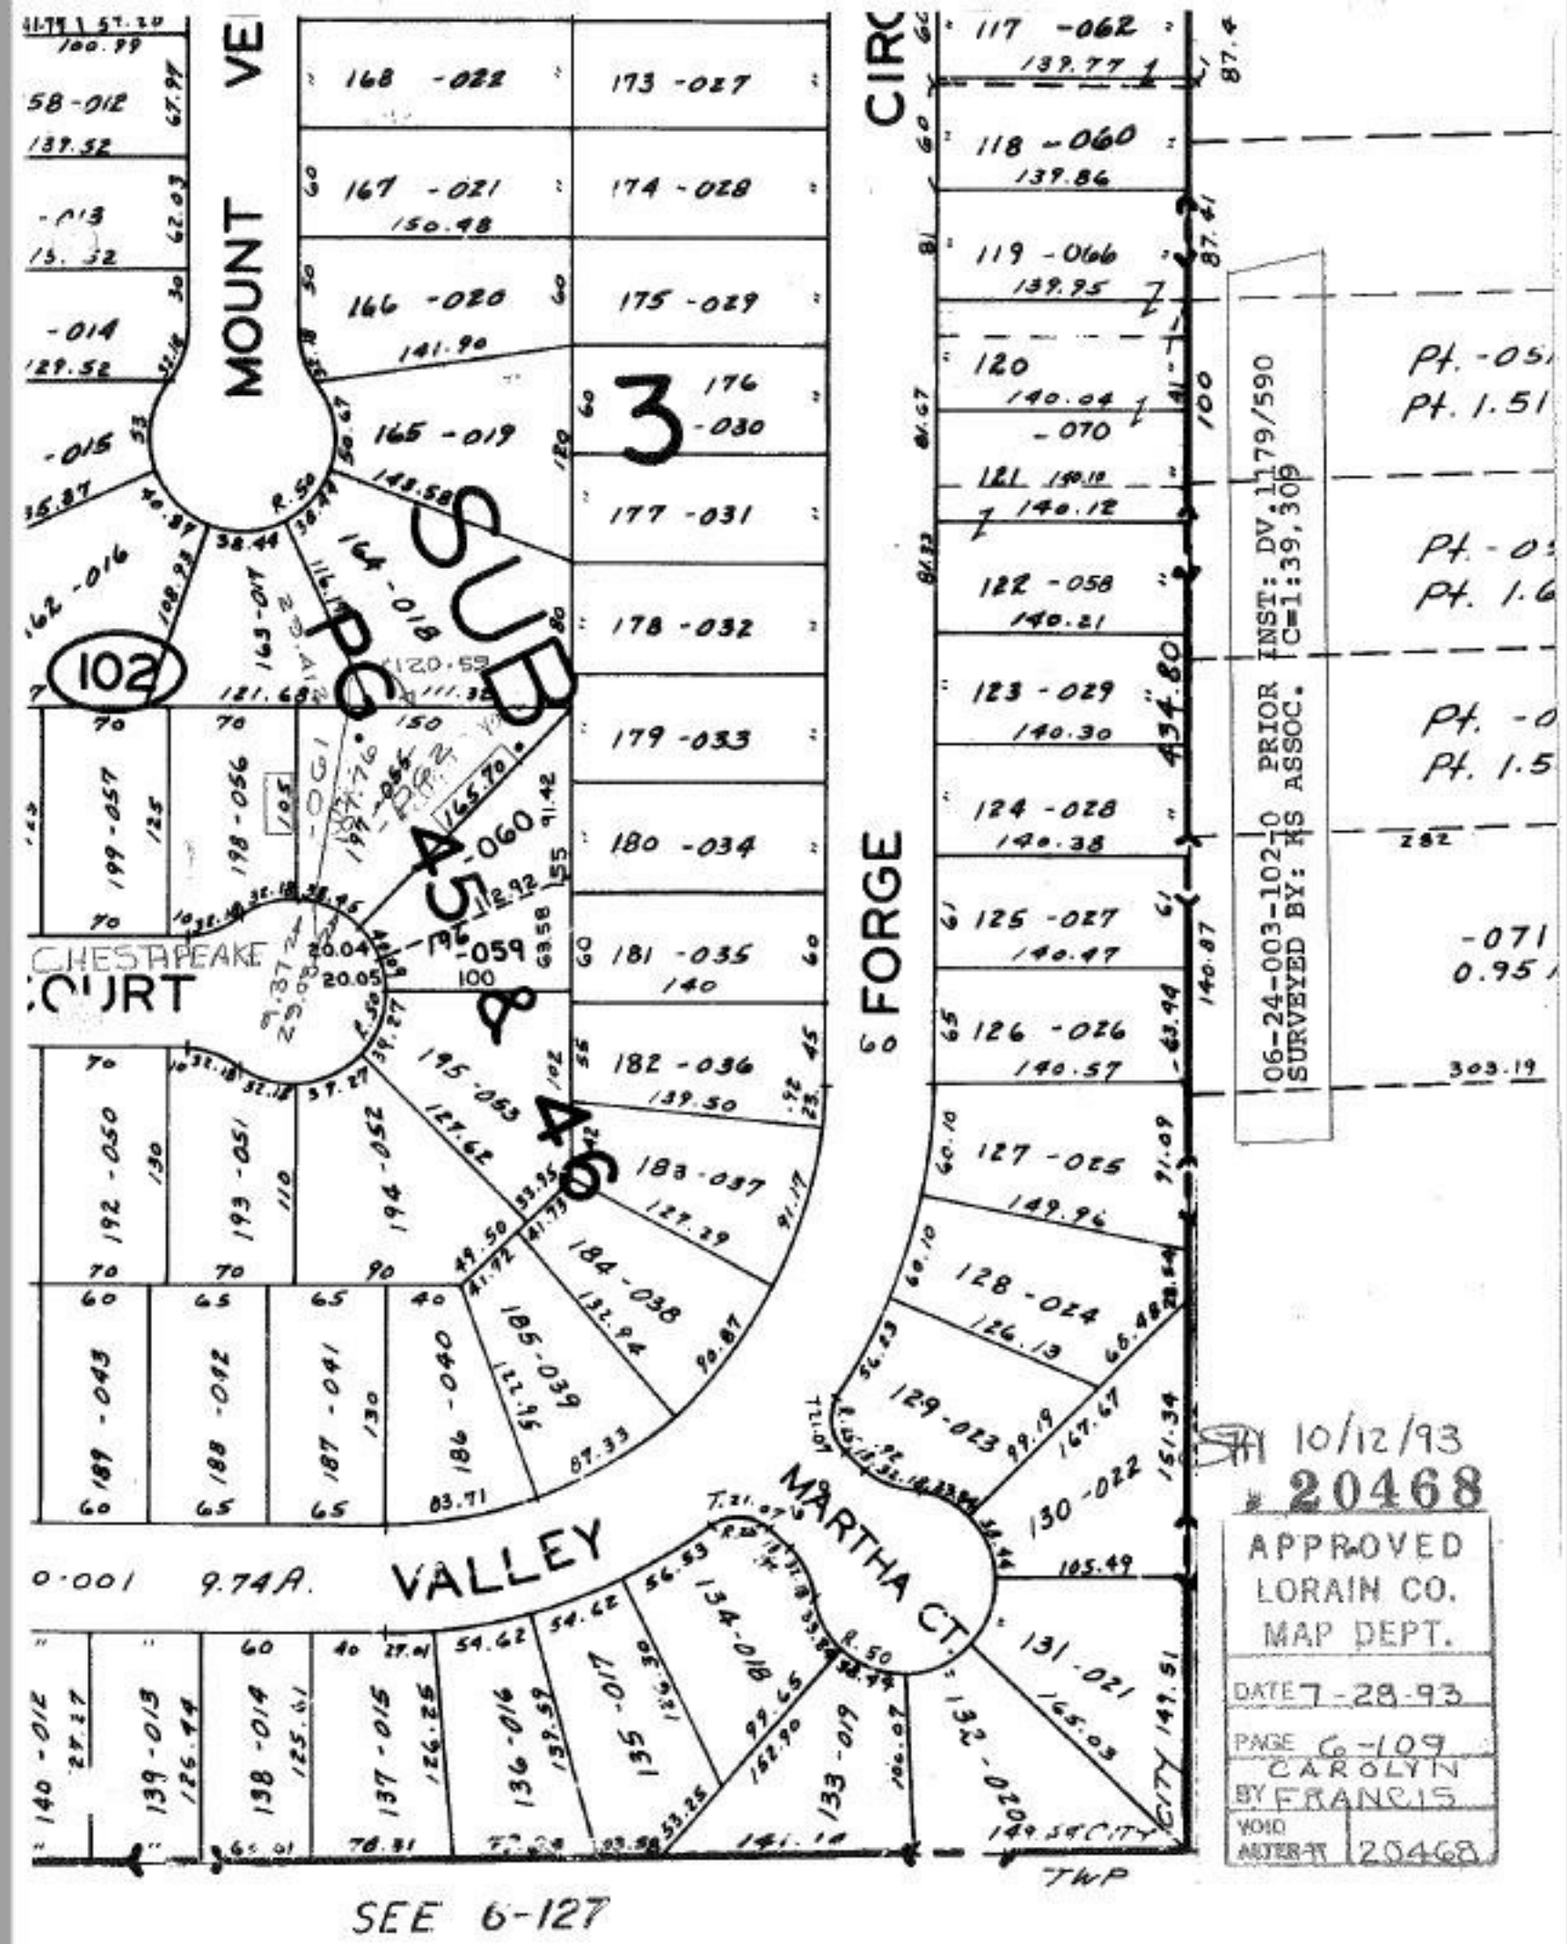
MOUNT VE
CIRC
FORGE
SUB
PG. 45 & 46
3
102
CHESTAPEAKE
COURT
VALLEY
MARTHA CT.
CITY
TWP
SEE 6-127
06-24-003-102-0 PRIOR INST: DV.1179/590
SURVEYED BY: HS ASSOC. C=1:39,309
10/12/93
20468
APPROVED
LORAIN CO.
MAP DEPT.
DATE 7-28-93
PAGE 6-109
BY CAROLYN FRANCIS
VOID
ALTER-PT 20468