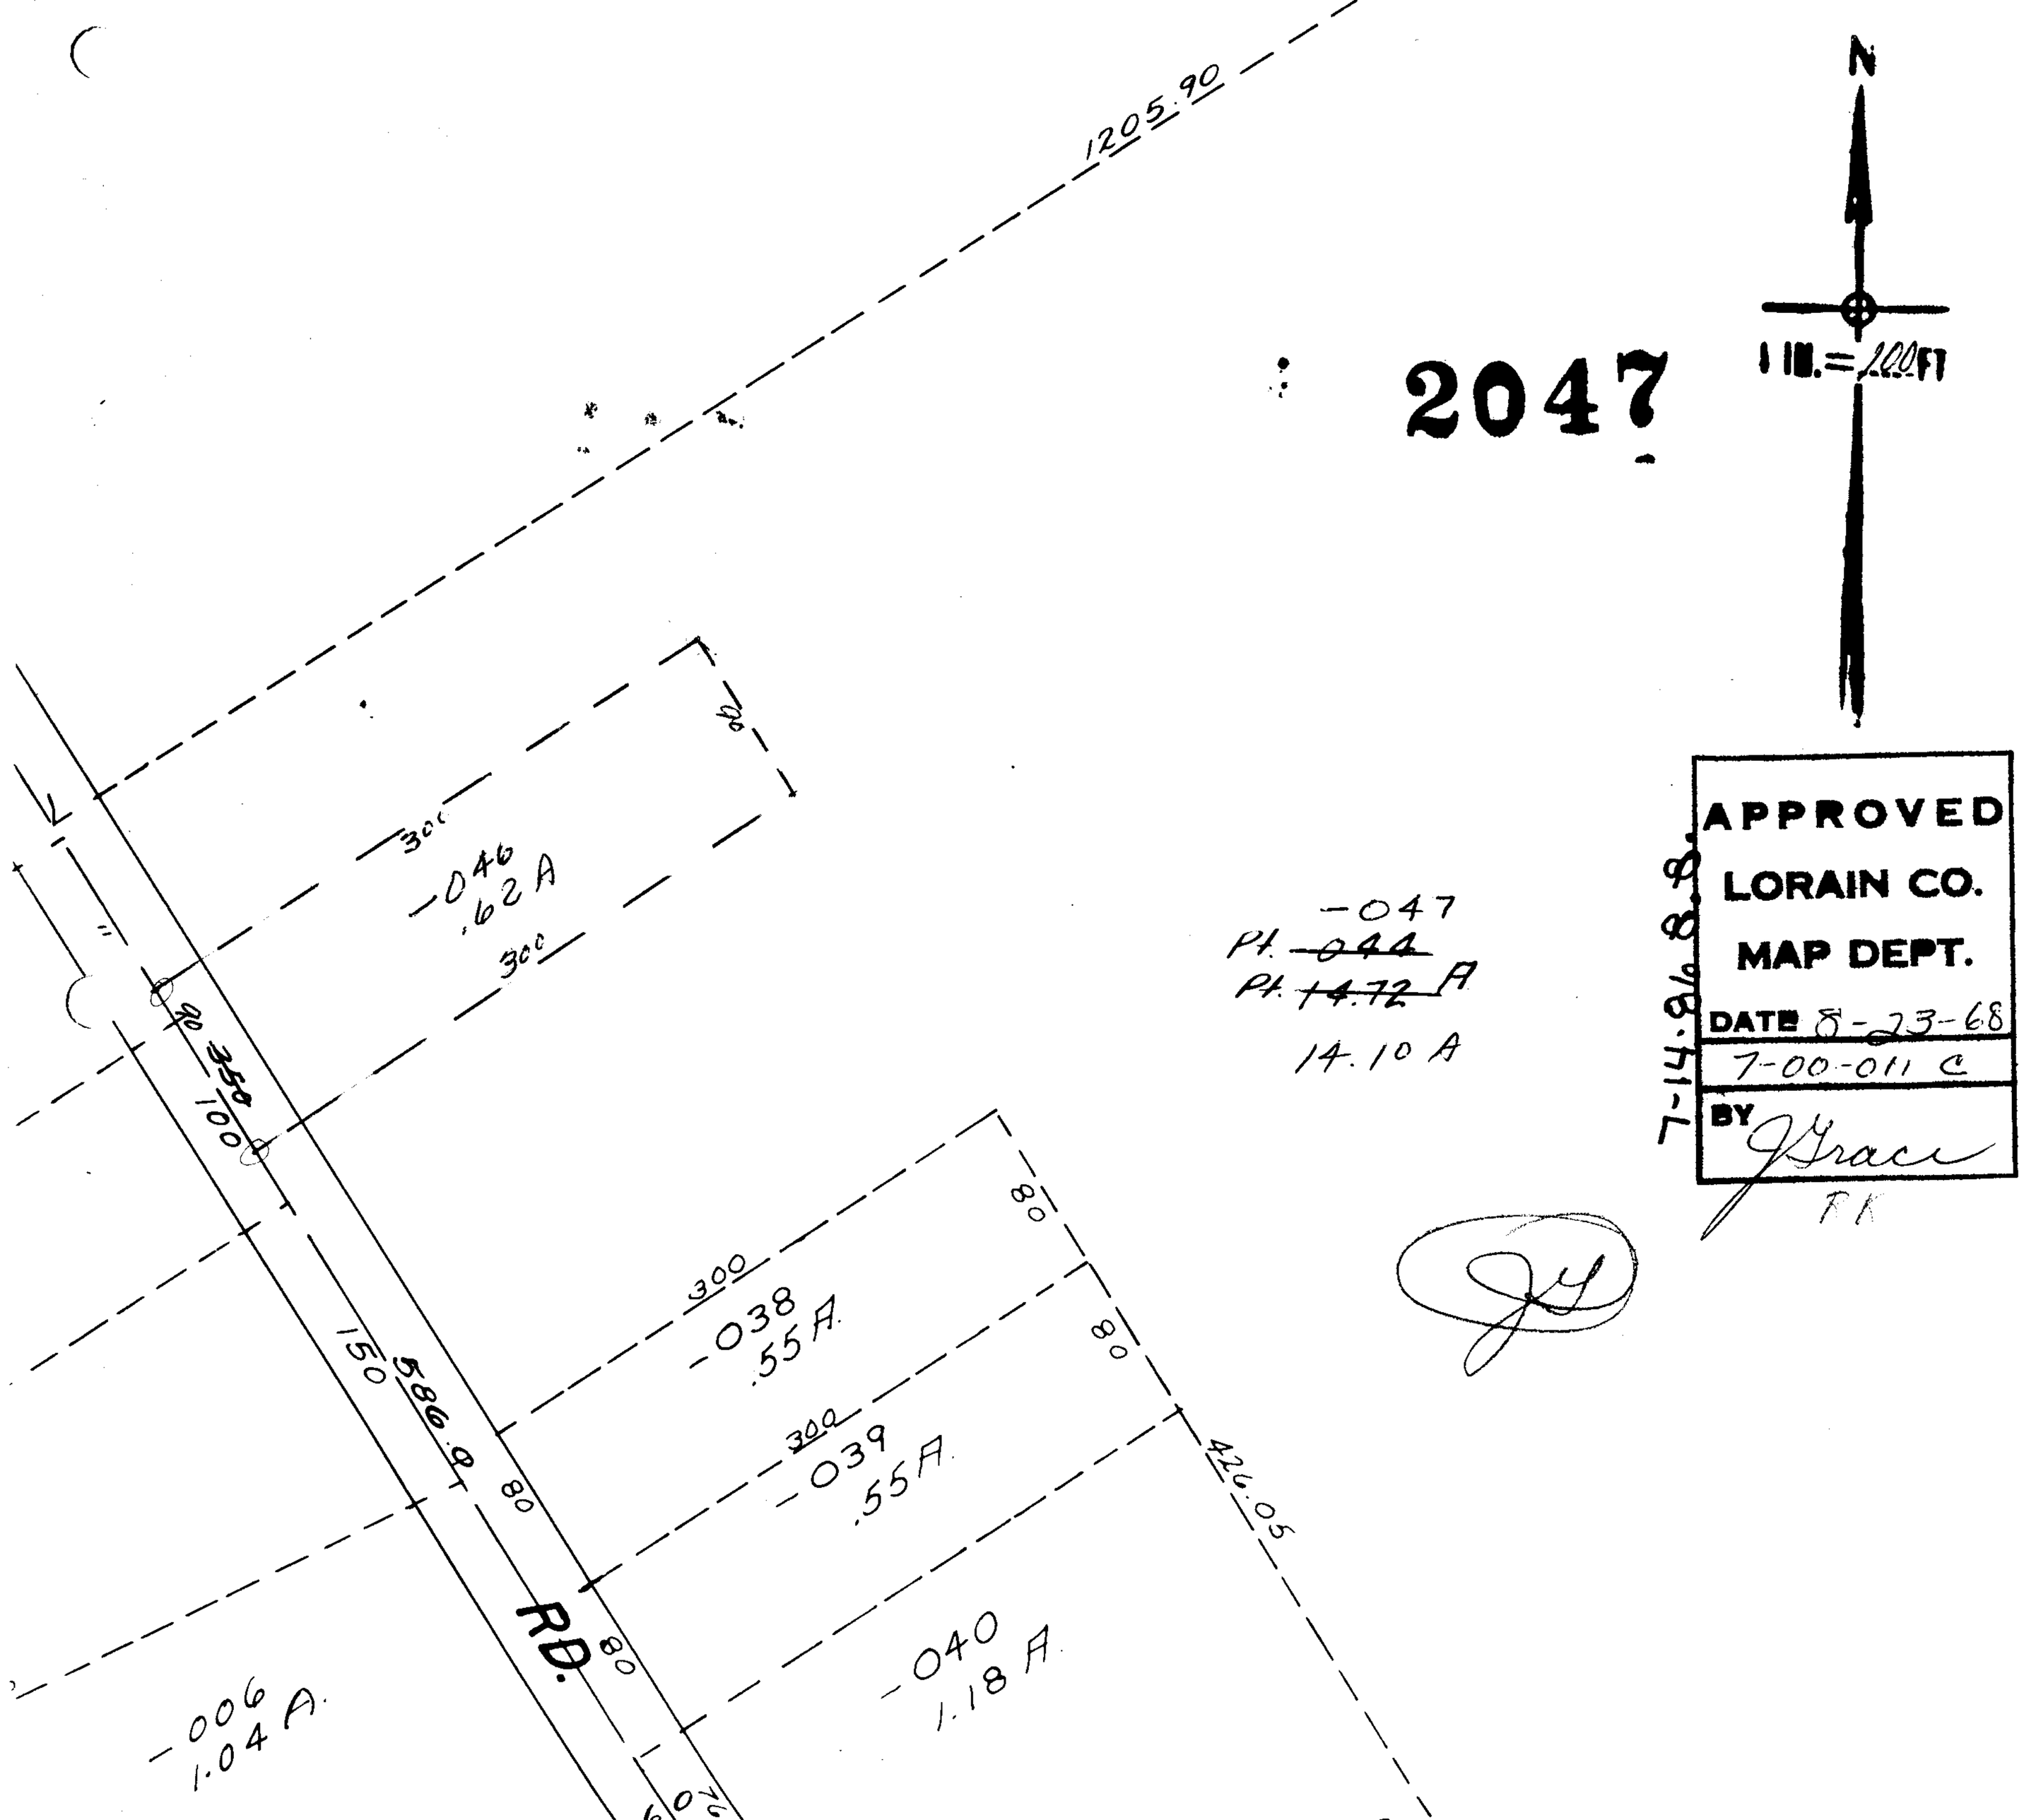

1205.90
N
1 IN. = 100 FT
2047
-046
.62 A
300
300
90
350
100
150
586.9
80
80
80
80
300
-038
.55 A
300
-039
.55 A
-040
1.18 A
426.05
-006
1.04 A
RD.
-047
Pt. ~~044~~
Pt. ~~14.72~~ A
14.10 A
APPROVED
LORAIN CO.
MAP DEPT.
DATE 8-23-68
7-00-011 C
BY J Grace
RK
7-14-86 8.8.