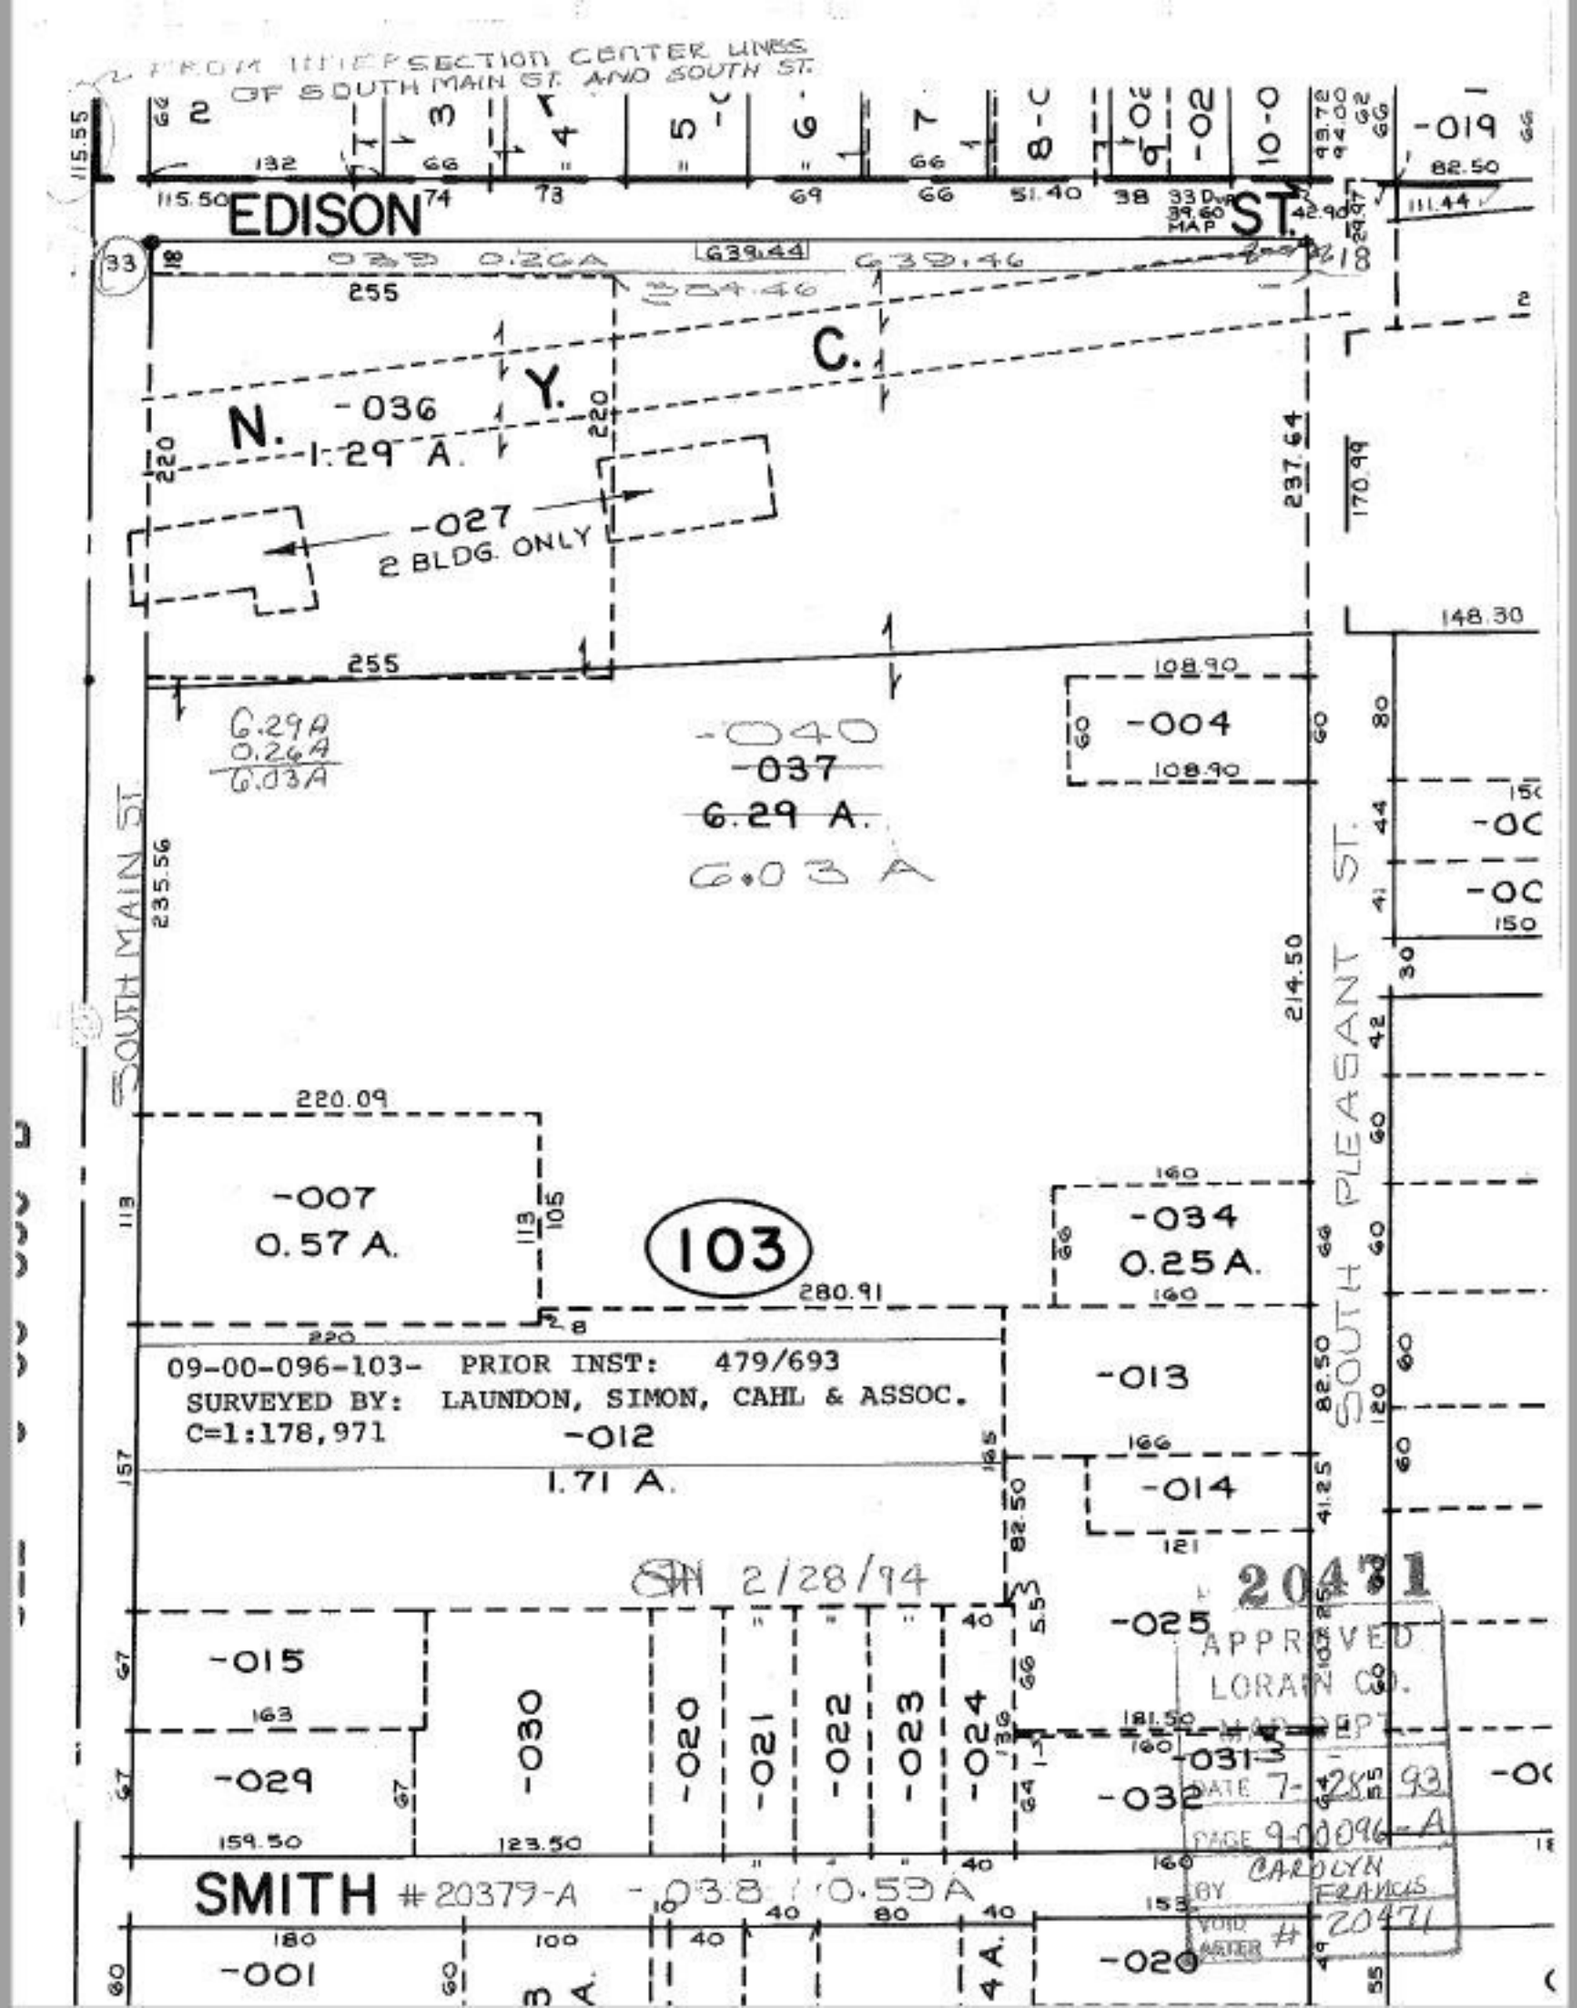

FROM INTERSECTION CENTER LINES OF SOUTH MAIN ST. AND SOUTH ST.
EDISON ST.
N. Y. C.
-036
1.29 A.
-027
2 BLDG. ONLY
6.29A
0.26A
6.03A
-040
-037
6.29 A.
6.03 A
-004
-007
0.57 A.
103
-034
0.25 A.
-013
-012
1.71 A.
-014
-015
-029
-030
-020
-021
-022
-023
-024
-025
-031
-032
-001
-020
SOUTH MAIN ST.
SOUTH PLEASANT ST.
09-00-096-103- PRIOR INST: 479/693
SURVEYED BY: LAUNDON, SIMON, CAHL & ASSOC.
C=1:178,971
SH 2/28/94
20471
APPROVED
LORAIN CO.
MAP DEPT
DATE 7-28-93
PAGE 9-00096-A
BY CAROLYN FRANCIS
VOID AFTER # 20471
SMITH #20379-A -038 / 0.59A